

# CONTRACT PLANS

BRIDGE 405/17.7

RENTON AVE OVER NB I-405

I-405 MP 0.00 TO MP 14.60

I-405; RENTON TO BELLEVUE WIDENING  
AND EXPRESS TOLL LANES PROJECT

VOLUME 15  
FINAL DESIGN REVIEW

KING COUNTY

No. _____	Date _____
<b>CHECK PRINT</b>	
Dwg. Only: Checked against calcs. and specs.	
Confirmed by _____	Date _____
Originator <u>PTWL</u>	Date <u>12/21/2021</u>
Checker <u>MWBM</u>	Date <u>12/21/2021</u>
Backchecker _____	Date _____
Updater _____	Date _____
Rechecker _____	Date _____



Washington State  
Department of Transportation

12/22/2021

# VOLUME 15

REV NO.	INCLUDED	REV. DATE	SUB. NO.	PLAN REF NO.		SHEET TITLE	SHEET DESCRIPTION
0		6/09/21	1387	BG11	1	I-405 OVER SR181/INTERURBAN AVE	BRIDGE LAYOUT
0		6/09/21	1387	BG11	2	I-405 OVER SR181/INTERURBAN AVE	BRIDGE GENERAL NOTES
0		6/09/21	1387	BG11	3	I-405 OVER SR181/INTERURBAN AVE	PIER 1 RETROFIT
0		6/09/21	1387	BG11	4	I-405 OVER SR181/INTERURBAN AVE	PIER 5 RETROFIT
0		6/09/21	1387	BG11	5	I-405 OVER SR181/INTERURBAN AVE	PIER 2 RETROFIT
0		6/09/21	1387	BG11	6	I-405 OVER SR181/INTERURBAN AVE	PIER 3 RETROFIT
0		6/09/21	1387	BG11	7	I-405 OVER SR181/INTERURBAN AVE	PIER 4 RETROFIT
0		6/09/21	1387	BG11	8	I-405 OVER SR181/INTERURBAN AVE	PIER COLUMN RETROFIT
0	X	12/08/21	1280	BR	1	I-405 OVER SR167	PLAN AND ELEVATION
0	X	12/08/21	1280	BR	2	I-405 OVER SR167	GENERAL NOTES
0	X	12/08/21	1280	BR	02A	I-405 OVER SR167	GIRDER STOP LAYOUT
0	X	12/08/21	1280	BR	3	I-405 OVER SR167	BENT 1 PLAN AND ELEVATION
0	X	12/08/21	1280	BR	4	I-405 OVER SR167	BENT 1 DETAILS
0	X	12/08/21	1280	BR	5	I-405 OVER SR167	BENTS 2 - 4 PLAN AND ELEVATION
0	X	12/08/21	1280	BR	6	I-405 OVER SR167	BENTS 2-4 RETROFIT DETAILS
0	X	12/08/21	1280	BR	7	I-405 OVER SR167	BENT 5 PLAN AND ELEVATION
0	X	12/08/21	1280	BR	8	I-405 OVER SR167	BENT 5 DETAILS
0	X	12/08/21	1280	BR	9	I-405 OVER SR167	RETROFIT DETAILS
0		44473	1004	BG5	1	BRIDGE 5 61 ST AVE S OVER I-405	BRIDGE PLAN AND ELEVATION
0		44473	1004	BG5	2	BRIDGE 5 61 ST AVE S OVER I-405	PIER 1 & 3 ABUTMENT GIRDER STOP
0		44473	1004	BG5	3	BRIDGE 5 61 ST AVE S OVER I-405	PIER 1 & 3 ABUTMENT GIRDER STOP DETAILS -1
0		44473	1004	BG5	4	BRIDGE 5 61 ST AVE S OVER I-405	PIER 1 & 3 ABUTMENT GIRDER STOP DETAILS -2
0		44473	1004	BG5	5	BRIDGE 5 61 ST AVE S OVER I-405	PIER 2 CAPBEAM BOLSTER
0		44473	1004	BG5	6	BRIDGE 5 61 ST AVE S OVER I-405	PIER 2 CAPBEAM BOLSTER DETAILS -1
0		44473	1004	BG5	7	BRIDGE 5 61 ST AVE S OVER I-405	PIER 2 CAPBEAM BOLSTER DETAILS -2
0		44473	1004	BG5	8	BRIDGE 5 61 ST AVE S OVER I-405	PIER 2 COLUMN RETROFIT DETAILS
E		12/22/21	FINAL	BG17.7	1	BRIDGE 405/17.7 - RENTON AVENUE OVER I-405	BRIDGE LAYOUT
E		12/22/21	FINAL	BG17.7	2	BRIDGE 405/17.7 - RENTON AVENUE OVER I-405	BRIDGE GENERAL NOTES
E		12/22/21	FINAL	BG17.7	3	BRIDGE 405/17.7 - RENTON AVENUE OVER I-405	CONSTRUCTION SEQUENCE
E		12/22/21	FINAL	BG17.7	4	BRIDGE 405/17.7 - RENTON AVENUE OVER I-405	DEMOLITION DETAILS

REV. NO.	INCLUDED	REV. DATE	SUB. NO.	PLAN REF NO.	SHEET TITLE	SHEET DESCRIPTION	
E		12/22/21	FINAL	BG17.7	5	BRIDGE 405/17.7 - RENTON AVENUE OVER I-405	FOUNDATION LAYOUT
E		12/22/21	FINAL	BG17.7	6	BRIDGE 405/17.7 - RENTON AVENUE OVER I-405	PIER 1 PLAN AND ELEVATION
E		12/22/21	FINAL	BG17.7	7	BRIDGE 405/17.7 - RENTON AVENUE OVER I-405	PIER 1 DETAILS 1 OF 3
E		12/22/21	FINAL	BG17.7	8	BRIDGE 405/17.7 - RENTON AVENUE OVER I-405	PIER 1 DETAILS 2 OF 3
E		12/22/21	FINAL	BG17.7	9	BRIDGE 405/17.7 - RENTON AVENUE OVER I-405	PIER 1 DETAILS 3 OF 3
E		12/22/21	FINAL	BG17.7	10	BRIDGE 405/17.7 - RENTON AVENUE OVER I-405	FRAMING PLAN
E		12/22/21	FINAL	BG17.7	11	BRIDGE 405/17.7 - RENTON AVENUE OVER I-405	TYPICAL SECTION
E		12/22/21	FINAL	BG17.7	12	BRIDGE 405/17.7 - RENTON AVENUE OVER I-405	CONCRETE BOX DETAILS 1 OF 13
E		12/22/21	FINAL	BG17.7	13	BRIDGE 405/17.7 - RENTON AVENUE OVER I-405	CONCRETE BOX DETAILS 2 OF 13
E		12/22/21	FINAL	BG17.7	14	BRIDGE 405/17.7 - RENTON AVENUE OVER I-405	CONCRETE BOX DETAILS 3 OF 13
E		12/22/21	FINAL	BG17.7	15	BRIDGE 405/17.7 - RENTON AVENUE OVER I-405	CONCRETE BOX DETAILS 4 OF 13
E		12/22/21	FINAL	BG17.7	16	BRIDGE 405/17.7 - RENTON AVENUE OVER I-405	CONCRETE BOX DETAILS 5 OF 13
E		12/22/21	FINAL	BG17.7	17	BRIDGE 405/17.7 - RENTON AVENUE OVER I-405	CONCRETE BOX DETAILS 6 OF 13
E		12/22/21	FINAL	BG17.7	18	BRIDGE 405/17.7 - RENTON AVENUE OVER I-405	CONCRETE BOX DETAILS 7 OF 13
E		12/22/21	FINAL	BG17.7	37	BRIDGE 405/17.7 - RENTON AVENUE OVER I-405	BP-24 BRIDGE RAILING 2 OF 2
E		12/22/21	FINAL	W03.66L	1	RENTON AVENUE OVER I-405	RETAINING WALL 03.66L 1 OF 2
E		12/22/21	FINAL	W03.66L	2	RENTON AVENUE OVER I-405	RETAINING WALL 03.66L 2 OF 2
0		09/21/21	1726	BG18W	1	SB I-405 OVER CEDAR RIVER	BRIDGE LAYOUT
0		09/21/21	1726	BG18W	2	SB I-405 OVER CEDAR RIVER	BRIDGE GENERAL NOTES
0		09/21/21	1726	BG18W	3	SB I-405 OVER CEDAR RIVER	STAGED CONSTRUCTION
0		09/21/21	1726	BG18W	4	SB I-405 OVER CEDAR RIVER	DEMOLITION DETAILS
0		09/21/21	1726	BG18W	5	SB I-405 OVER CEDAR RIVER	PIER 1 PLAN AND ELEVATION
0		09/21/21	1726	BG18W	6	SB I-405 OVER CEDAR RIVER	PIER 1 DETAILS 1
0		09/21/21	1726	BG18W	7	SB I-405 OVER CEDAR RIVER	PIER 2 PLAN AND ELEVATION
0		09/21/21	1726	BG18W	8	SB I-405 OVER CEDAR RIVER	PIER 2 DETAILS 1
0		09/21/21	1726	BG18W	9	SB I-405 OVER CEDAR RIVER	BEARING DETAILS
0		09/21/21	1726	BG18W	10	SB I-405 OVER CEDAR RIVER	FRAMING PLAN
0		09/21/21	1726	BG18W	11	SB I-405 OVER CEDAR RIVER	TYPICAL SECTIONS
0		09/21/21	1726	BG18W	12	SB I-405 OVER CEDAR RIVER	STEEL GIRDER DETAILS 1 OF 3
0		09/21/21	1726	BG18W	13	SB I-405 OVER CEDAR RIVER	STEEL GIRDER DETAILS 2 OF 3
0		09/21/21	1726	BG18W	14	SB I-405 OVER CEDAR RIVER	STEEL GIRDER DETAILS 3 OF 3
0		09/21/21	1726	BG18W	15	SB I-405 OVER CEDAR RIVER	CROSS FRAME DETAILS 1 OF 2
0		09/21/21	1726	BG18W	16	SB I-405 OVER CEDAR RIVER	CROSS FRAME DETAILS 2 OF 2
0		09/21/21	1726	BG18W	17	SB I-405 OVER CEDAR RIVER	GIRDER CAMBER DIAGRAM
0		09/21/21	1726	BG18W	18	SB I-405 OVER CEDAR RIVER	DECK PLAN
0		09/21/21	1726	BG18W	21	SB I-405 OVER CEDAR RIVER	DECK DETAILS 3 OF 3


[illegible]

PT. OF MIN. VERT. CLR. SPAN 2  
R-LINE STA. 15+88.99 (8.88' RT.)  
405NB STA. 7493+49.00 (27.34' LT.)

PT. OF MIN. VERT. CLR. SPAN 1  
R-LINE STA. 15+08.84 (8.84' RT.)  
405SB STA. 5497+88.24 (42.00' LT.)

BRIDGE BEFORE APPROACH FILLS  
5" CIP BOX GIRDER  
BRIDGE DECK PROTECTION SYSTEM = TYPE 1  
CAST-IN-PLACE CONCRETE STRENGTH PER GENERAL NOTES

FILE NO. 9242 SHEET

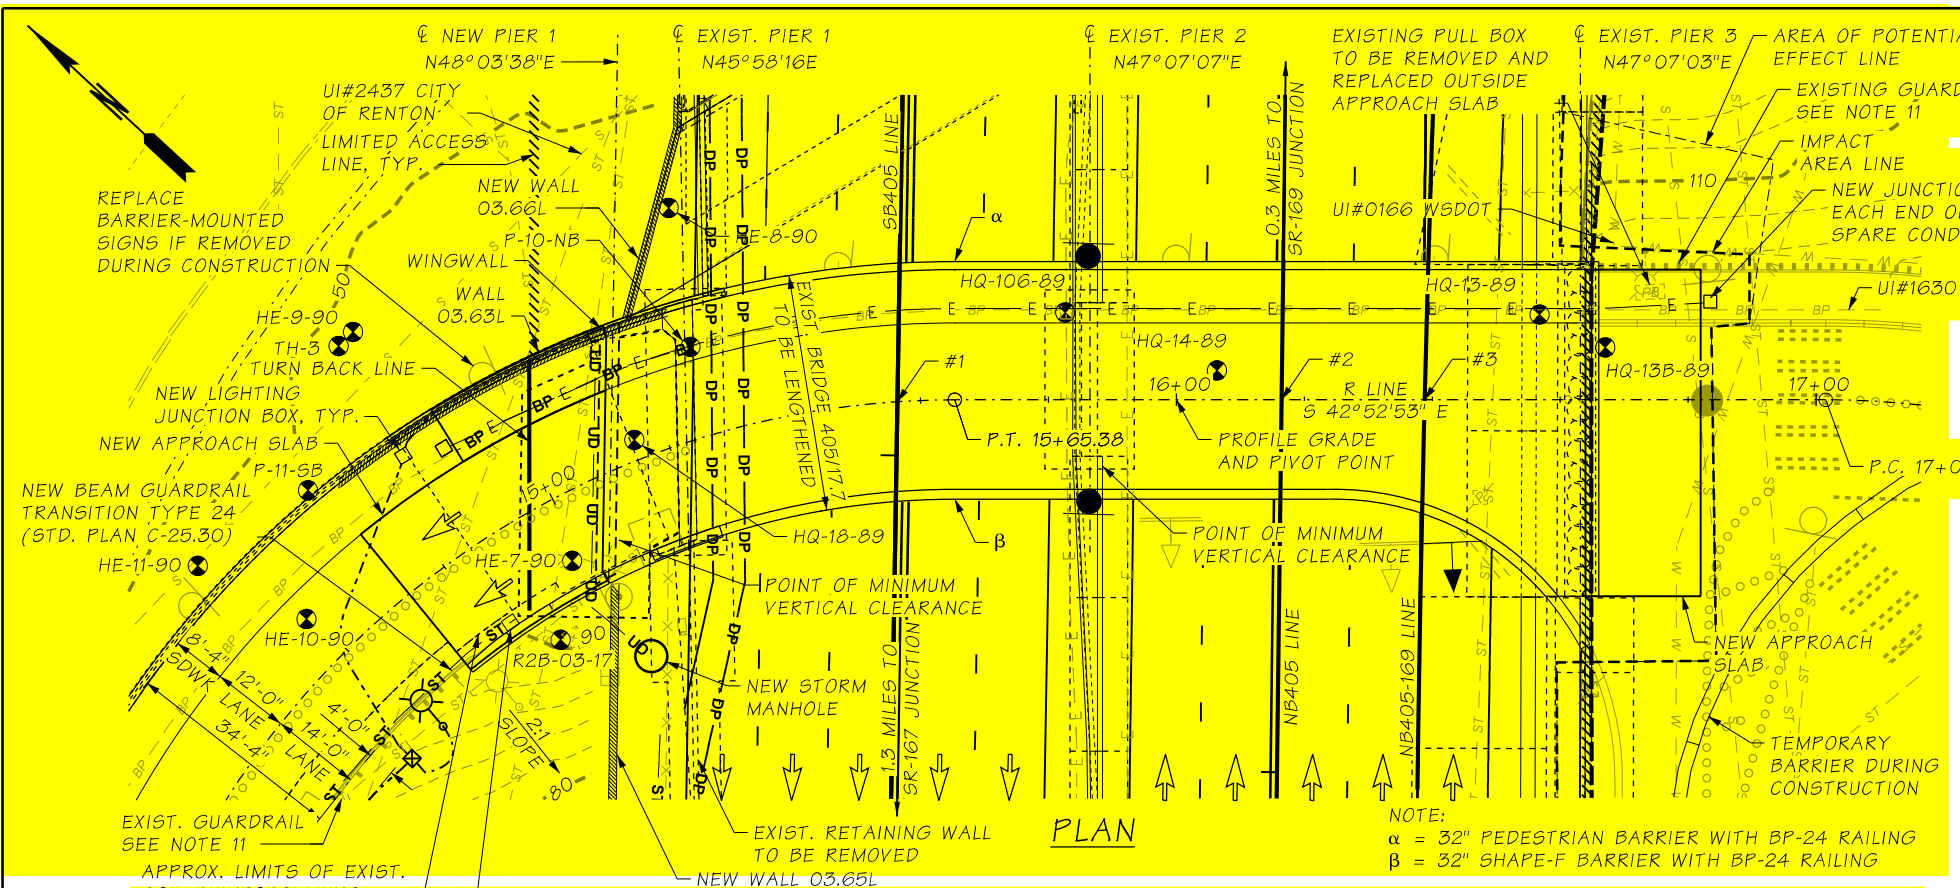

SEC. 17, T.23N., R.5E., W.M.  
CITY OF RENTON  
I-405

R LINE CURVE DATA						
P.I. STATION	DELTA	RADIUS	TANGENT	LENGTH	S	BACK TANGENT
14+88.89	84°34'41" RT	135.00'	122.79'	199.28'	0.04'/FT	N52°32'26"E

LEGEND:

- TEST BORING
- NEW RETAINING WALL
- NEW LIGHT POLE
- EXIST. LIGHT POLE
- EXIST. CONDUIT
- EXIST. BURIED POWER
- NEW SPARE CONDUIT
- UD - NEW UNDERDRAIN
- DP - NEW DRAIN PIPE
- BP - NEW BURIED POWER
- ST - NEW STORM SEWER
- NEW CATCH BASIN
- EXIST. CATCH BASIN
- EXIST. BARRIER MOUNTED SIGN
- EXIST. BRIDGE MOUNTED SIGN (TO BE REMOVED)
- NEW BRIDGE MOUNTED SIGN


INTERSECTION EQUATIONS:

- #1 R-LINE STA 15+56.40 = SB405 STA 5498+08.42 INTERSECTION ANGLE = 85°14'59"
- #2 R-LINE STA 16+16.45 = NB405 STA 7493+58.23 INTERSECTION ANGLE = 89°17'42"
- #3 R-LINE STA 16+38.81 = NB405-169 STA 493+61.74 INTERSECTION ANGLE = 88°36'13"



NOTES:

- EXISTING DIMENSIONS SHOWN ARE BASED ON RECORD PLANS AND SHALL BE FIELD VERIFIED.
- FOR PAVEMENT MARKINGS, SEE PLAN REF. NO. MK-14.
- FOR RETAINING WALLS 03.63L AND 03.65L, SEE PLAN REF. NO. W86-1 AND W83-1, RESPECTIVELY. RETAINING WALL 03.66L INCLUDED IN BRIDGE 405/17.7 PACKAGE.
- FOR DRAINAGE, SEE PLAN REF. NO. DR-14. RETAINING WALL 03.66L INCLUDED IN BRIDGE 405/17.7 PACKAGE.
- FOR UTILITIES, SEE PLAN REF. NO. UT-14.
- FOR SIGNS AND SIGN STRUCTURES, SEE PLAN REF. NO. SN-14 & ST-07B, RESPECTIVELY.
- FOR MAINTENANCE OF TRAFFIC, SEE PLAN REF. NO. MOT-14.
- FOR ITS, SEE PLAN REF. NO. TS-14.
- R-LINE PROVIDED FOR BRIDGE CONSTRUCTION ONLY AND DOES NOT MATCH RNT LINE USED FOR ROADWAY AND OTHER ELEMENTS.
- REMOVE AND REPLACE AS REQUIRED FOR CONSTRUCTION.

BOX GIRDER LENGTHENING  
LOADING: HL-93



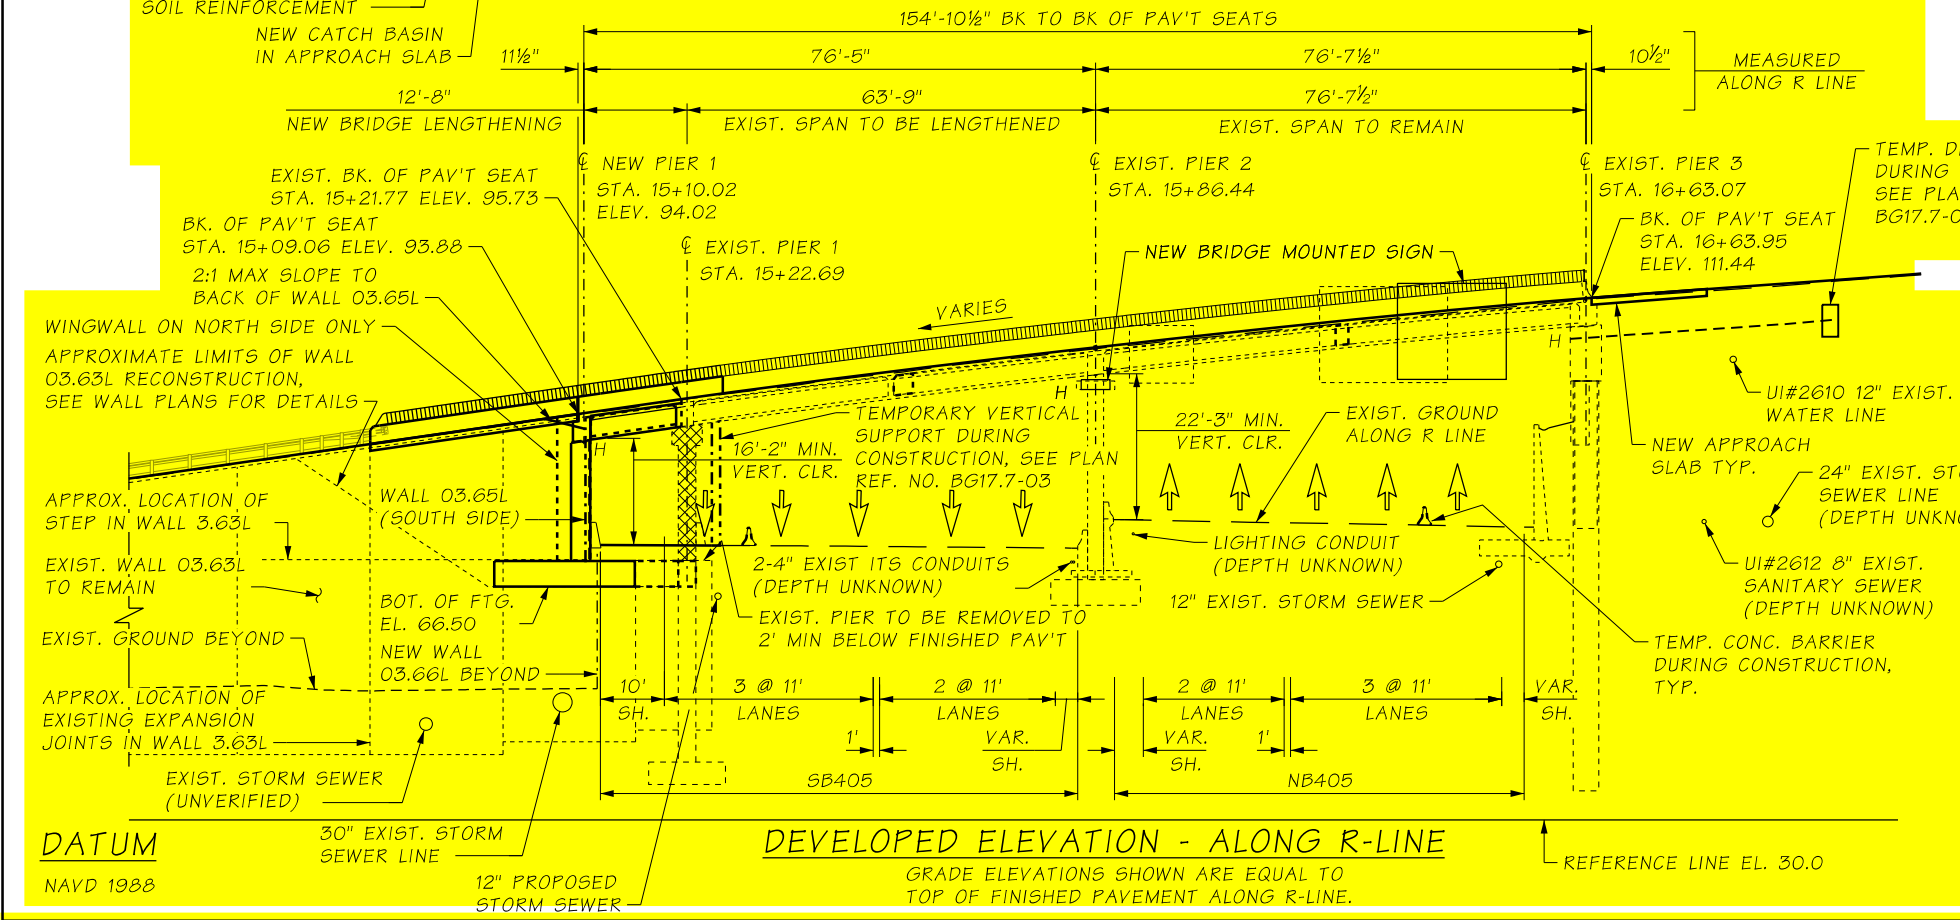


c:\users\mkal\documents\projectwise\workingdir\wdsdot\dms22941\XL5467_01_DE_BG_BR17.7-Layout.dgn		REGION NO.		STATE		FED. AID. PROJ. NO.		SHEET NO.		TOTAL SHEETS	
Design Mgr:	B. BELL	RELEASE FOR CONSTRUCTION RECORD		10	WASH.						
Designed By:	B. HU										
Checked By:	M. BAUGHMAN										
Detailed By:	J. GANASSIN										
Current Revision By:											
Date:	12/20/2021										
Time:	10:22:12 AM	DESCRIPTION		DATE	NO	JOB NUMBER		CONTRACT NO.		C9242	

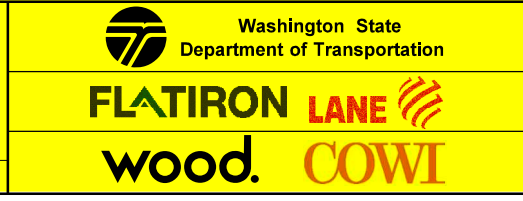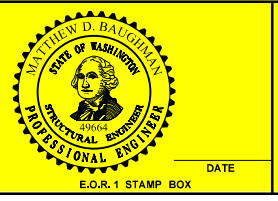

I-405; RENTON TO BELLEVUE WIDENING AND EXPRESS TOLL LANES PROJECT		BRIDGE 405/17.7 - RENTON AVE OVER I-405	
BRIDGE LAYOUT		SHEET OF SHEETS	

C.S. 1743 ~ PROJECT NUMBER 9242 ~ NORTHWEST REGION ~ I-405 ~ BRIDGE NO 405/17.7 (LENGTHENING)

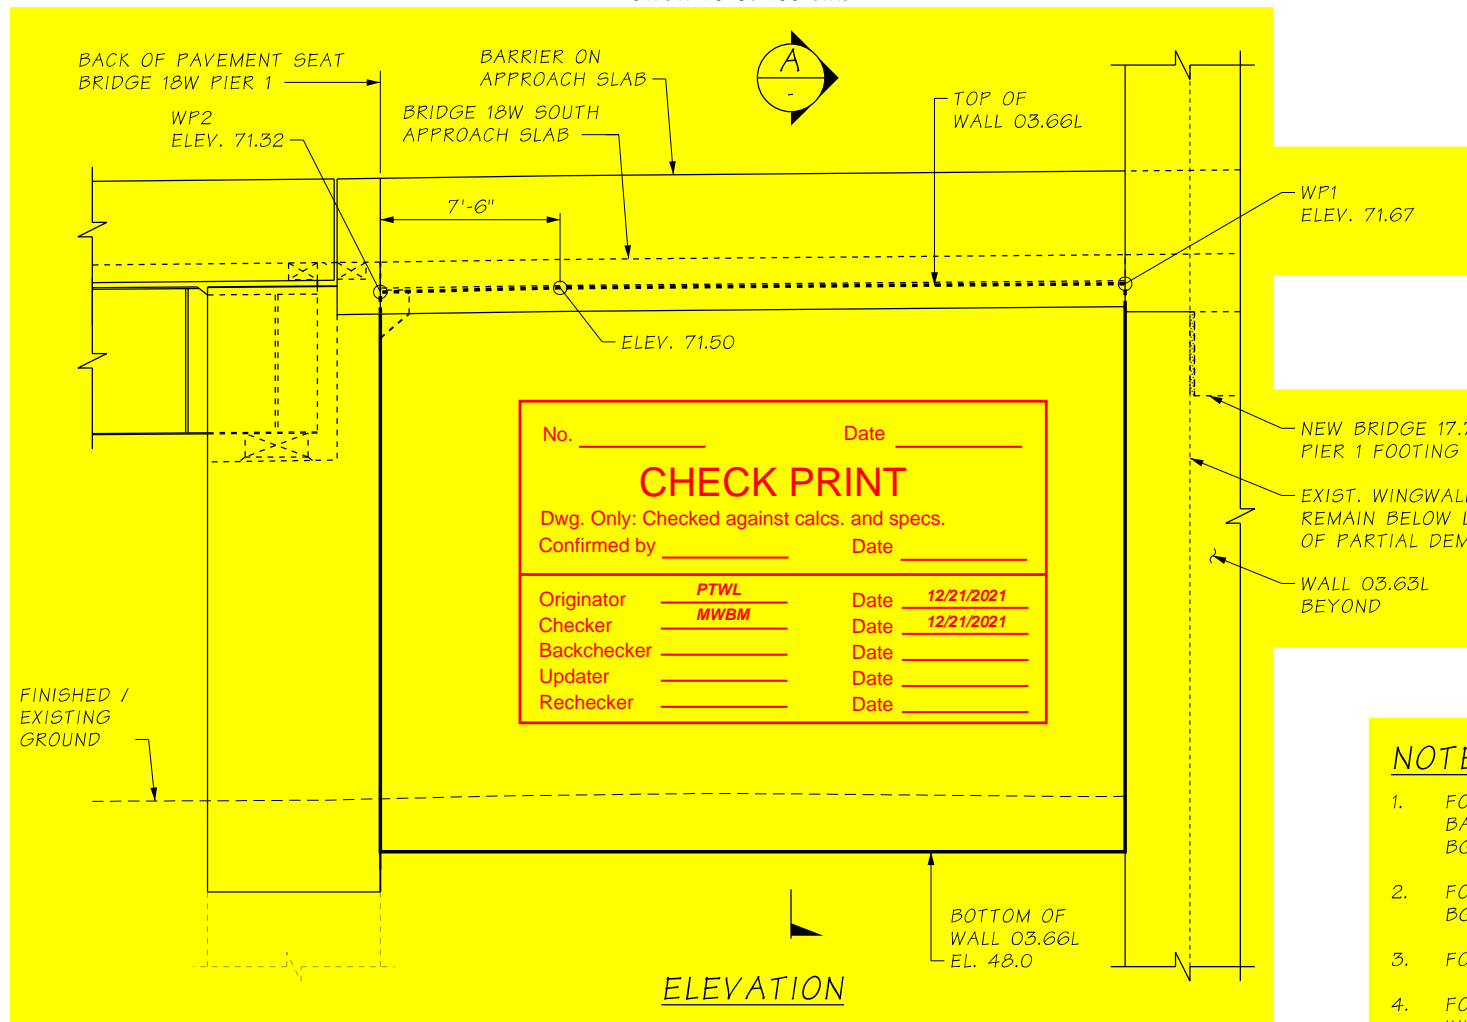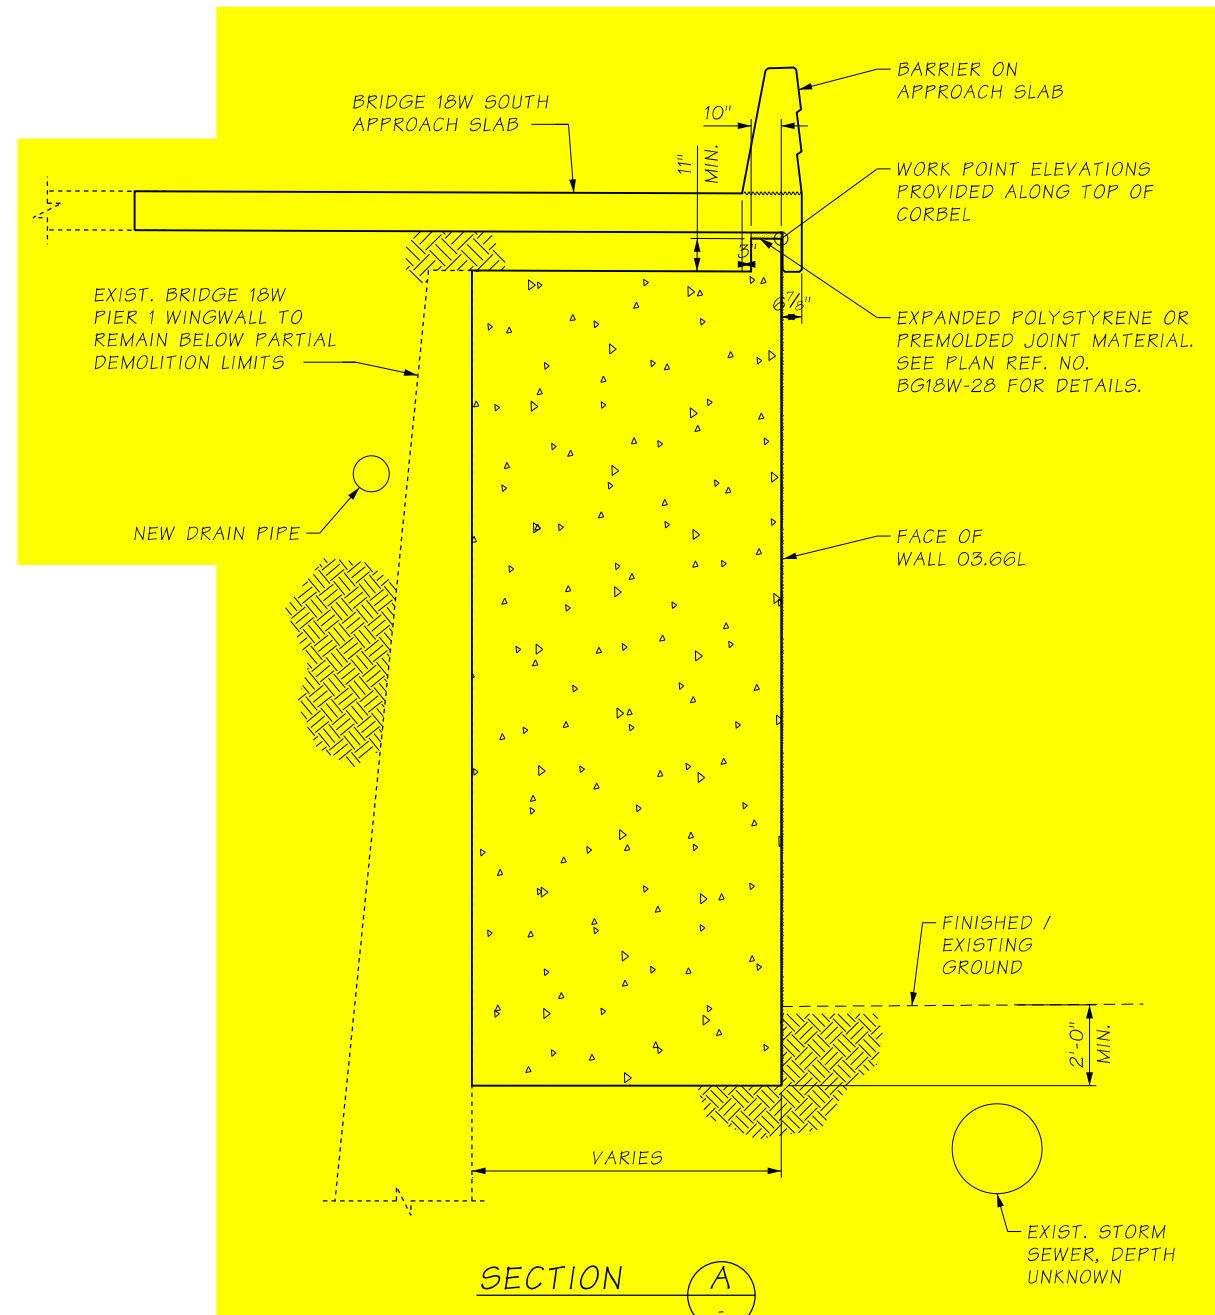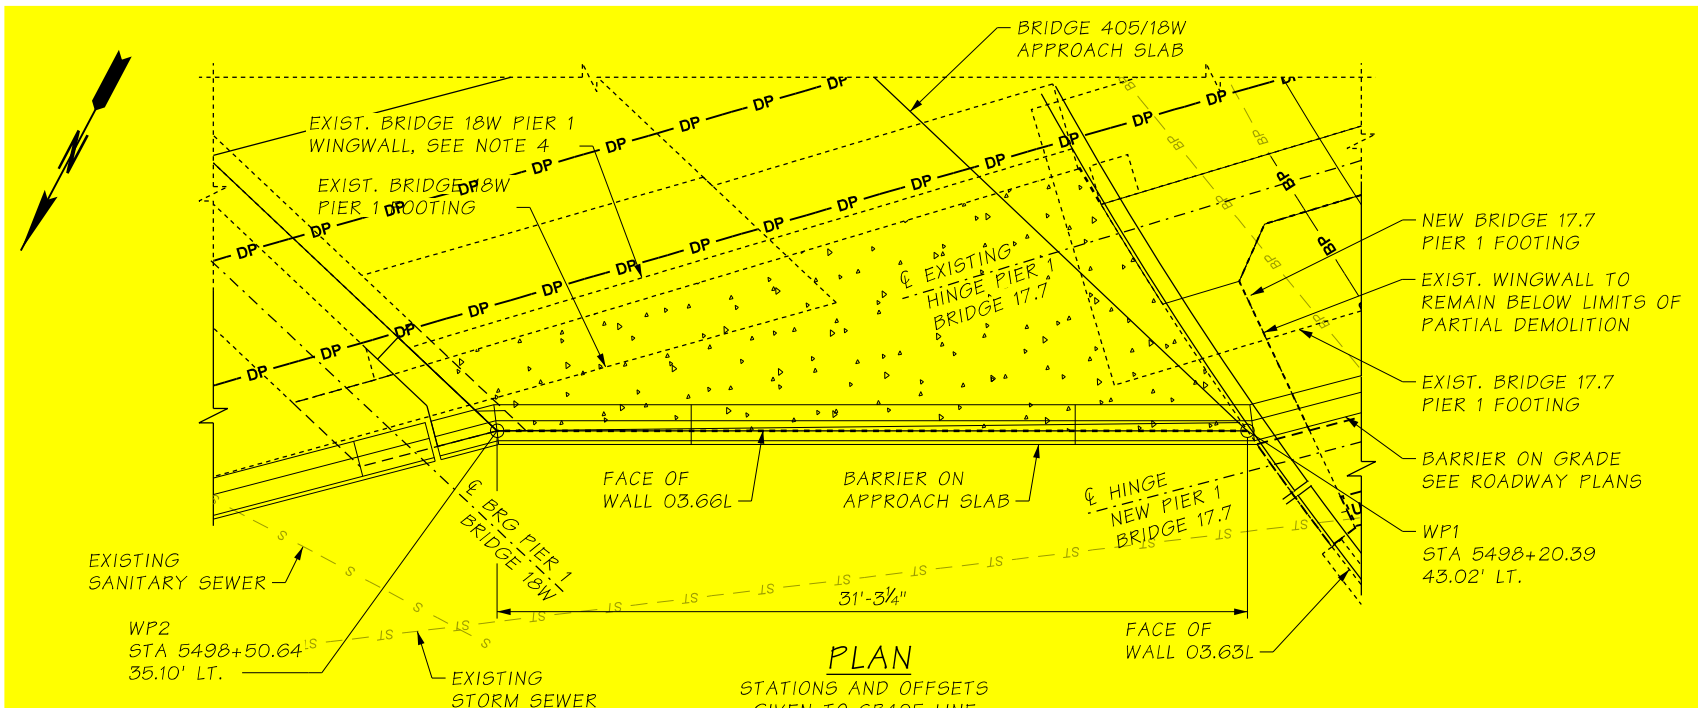


#### NOTES:

- FOR BRIDGE 18W PIER 1, SOUTH APPROACH SLAB AND BARRIER DETAILS, SEE PLAN REF. NO. BG18W-05, BG18W-25 AND BG18W-27.
- FOR BRIDGE 17.7 PIER 1 DETAILS, SEE PLAN REF. NO. BG17.7-06.
- FOR WALL 03.63L DETAILS, SEE PLAN REF. NO. W86-1.
- FOR PARTIAL DEMOLITION OF BRIDGE 18W EXISTING WINGWALL, SEE PLAN REF. NO. BG18W-04.

- DIMENSIONS REFERENCING EXISTING ELEMENTS ARE BASED ON AS-BUILT DRAWINGS AND SHALL BE FIELD VERIFIED. CONTRACTOR SHALL NOTIFY ENGINEER IF SIGNIFICANT DIFFERENCES ARE OBSERVED.
- THE FRONT FACE OF WALL 03.66L SHALL HAVE A FRACTURED FIN FINISH WITH PIGMENTED SEALER TO 1' BELOW FINISHED GROUND. PIGMENTED SEALER TO BE 'WASHINGTON GRAY' COLOR TO MATCH EXISTING. SEE PLAN REF. NO. BG18W-25 FOR DETAILS OF FRACTURED FIN FINISH.

FILE NO. 9242 SHEET 1-405

c:\users\mkal\documents\projectwise\workingdir\wsdot\dms22941\XL5467_01_DE_RW_W03.66L-RefWall1.dgn		RELEASE FOR CONSTRUCTION RECORD		REGION NO.	STATE	FED. AID. PROJ. NO.	SHEET NO.	TOTAL SHEETS
Design Mgr:	B. BELL			10	WASH.			
Designed By:	C. KHUSHIRAM							
Checked By:	M. DASTFAN				JOB NUMBER			
Detailed By:	J. GANASSIN				XL5467			
Current Revision By:					CONTRACT NO.			
Date:	12/16/2021				C9242			
Time:	3:25:13 PM	DESCRIPTION	DATE	NO				

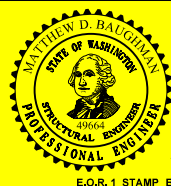

DATE

E.O.R. 2 STAMP BOX



Washington State  
Department of Transportation

FLATIRON LANE  
wood. COWI

I-405; RENTON TO BELLEVUE WIDENING  
AND EXPRESS TOLL LANES PROJECT

RENTON AVE OVER I-405

RETAINING WALL 03.66L  
1 OF 2

PLAN REF. NO.  
W03.66L-1

SHEET  
OF  
SHEETS



INDEX OF SHEETS	
PLAN REF NO	SHEET TITLE
BG17.7-01	BRIDGE LAYOUT
BG17.7-02	BRIDGE GENERAL NOTES
BG17.7-03	CONSTRUCTION SEQUENCE
BG17.7-04	DEMOLITION DETAILS
BG17.7-05	FOUNDATION LAYOUT
BG17.7-06	PIER 1 PLAN AND ELEVATION
BG17.7-07	PIER 1 DETAILS 1 OF 3
BG17.7-08	PIER 1 DETAILS 2 OF 3
BG17.7-09	PIER 1 DETAILS 3 OF 3
BG17.7-10	FRAMING PLAN
BG17.7-11	TYPICAL SECTION
BG17.7-12	CONCRETE BOX DETAILS 1 OF 13
BG17.7-13	CONCRETE BOX DETAILS 2 OF 13
BG17.7-14	CONCRETE BOX DETAILS 3 OF 13
BG17.7-15	CONCRETE BOX DETAILS 4 OF 13
BG17.7-16	CONCRETE BOX DETAILS 5 OF 13
BG17.7-17	CONCRETE BOX DETAILS 6 OF 13
BG17.7-18	CONCRETE BOX DETAILS 7 OF 13
BG17.7-19	CONCRETE BOX DETAILS 8 OF 13
BG17.7-20	CONCRETE BOX DETAILS 9 OF 13
BG17.7-21	CONCRETE BOX DETAILS 10 OF 13
BG17.7-22	CONCRETE BOX DETAILS 11 OF 13
BG17.7-23	CONCRETE BOX DETAILS 12 OF 13
BG17.7-24	CONCRETE BOX DETAILS 13 OF 13
BG17.7-25	POST-TENSIONING LAYOUT
BG17.7-26	POST-TENSIONING DETAILS
BG17.7-27	UTILITY SUPPORTS
BG17.7-28	BARRIER DETAILS 1 OF 4
BG17.7-29	BARRIER DETAILS 2 OF 4
BG17.7-30	BARRIER DETAILS 3 OF 4
BG17.7-31	BARRIER DETAILS 4 OF 4
BG17.7-32	APPROACH SLABS 1 OF 4
BG17.7-33	APPROACH SLABS 2 OF 4
BG17.7-34	APPROACH SLABS 3 OF 4
BG17.7-35	APPROACH SLABS 4 OF 4
BG17.7-36	BP-24 BRIDGE RAILING 1 OF 2
BG17.7-37	BP-24 BRIDGE RAILING 2 OF 2

LEGEND

A

05

TAKEN OR SHOWN ON  
PLAN REF. NO. BG17.7-05

1

-

TAKEN OR SHOWN ON CURRENT SHEET

▽

←

EPOXY COATED BAR

PJF = PREFORMED JOINT FILLER

SURVEY CONTROL POINTS				
POINT	STATION	OFFSET	NORTHING	EASTING
P.C.	13+66.10	0.00	178132.25	1302053.21
P.T.	15+65.38	0.00	178116.95	1302234.24
P.C.	17+01.50	0.00	178017.21	1302326.86

GENERAL NOTES:

1. ALL MATERIALS AND WORKMANSHIP SHALL BE IN ACCORDANCE WITH THE REQUIREMENTS OF THE WASHINGTON STATE DEPARTMENT OF TRANSPORTATION "STANDARD SPECIFICATION FOR ROADS, BRIDGES, AND MUNICIPAL CONSTRUCTION", ENGLISH UNITS, DATED 2018 AND AMENDED JANUARY 7, 2019.

2. NEW CONSTRUCTION HAS BEEN DESIGNED IN ACCORDANCE WITH THE REQUIREMENTS OF THE "AASHTO LRFD BRIDGE DESIGN SPECIFICATIONS", EIGHTH EDITION 2017. DEAD LOAD INCLUDES AN ALLOWANCE OF 65 POUNDS PER LINEAR FOOT FOR THE ELECTRICAL CONDUITS AND ATTACHMENTS. THE BRIDGE TRAFFIC BARRIERS HAVE BEEN DESIGNED IN ACCORDANCE WITH THE REQUIREMENTS FOR TEST LEVEL 4 (TL-4) RAILINGS.

3. THE SEISMIC DESIGN OF THIS STRUCTURE HAS BEEN COMPLETED IN ACCORDANCE WITH THE REQUIREMENTS OF THE "AASHTO GUIDE SPECIFICATIONS FOR LRFD SEISMIC BRIDGE DESIGN" SECOND EDITION 2011, WITH INTERIMS THROUGH 2015, USING SEISMIC DESIGN CATEGORY C, SITE CLASS C, AND THE FOLLOWING ACCELERATION PARAMETERS:

PERIOD (sec)	SAFETY EVALUATION EARTHQUAKE (g)
0.0 (PGA)	0.51
0.1	1.07
0.2	1.26
0.3	1.09
0.4	0.90
0.5	0.75
0.6	0.64
0.7	0.55
0.8	0.49
0.9	0.43
1.0	0.38
1.5	0.24
2.0	0.17
3.0	0.10
4.0	0.071
5.0	0.056

PGA = PEAK GROUND ACCELERATION  
THE SITE-SPECIFIC SEE RESPONSE SPECTRUM IS IN ACCORDANCE WITH GEOTECH REPORT "I-405 R2B SEGMENT 1A SITE SPECIFIC HAZARD ANALYSIS RFU" DATED MARCH 25, 2021, USING THE BR-18W SITE DATA.

4. THE CONCRETE FOR THE SUPERSTRUCTURE SHALL BE CLASS 5000. THE CONCRETE IN APPROACH SLABS SHALL BE CLASS 4000A. ALL OTHER CAST-IN-PLACE CONCRETE SHALL BE CLASS 4000. THE CONCRETE FOR THE TOP SLAB OF THE SUPERSTRUCTURE SHALL ALSO MEET THE REQUIREMENTS FOR CLASS 4000 CONCRETE IN SECTIONS 6-02.3(2)A1 AND 6-02.3(4)D OF THE WSDOT STANDARD SPECIFICATIONS.

5. REINFORCING BARS SHALL CONFORM TO ASTM A706 GRADE 60 UNLESS OTHERWISE NOTED. UNLESS OTHERWISE NOTED, THE MINIMUM LAP SPLICE FOR BLACK REINFORCING BARS SHALL BE:

BAR SIZES:	#4	#5	#6	#7	#8	#9	#10	#11
SPLICE LENGTH (TOP BARS):	2'-0"	2'-7"	3'-1"	3'-7"	4'-1"	4'-7"	5'-2"	5'-9"

SPLICE LENGTH (OTHERS):	2'-0"	2'-0"	2'-5"	2'-9"	3'-2"	3'-7"	4'-0"	4'-5"
-------------------------	-------	-------	-------	-------	-------	-------	-------	-------

THE ABOVE SPLICE LENGTHS ARE FOR CLASS B SPLICES WHERE  $\lambda_{sc}$  = 0.4. TOP BARS ARE HORIZONTAL BARS PLACED SUCH THAT MORE THAN 12" OF CONCRETE IS CAST BELOW REINFORCEMENT. LAP SPLICES OF ADJACENT BARS SHALL BE STAGGERED UNLESS NOTED OTHERWISE.

6. THE LOCATIONS OF ALL EXISTING UTILITIES WITHIN THE VICINITY OF THE STRUCTURE SHALL BE VERIFIED BY THE CONTRACTOR PRIOR TO EXCAVATION.

7. UNLESS OTHERWISE SHOWN ON THE PLANS, THE CONCRETE COVER MEASURED FROM THE FACE OF THE CONCRETE TO THE FACE OF ANY REINFORCEMENT BAR SHALL BE AS FOLLOWS:

2½" TOP OF TOP SLAB  
1" TOP AND BOTTOM OF BOTTOM SLAB AND BOTTOM OF TOP SLAB  
1½" BOTH FACES OF WEBS  
3" CAST AGAINST EARTH  
2" ALL OTHER LOCATIONS.

8. FALSEWORK SHALL BE CAREFULLY RELEASED TO PREVENT IMPACT OR UNDUE STRESS IN STRUCTURE.

9. THE BACKFILL BEHIND THE ABUTMENTS SHALL NOT BE PLACED UNTIL THE BRIDGE SUPERSTRUCTURE IS COMPLETED, AS NOTED IN THE CONSTRUCTION SEQUENCE, SEE PLAN REF. NO. BG17.7-03. BACKFILL AT THE PIER ABUTMENTS SHALL BE PLACED IN ACCORDANCE WITH STANDARD SPECIFICATION 2-03.3(14)I.

10. ALL EXPOSED CONCRETE CORNERS SHALL BE CHAMFERED ¾", UNLESS NOTED OTHERWISE.

11. CONTRACTOR SHALL AVOID DAMAGE TO EXISTING REINFORCING STEEL DURING DRILLING OPERATIONS. CONTRACTOR SHALL NOTIFY ENGINEER IMMEDIATELY IF ANY EXISTING REBAR OR ANCHOR BOLTS ARE DAMAGED.

12. HOLES DRILLED IN EXISTING CONCRETE SHALL BE DRILLED WITH A ROTARY HAMMER. CORE DRILLING IS NOT ALLOWED, UNLESS NOTED OTHERWISE.

13. EQUIPMENT FOR REMOVING PORTIONS OF EXISTING CONCRETE WHERE EXISTING STEEL REINFORCEMENT IS SPECIFIED TO BE SAVED SHALL BE SELECTED ACCORDINGLY. THE FOLLOWING LIMITS APPLY TO POWER DRIVEN TOOLS:

- JACK HAMMERS NO MORE FORCEFUL THAN THE NOMINAL 30 POUND CLASS.
- CHIPPING HAMMERS NO MORE FORCEFUL THAN THE NOMINAL 15 POUND CLASS.

POWER DRIVEN TOOLS SHALL BE OPERATED AT ANGLES LESS THAN 45 DEGREES AS MEASURED FROM THE SURFACE OF THE CONCRETE.

4. DIMENSIONS SHOWN IN THESE PLANS ARE BASED ON ORIGINAL CONSTRUCTION RECORDS AND SITE SURVEYS. DIMENSIONS SHALL BE MEASURED IN THE FIELD AND VERIFIED BY THE CONTRACTOR. CONTRACTOR SHALL NOTIFY ENGINEER IF SIGNIFICANT DIFFERENCES ARE OBSERVED.

5. AS-BUILT PLANS FOR THE EXISTING BRIDGE AND RETAINING WALLS ARE PROVIDED IN APPENDICES N1 AND N2 OF THE CONFORMED RFP.

6. SPREAD FOOTING DESIGN IS BASED ON THE FOLLOWING FACTORED BEARING RESISTANCES:

LOCATION	FACTORED BEARING RESISTANCES (KSF)		
	SERVICE LIMIT STATE (1" SETTLEMENT)	STRENGTH LIMIT STATE	EXTREME LIMIT STATE
PIER 1	5.4	7	12

THE FACTORED BEARING RESISTANCES ARE IN ACCORDANCE WITH "GEOTECHNICAL REPORT: BRIDGE 405/17.7 (SB I-405 over Renton Avenue) and Walls 03.63L, 03.65L, 03.66L".

17. ASSUMED CONSTRUCTION LIVE LOAD = 10PSF. CONTRACTOR SHALL INCLUDE LOADING CONFIGURATION IN THE DEMOLITION PLAN SUBMITTAL IN ACCORDANCE WITH STANDARD SPECIFICATION 2-02.3(2)A1.

18. ALL EXISTING AND NEW FORMWORK SHALL BE REMOVED FROM THE OUTER CELLS OF THE BOX.

19. WHERE THESE PLANS REFER TO CARDINAL DIRECTIONS TO DESCRIBE LOCATIONS, THESE SHALL GENERALLY BE INTERPRETED AS FOLLOWS:

- NORTH = LOOKING AHEAD ON STATIONING OF NB405 LINE
- SOUTH = LOOKING BACK ON STATIONING OF SB405 LINE
- EAST = LOOKING AHEAD ON STATIONING OF R-LINE
- WEST = LOOKING BACK ON STATIONING OF R-LINE

HOLD POINTS:

CONTRACTOR SHALL FOLLOW THE HOLD POINT PROCESS AS ESTABLISHED IN SECTION 2.28.5.4 OF THE CONFORMED RFP DOCUMENTS. MINIMUM HOLD POINTS FOR THIS BRIDGE ARE AS FOLLOWS:

- AFTER INSTALLATION OF TEMPORARY DEADMAN BEHIND PIER 3 AND BEFORE THE START OF EXCAVATION BEHIND PIER 1
- AFTER COMPLETION OF BRIDGE EXCAVATION AND BEFORE THE START OF STRUCTURE FOUNDATION
- BEFORE CONCRETE PLACEMENT OF FOOTINGS, PIER WALL, SUPERSTRUCTURE, TRAFFIC BARRIERS, WING WALLS AND CURTAIN WALLS (WITH FORMWORK, INSERTS, AND REINFORCEMENT IN PLACE)
- PRIOR TO INSTALLATION OF POST-TENSIONING STRANDS
- PRIOR TO JACKING OPERATIONS FOR POST-TENSIONING WITH A HYDRAULIC JACK
- PRIOR TO DEMOLITION OF EXISTING ABUTMENT

c:\users\mkal\documents\projectwise\workingdir\wsdot\dms22941\XL5467_02_DE_BG_BR17.7-Notes.dgn				
Design Mgr:	B. BELL	RELEASE FOR CONSTRUCTION RECORD		
Designed By:	B. HU			
Checked By:	M. BAUGHMAN			10
Detailed By:	J. GANASSIN			WASH.
Current Revision By:				JOB NUMBER XL5467
Date:	12/16/2021			CONTRACT NO. C9242
Time:	2:31:09 PM	DESCRIPTION	DATE	NO

REGION NO.	STATE	FED. AID, PROJ. NO.	SHEET NO.	TOTAL SHEETS
10	WASH.			

	DATE		DATE
E.O.R. 1 STAMP BOX		E.O.R. 2 STAMP BOX	

I-405; RENTON TO BELLEVUE WIDENING AND EXPRESS TOLL LANES PROJECT		PLAN REF. NO. BG17.7-02
BRIDGE 405/17.7 - RENTON AVE OVER I-405		SHEET OF SHEETS
BRIDGE GENERAL NOTES		



CONSTRUCTION SEQUENCE:

1. SEE OTHER PACKAGES FOR UTILITY RELOCATIONS, MAINTENANCE OF TRAFFIC, AND SITE PREPARATION.
2. PERFORM PRE-CONDITION SURVEYS OF EXISTING BRIDGE AND SURROUNDING STRUCTURES TO VERIFY THE AS-BUILT CONDITION. PERFORM PRE-CONDITION SURVEYS OF SENSITIVE UTILITIES AS REQUIRED. INITIATE STRUCTURE MONITORING, AS REQUIRED.
3. INSTALL TEMPORARY CIVIL WORKS AND TEMPORARY TRAFFIC CONTROL, AS REQUIRED.
4. CLOSE RENTON AVENUE BRIDGE TO ALL TRAFFIC (START OF 300 CALENDAR DAY ALLOWABLE FULL LOCAL ROAD CLOSURE PER RFP 2.22.4.3.4.3.).
5. BRIDGE CONSTRUCTION:

A. DESIGN AND INSTALL A TEMPORARY DEADMAN BEHIND PIER 3, OR A TEMPORARY STRUT IN FRONT OF PIER 3, TO PROVIDE APPROXIMATELY 850 kips (UNFACTORED) OF LATERAL RESTRAINT TO THE PIER 3 CAP IN ORDER TO:

1) LIMIT MAXIMUM MOMENTS IN PIER 3 PILES TO LESS THAN 1400 kip-ft PER PILE DURING CONSTRUCTION, AND

2) LIMIT THE MAXIMUM TOP OF PIER 3 DEFLECTION TO LESS THAN 1" DURING CONSTRUCTION.

LATERAL RESTRAINT IS ASSUMED TO BE APPLIED TO THE EXISTING PIER CAP APPROXIMATELY 2 FEET BELOW THE HINGE LINE. THE CONSTRUCTION INDUCED MOMENT AND DEFLECTION IS DUE TO UNBALANCED SOIL PRESSURE BEHIND PIER 3 WITH EXCAVATION BEHIND EXISTING PIER 1. TYPE 2E WORKING DRAWINGS SHALL DEMONSTRATE THAT MAXIMUM DEFLECTION AND MOMENTS IN PIER 3 PILES IS LIMITED AS REQUIRED DURING CONSTRUCTION.

B. DESIGN AND INSTALL A TEMPORARY VERTICAL SUPPORT IN FRONT OF EXISTING PIER 1. THE CENTERLINE OF TEMPORARY SUPPORT SHALL BE NO MORE THAN 2'-0" FROM FACE OF PIER 1 CAP. THE TEMPORARY SUPPORT SHALL BE PRE-LOADED TO RELEASE VERTICAL LOAD IN THE EXISTING PIER 1 HINGE CONNECTION. TEMPORARY VERTICAL SUPPORT SHALL SUPPORT THE BOX GIRDER SUPERSTRUCTURE UNDER THE EXISTING WEB LINES AND BE CAPABLE OF ACCOMMODATING ANTICIPATED MOVEMENTS DURING CONSTRUCTION. THE ESTIMATED (UNFACTORED DEAD LOAD) FORCES IN THE EXISTING PIER 1 HINGE CONNECTION ARE:

- 335 kips VERTICAL FORCE

- 440 kip-ft TRANSVERSE MOMENT (SOUTH SIDE OF PIER WALL IN COMPRESSION)

C. NEW PIER 1 AND BOX EXTENSION:

I. PARTIALLY DEMOLISH EXISTING RETAINING WALL 03.63L AND EXCAVATE TO BOTTOM OF NEW PIER 1 FOOTING. SURVEY BRIDGE AND PIER 3 TO VERIFY PERFORMANCE OF TEMPORARY DEADMAN (SEE STEP 5A).

II. CONSTRUCT NEW PIER 1 FOOTING, ABUTMENT WALL AND WINGWALL. RETAINING WALL 03.66L CONSTRUCTION MAY BEGIN.

III. PARTIALLY DEMOLISH THE EXTERIOR FACE OF THE EXISTING PIER 1 DIAPHRAGM, INCLUDING ACCESS OPENINGS, INSTALL MECHANICAL COUPLERS AND DOWELS, AND CORE HOLES FOR NEW POST-TENSIONING TENDONS.

IV. INSTALL TEMPORARY FALSEWORK FOR NEW BOX GIRDER SUPERSTRUCTURE EXTENSION.

V. CONSTRUCT NEW BOX GIRDER SUPERSTRUCTURE EXTENSION (BOTTOM SLAB, WEBS + DIAPHRAGMS, TOP SLAB), INCLUDING EXTENDING POWER CONDUITS.

D. EXISTING STRUCTURE MODIFICATIONS: (THIS STEP MAY BE PERFORMED CONCURRENT WITH, OR PRIOR TO, STEPS 5A AND 5B).

I. CUT ACCESS HOLES INTO EXISTING BOX GIRDER TOP SLAB FOR TEMPORARY ACCESS, AND INTO EXISTING BOX GIRDER BOTTOM SLAB FOR PERMANENT ACCESS HATCHES. CONTRACTOR SHALL INCLUDE TEMPORARY ACCESS PLAN IN DEMOLITION PLAN SUBMITTAL.

II. CORE HOLES THROUGH SPAN 1 INTERMEDIATE DIAPHRAGM AND EXIST PIER 1 DIAPHRAGM FOR NEW PT.

III. PARTIALLY DEMOLISH EXISTING DECK AND DIAPHRAGM AT PIER 2 AND RECONSTRUCT WITH NEW PT DEVIATOR.

IV. PARTIALLY DEMOLISH EXISTING DIAPHRAGM AT PIER 3 AND RECONSTRUCT WITH NEW PT ANCHORAGE.

V. FORM AND CAST CONCRETE DEVIATOR DIAPHRAGMS INSIDE EXISTING BOX IN SPANS 1 AND 2 WITH PT DEVIATORS.

VI. INSTALL PT DUCTS.

VII. FORM AND POUR THE TEMPORARY ACCESS OPENING CLOSURES IN TOP SLAB AND PERMANENT ACCESS HATCHES IN BOTTOM SLAB.

- E. POST-TENSION THE TENDONS (STRESS STRANDS AND GROUT DUCTS), WITH DEAD END AT PIER 3 AND LIVE END AT PIER 1. RETAINING WALL 03.66L SHALL BE CONSTRUCTED PRIOR TO POST-TENSIONING THE SUPERSTRUCTURE. REMOVE NEW BOX GIRDER EXTENSION FALSEWORK.
- F. COMPLETE BACKFILL AND RECONSTRUCTION OF WALL 03.63L AND CONSTRUCTION OF WALL 03.65L. TEMPORARY DEADMAN BEHIND PIER 3 (OR ALTERNATIVE MEASURES NOTED IN STEP 5A) MAY BE REMOVED AFTER BACKFILL BEHIND PIER 1 HAS BEEN PLACED UP TO THE HINGE LINE.
- G. DISENGAGE EXISTING PIER 1 FROM THE BOX GIRDER SUPERSTRUCTURE. CONTRACTOR SHALL INCLUDE METHOD AND PROCEDURES FOR TRANSFERRING LOAD FROM EXISTING PIER 1 TO NEW PIER 1 IN DEMOLITION PLAN SUBMITTAL.
- H. RELEASE LOAD FROM THE TEMPORARY VERTICAL SUPPORT IN FRONT OF PIER 1. THE ESTIMATED (UNFACTORED DEAD LOAD) FORCES REMAINING IN THE TEMPORARY SUPPORT JUST PRIOR TO RELEASING THE BOX GIRDER SUPERSTRUCTURE ARE:

- 565 kips VERTICAL FORCE

- 300 kip-ft TRANSVERSE MOMENT (SOUTH SIDE OF SUPPORT IN COMPRESSION)


THE ESTIMATED DISPLACEMENT OF THE BOX GIRDER SUPERSTRUCTURE AFTER REMOVAL OF THE TEMPORARY SUPPORT IS 3/8" VERTICALLY, MEASURED AT THE TEMPORARY SUPPORT, WITH NEGLIGIBLE LATERAL MOVEMENT.
- I. FIELD SURVEY GEOMETRY FOR AS-BUILT DOCUMENTATION.
- J. DEMOLISH EXISTING PIER 1 TO 2-FT MIN BELOW FINAL PAVEMENT ELEVATION.
- K. CONSTRUCT NEW PIER 1 FOOTING CLOSURE POUR CONNECTION TO EXISTING PIER 1 WALL.
- L. CONSTRUCT NEW EAST AND WEST APPROACH SLABS.
- M. FORM AND POUR NEW BRIDGE BARRIER, SIDEWALK, AND RAILING EXTENSION, INCLUDING EXTENDING LIGHTING CONDUIT.
- N. APPLY PIGMENTED SEALER AND INSTALL EXPANSION JOINTS.

6. COMPLETE SB405 WIDENING UNDER NEW BRIDGE.

7. FINISHING WORKS ADJACENT TO BRIDGE (PAVING, GUARDRAIL, SIGNING, LIGHTING, STRIPING, SITE RESTORATION, UTILITY RELOCATIONS, ETC.)

PARTIAL DEMOLITION OF EXISTING WALL 03.63L AND EXCAVATION FOR CONSTRUCTION OF NEW PIER 1

STEPS II THROUGH V MAY BE PERFORMED CONCURRENTLY

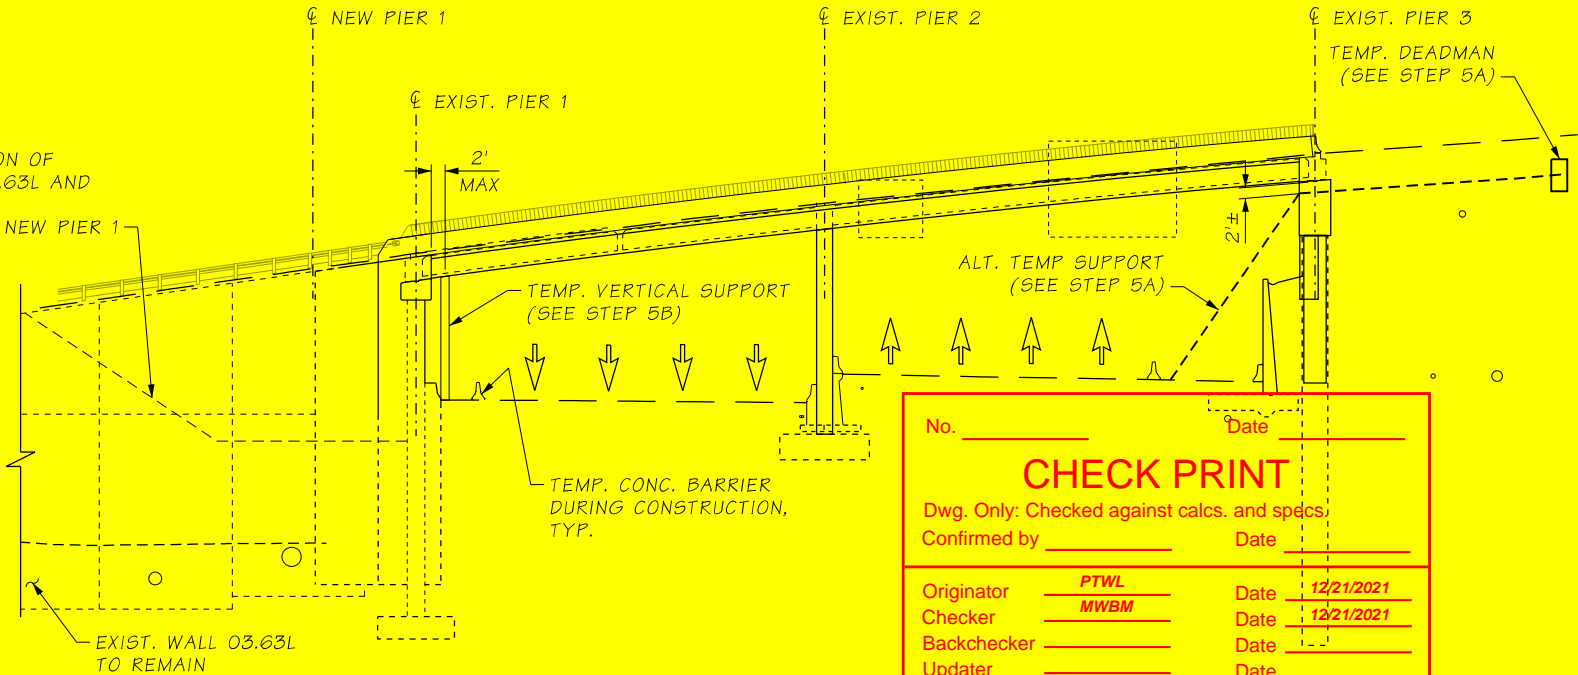

DEVELOPED ELEVATION - ALONG R-LINE  
(SHOWN AFTER STEP 5.C.I)

I-405  
FILE NO. 9242  
SHEET

c:\users\mkal\documents\projectwise\workingdir\wsdot\dms22941\XL5467_03_DE_BG_BR17.7-ConstSeq.dgn									
Design Mgr:	B. BELL	RELEASE FOR CONSTRUCTION RECORD			REGION NO.	STATE	FED. AID, PROJ. NO.	SHEET NO.	TOTAL SHEETS
Designed By:	B. HU				10	WASH.			
Checked By:	M. BAUGHMAN				JOB NUMBER				
Detailed By:	J. GANASSIN				XL5467				
Current Revision By:					CONTRACT NO.				
Date:	12/21/2021				C9242				
Time:	8:07:21 AM	DESCRIPTION	DATE	NO					



Washington State  
Department of Transportation

FLATIRON LANE

wood. COWI



I-405; RENTON TO BELLEVUE WIDENING  
AND EXPRESS TOLL LANES PROJECT

BRIDGE 405/17.7 - RENTON AVE OVER I-405


CONSTRUCTION SEQUENCE

PLAN REF. NO.  
BG17.7-03  
SHEET  
OF  
SHEETS




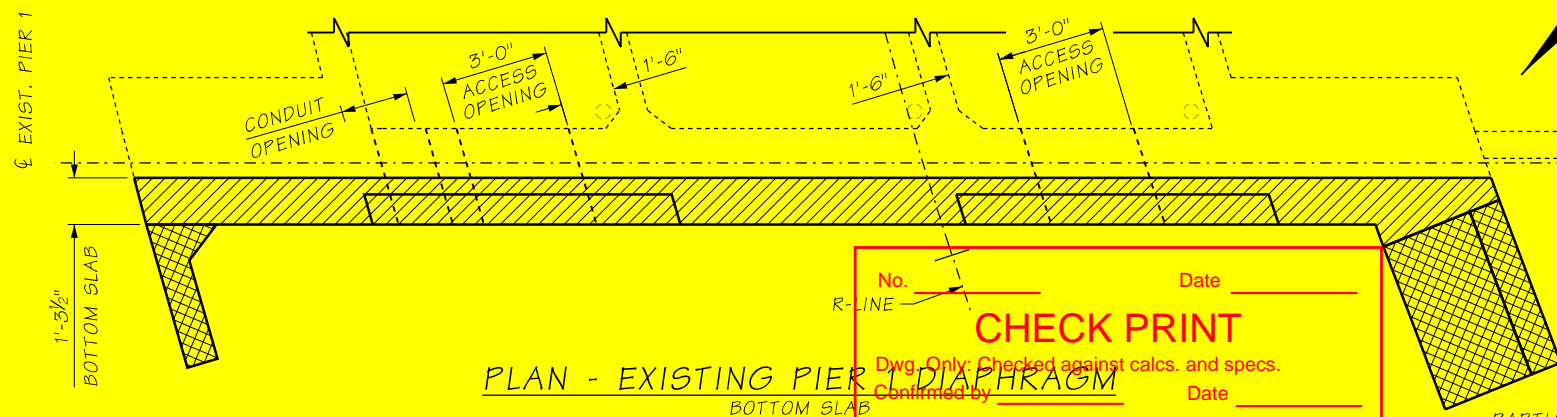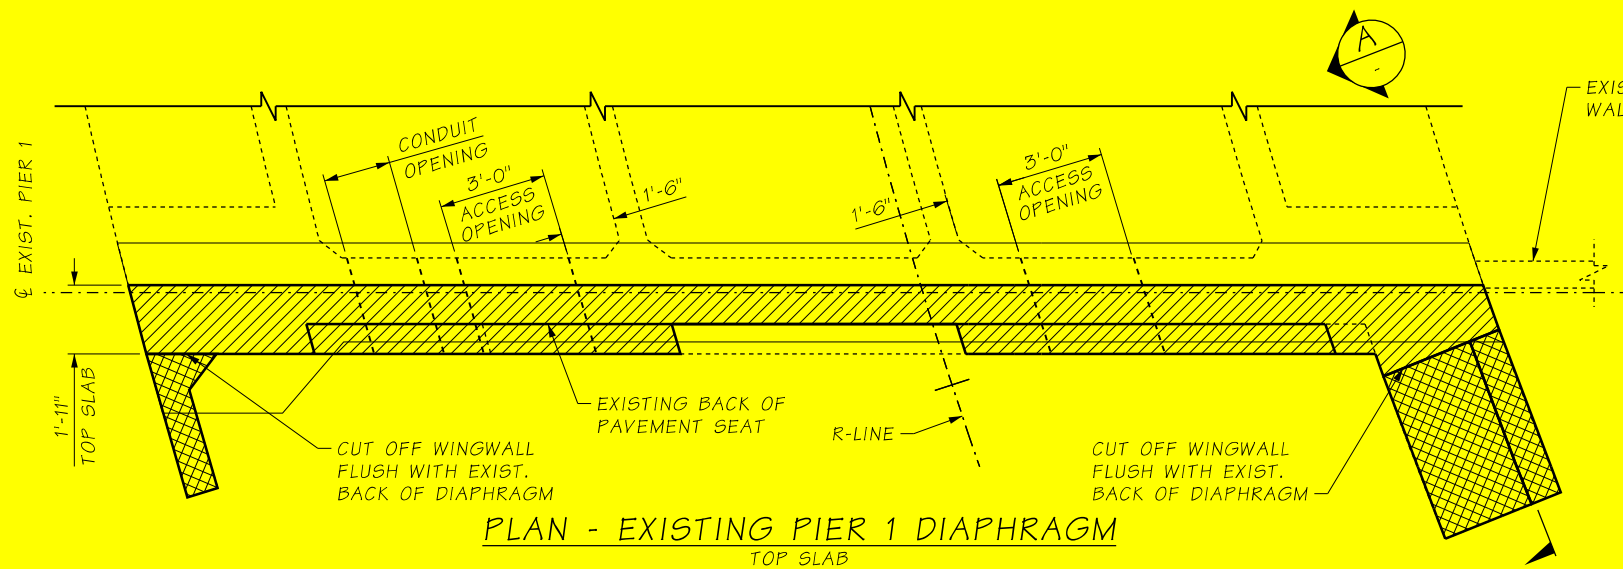

No. _____	Date _____
<b>CHECK PRINT</b>	
Dwg. Only: Checked against calcs. and specs.	
Confirmed by _____	Date _____
Originator <b>PTWL</b>	Date <b>12/21/2021</b>
Checker <b>MWBM</b>	Date <b>12/21/2021</b>
Backchecker _____	Date _____
Updater _____	Date _____
Rechecker _____	Date _____

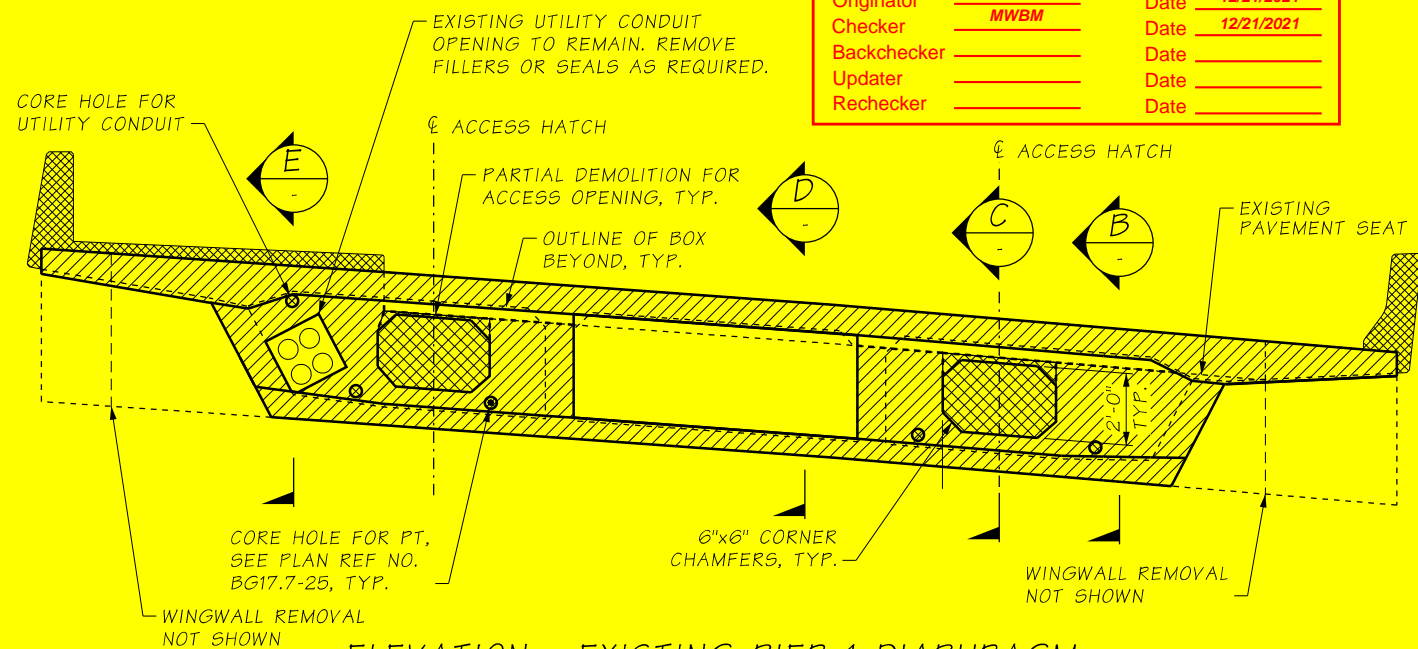

**ELEVATION - EXISTING PIER 1 DIAPHRAGM**  
LOOKING AHEAD ON STATIONING  
DIMENSIONS AND ELEVATIONS ARE ALONG CL HINGE

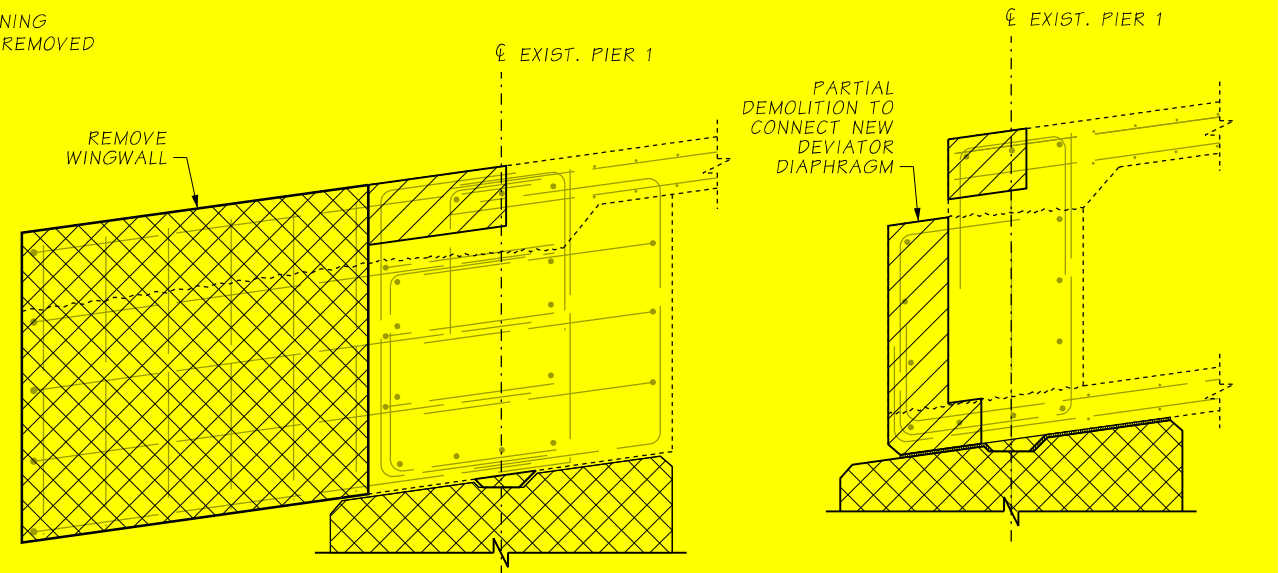


**SECTION A**

**SECTION B**


**LEGEND:**

- PARTIAL DEMOLITION, WITH REINFORCEMENT TO REMAIN
- PARTIAL DEMOLITION, WITH REINFORCEMENT REMOVED

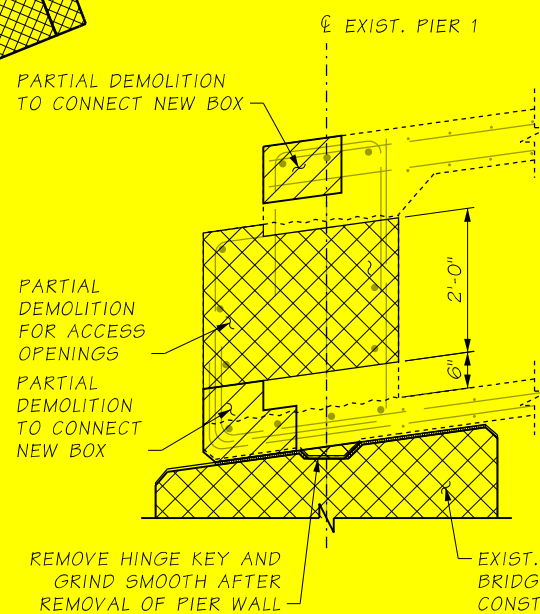


**SECTION C**

NOTE:  
CALLOUTS IN SECTION C  
APPLICABLE TO ALL SECTIONS,  
UNLESS NOTED OTHERWISE.

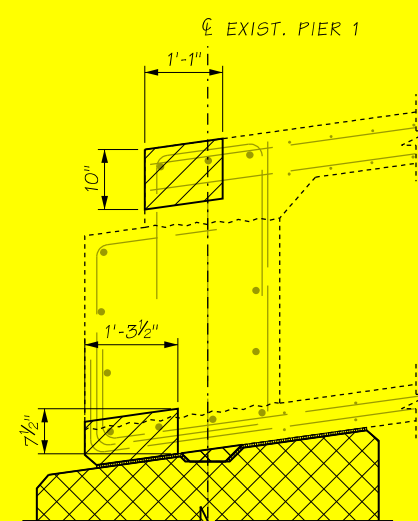


**SECTION D**

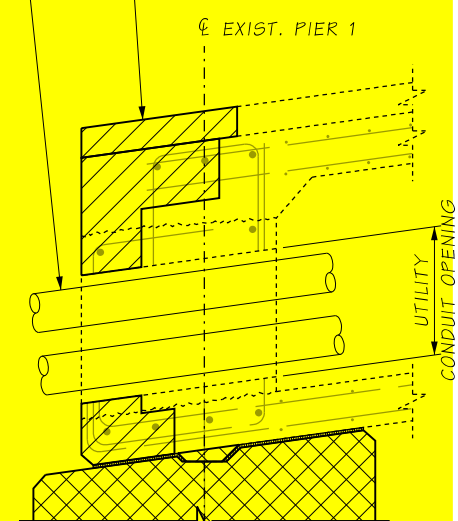

**SECTION E**

FILE NO. 9242 SHEET 1-405

c:\users\mkal\documents\projectwise\workingdir\wsdot\dms22941\XL5467_04_DE_BG_BR17.7-DemoDet.dgn		RELEASE FOR CONSTRUCTION RECORD		REGION NO.	STATE	FED. AID, PROJ. NO.	SHEET NO.	TOTAL SHEETS
Design Mgr:	B. BELL			10	WASH.			
Designed By:	B. HU							
Checked By:	M. BAUGHMAN							
Detailed By:	K. BUNGER							
Current Revision By:								
Date:	12/20/2021							
Time:	10:29:46 AM	DESCRIPTION	DATE	NO	CONTRACT NO.			
					C9242			

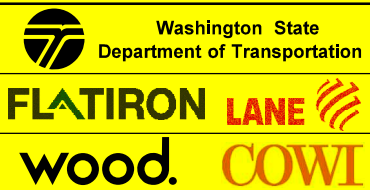







**I-405; RENTON TO BELLEVUE WIDENING  
AND EXPRESS TOLL LANES PROJECT**  
  
BRIDGE 405/17.7 - RENTON AVE OVER I-405  
  
DEMOLITION DETAILS

PLAN REF. NO.  
**BG17.7-04**  
  
SHEET  
OF  
SHEETS








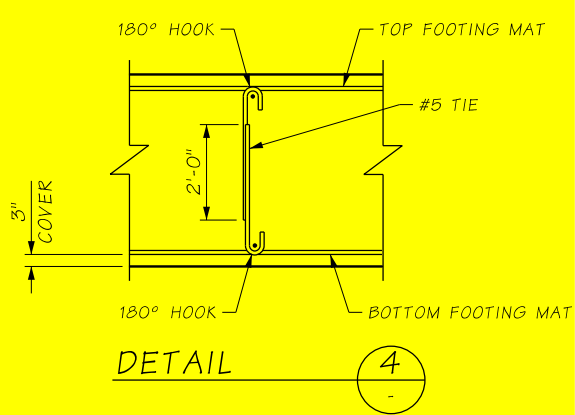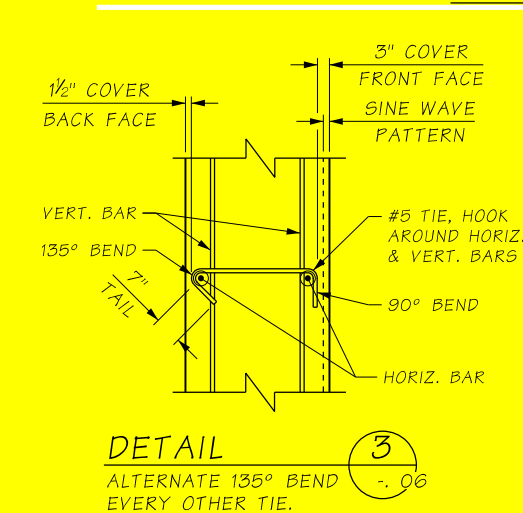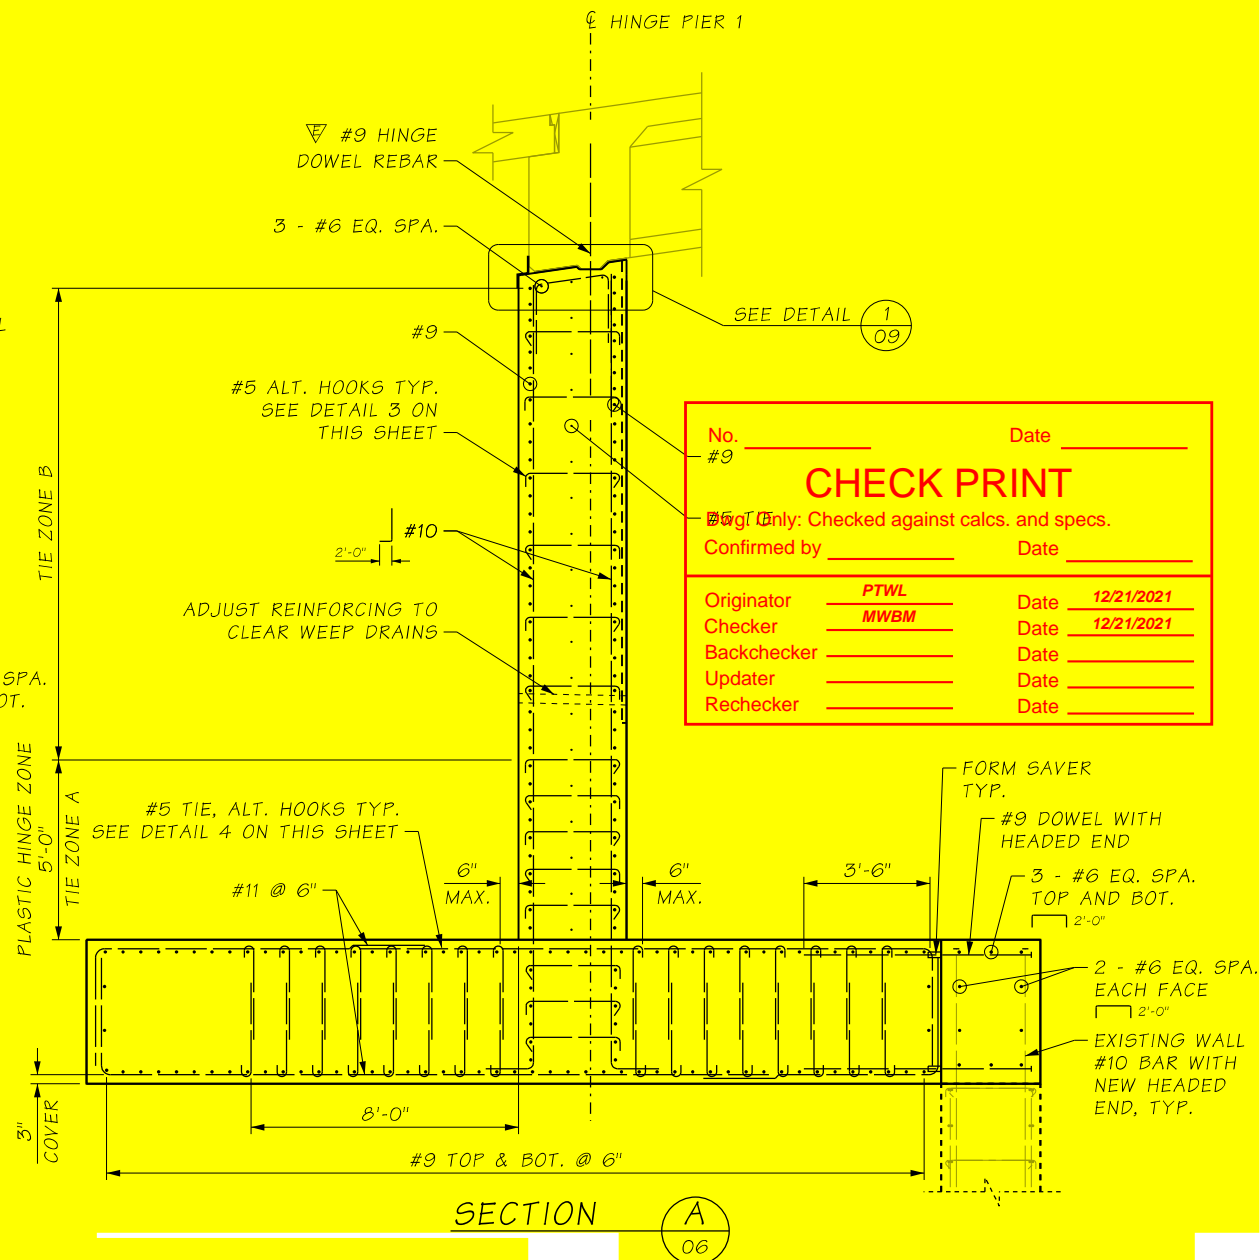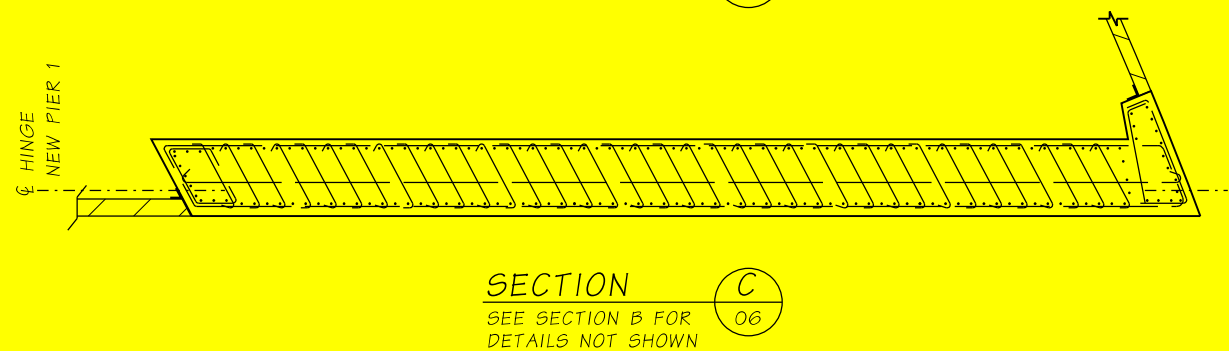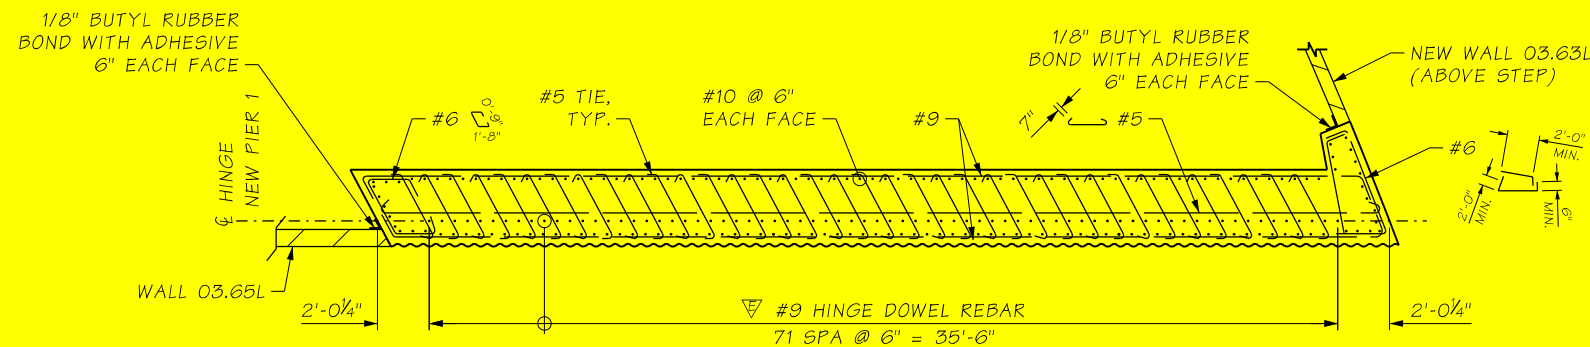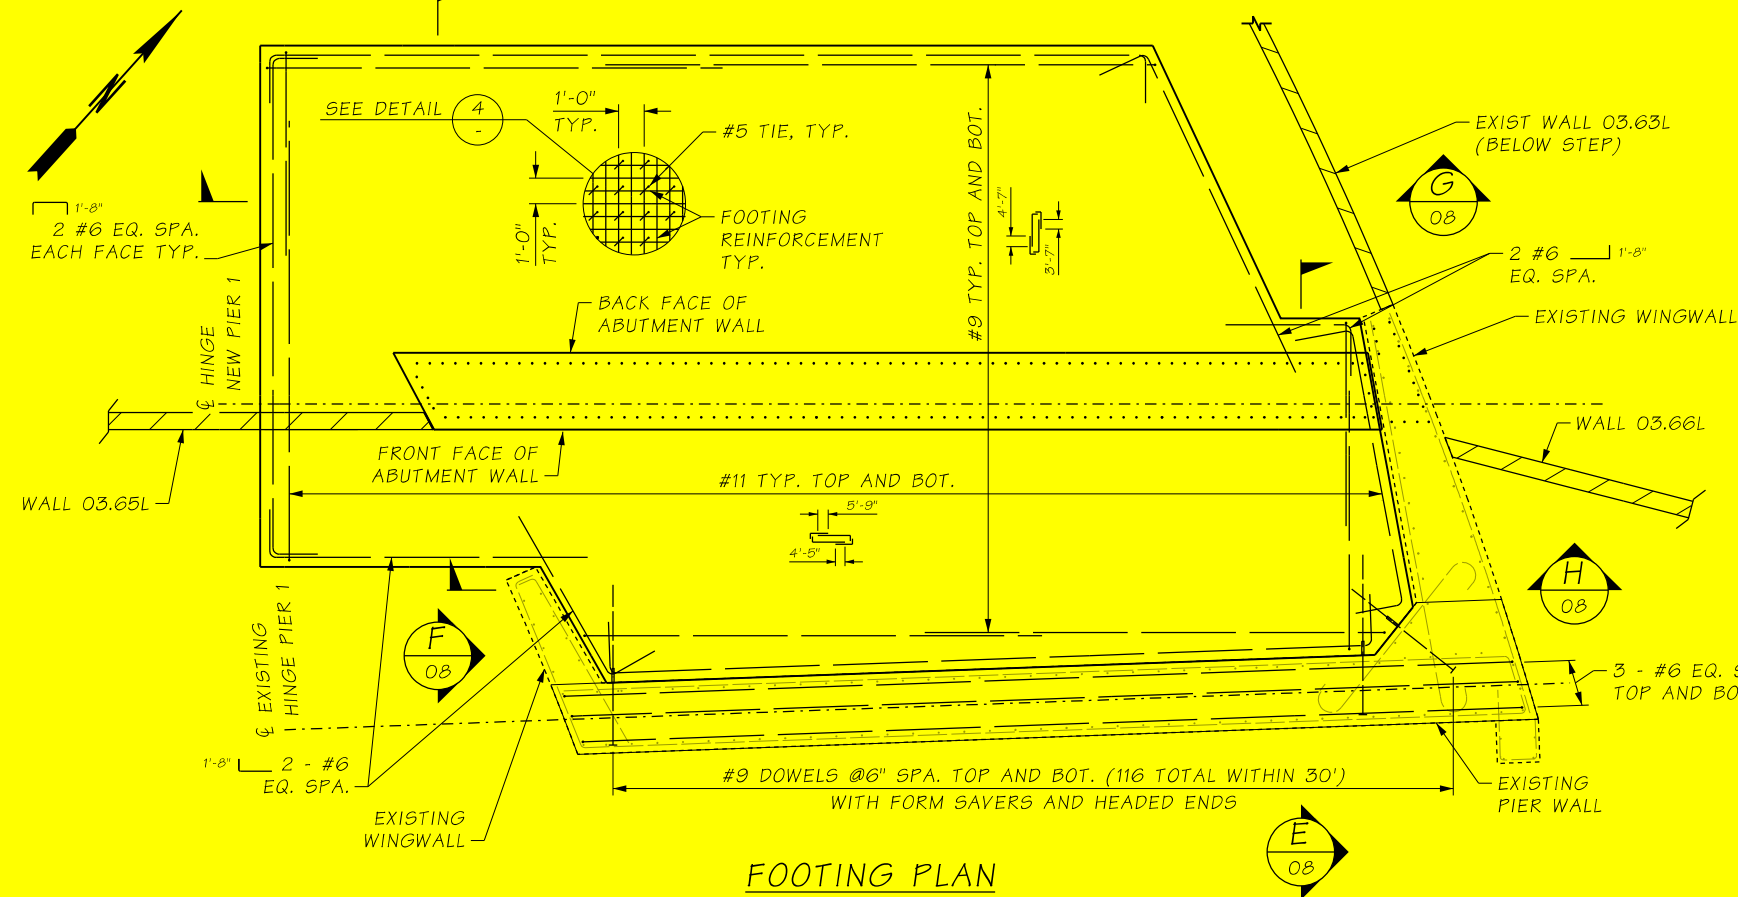

No. <u>08</u>	Date <u>12/21/2021</u>
<b>CHECK PRINT</b>	
Only: Checked against calcs. and specs.	
Confirmed by <u>PTWL</u>	Date <u>12/21/2021</u>
Originator <u>MWBM</u>	Date <u>12/21/2021</u>
Checker <u></u>	Date <u></u>
Backchecker <u></u>	Date <u></u>
Updater <u></u>	Date <u></u>
Rechecker <u></u>	Date <u></u>

c:\users\mkal\documents\projectwise\workingdir\wsdot\dms22941\XL5467_07_DE_BG_BR17.7-Pier1Det1.dgn				RELEASE FOR CONSTRUCTION RECORD			
Design Mgr:	B. BELL	REGION NO.	10	STATE	WASH.	FED. AID. PROJ. NO.	
Designed By:	R. GARG	JOB NUMBER	XL5467				
Checked By:	M. BAUGHMAN	CONTRACT NO.	C9242				
Detailed By:	J. GANASSIN						
Current Revision By:							
Date:	12/20/2021						
Time:	10:45:02 AM	DESCRIPTION	DATE	NO			

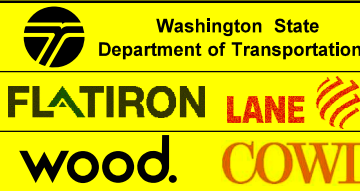

**I-405; RENTON TO BELLEVUE WIDENING AND EXPRESS TOLL LANES PROJECT**



**BRIDGE 405/17.7 - RENTON AVE OVER I-405**

**PIER 1**



**DETAILS 1 OF 3**

PLAN REF. NO. **BG17.7-07**

SHEET **OF** SHEETS

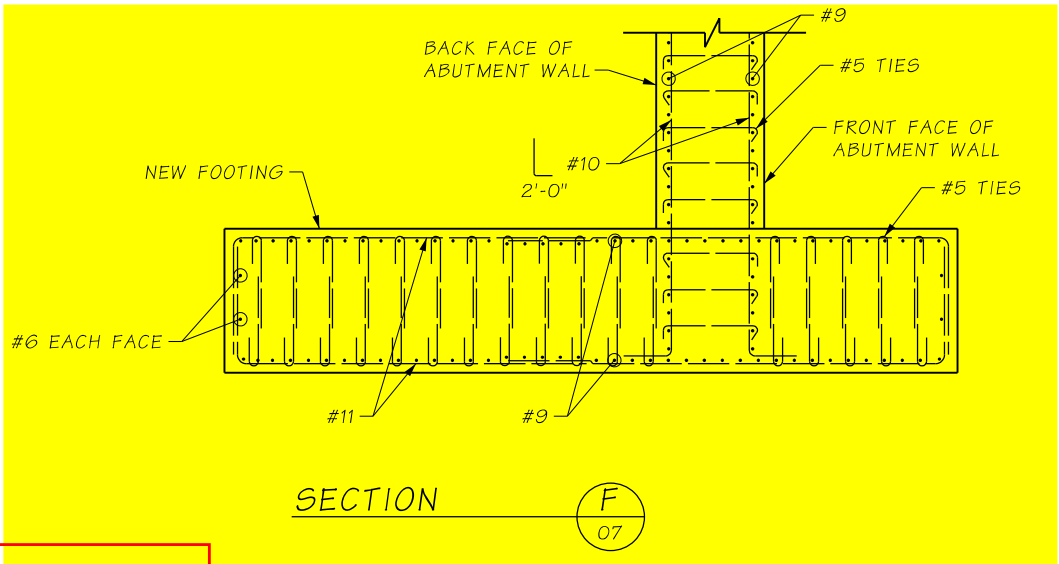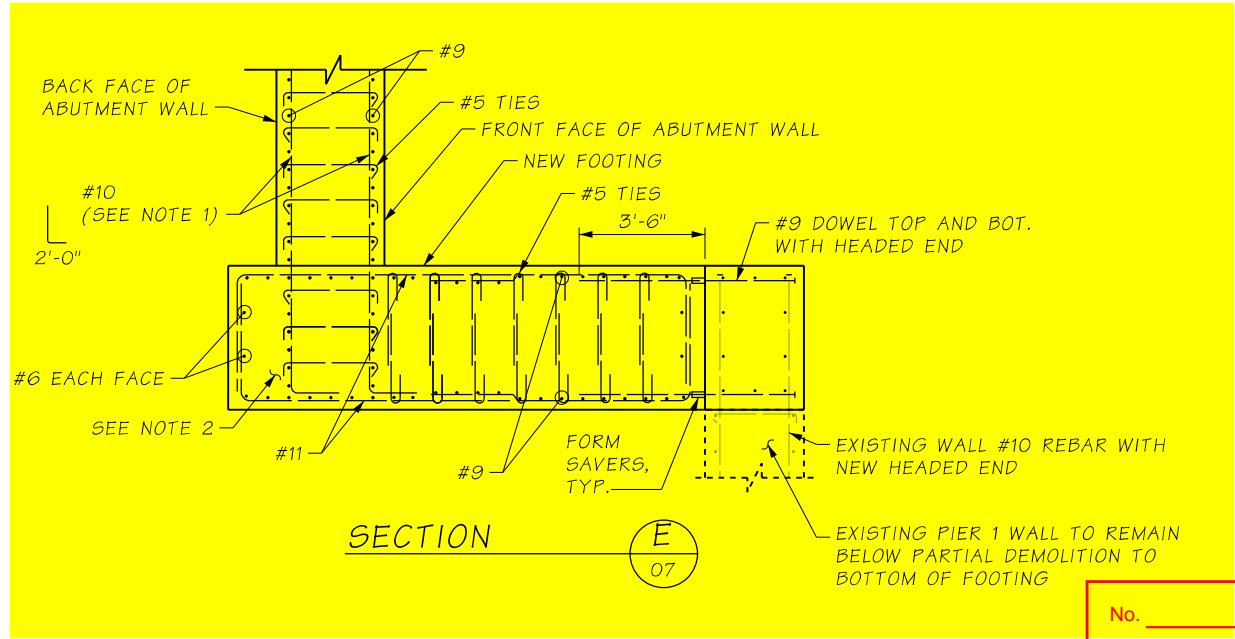

No. _____	Date _____
<b>CHECK PRINT</b>	
Dwg. Only: Checked against calcs. and specs.	
Confirmed by _____	Date _____
Originator _____	Date _____
Checker _____	Date _____
Backchecker _____	Date _____
Updater _____	Date _____
Rechecker _____	Date _____

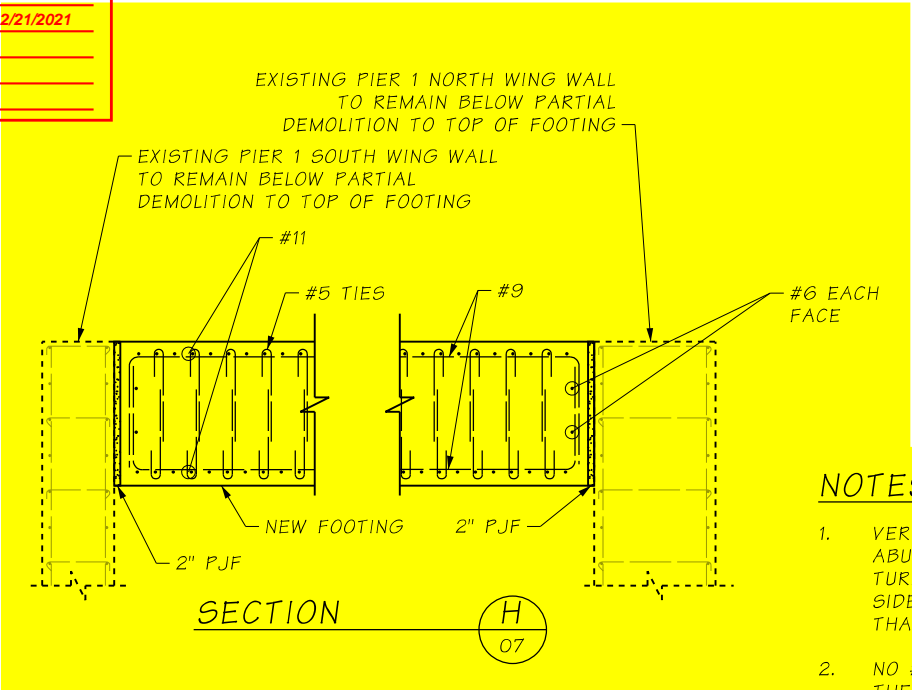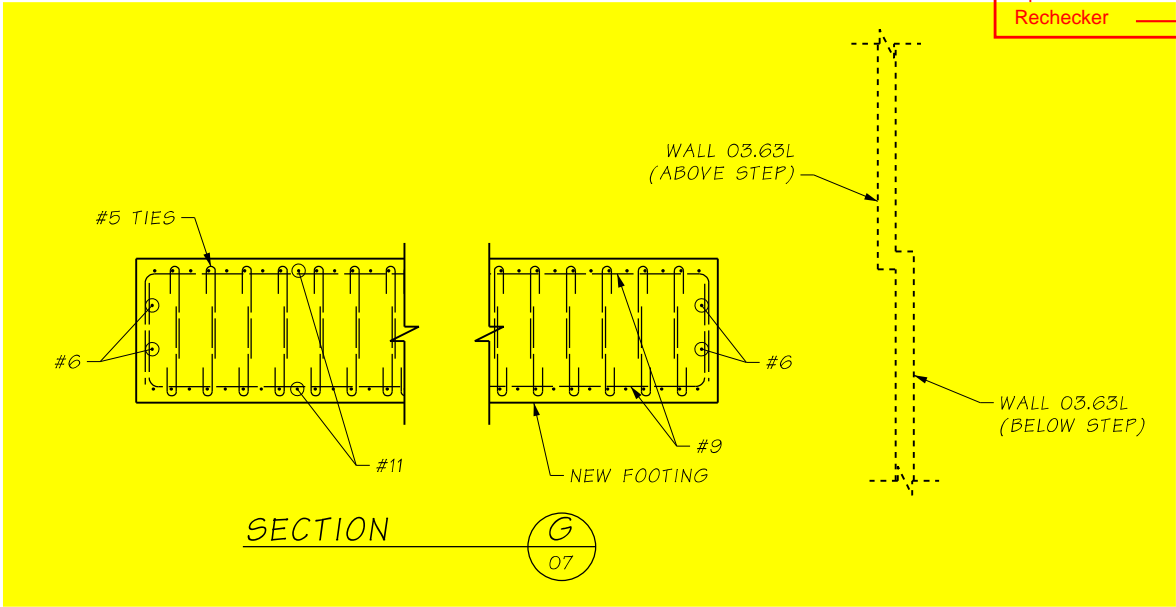

- NOTES:**
- VERTICAL REBAR IN THE BACK OF ABUTMENT WALL TO HAVE THE 90° HOOK TURNED TOWARDS THE TOE SIDE (I405 SIDE) WHERE THE FOOTING HEEL IS LESS THAN 2 FT IN LENGTH.
  - NO #5 TIES ARE REQUIRED IN THE HEEL OF THE FOOTING WHERE THE FOOTING HEEL IS LESS THAN 2 FT IN LENGTH.
  - PARTIAL DEMOLITION OF EXISTING ABUTMENT WALL AND WINGWALLS SHALL BE IN ACCORDANCE WITH STD. SPEC. 2-02.3(2)A2.

I-405  
FILE NO. 9242  
SHEET

c:\users\mkal\documents\projectwise\workingdir\wsdot\dms22941\XL5467_08_DE_BG_BR17.7-Pier1Det2.dgn									
Design Mgr:	B. BELL	RELEASE FOR CONSTRUCTION RECORD			REGION NO.	STATE	FED. AID, PROJ. NO.	SHEET NO.	TOTAL SHEETS
Designed By:	R. GARG				10	WASH.			
Checked By:	M. BAUGHMAN				JOB NUMBER				
Detailed By:	J. GANASSIN				XL5467				
Current Revision By:					CONTRACT NO.				
Date:	12/16/2021				C9242				
Time:	2:41:50 PM	DESCRIPTION	DATE	NO					



DATE

E.O.R. 1 STAMP BOX

DATE



Washington State  
Department of Transportation

FLATIRON LANE

wood. COWI

I-405; RENTON TO BELLEVUE WIDENING  
AND EXPRESS TOLL LANES PROJECT

BRIDGE 405/17.7 - RENTON AVE OVER I-405

PIER 1  
DETAILS 2 OF 3

PLAN REF. NO.





BG17.7-08

SHEET

OF



SHEETS



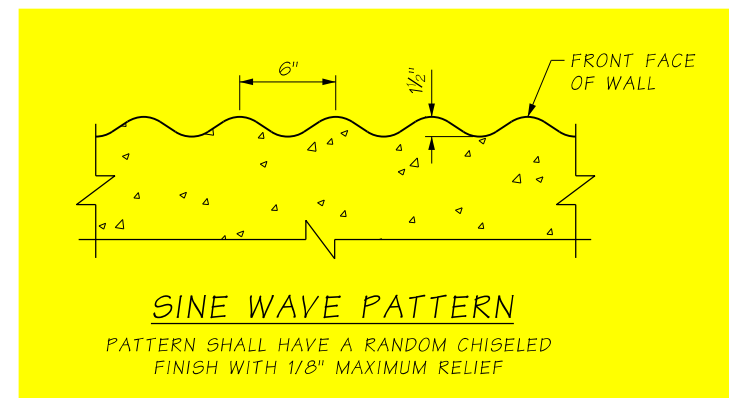
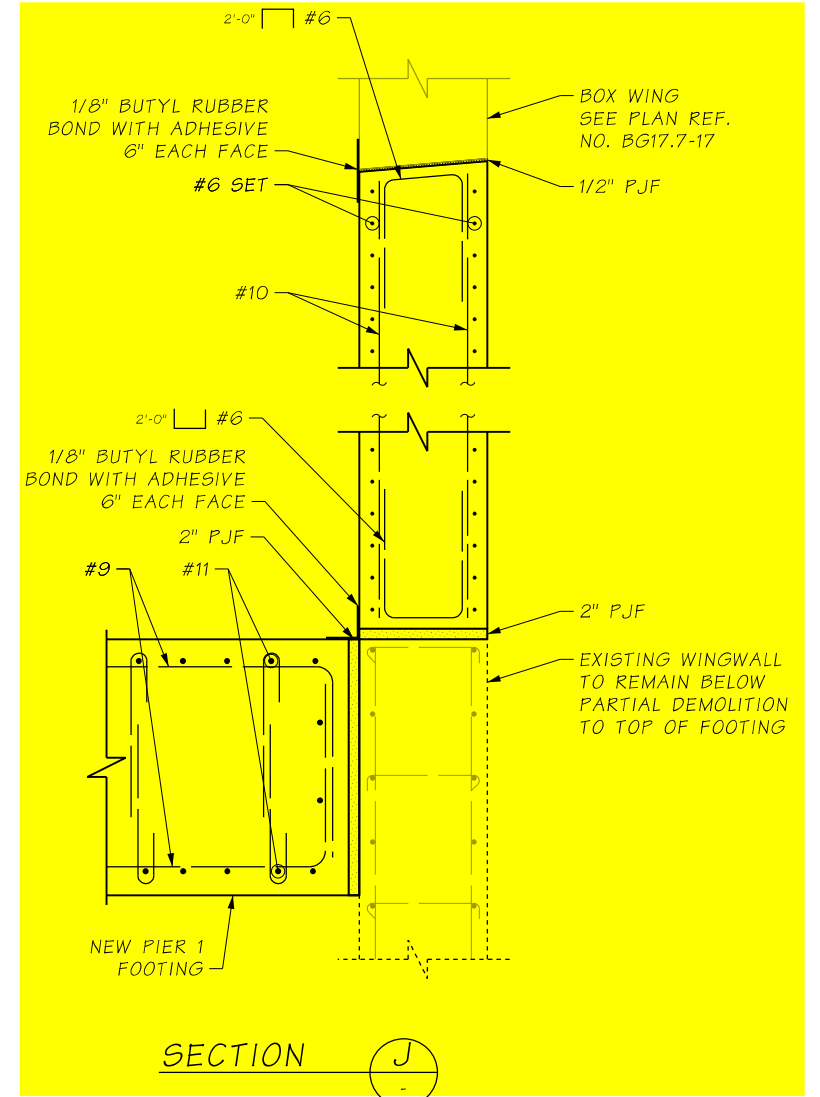
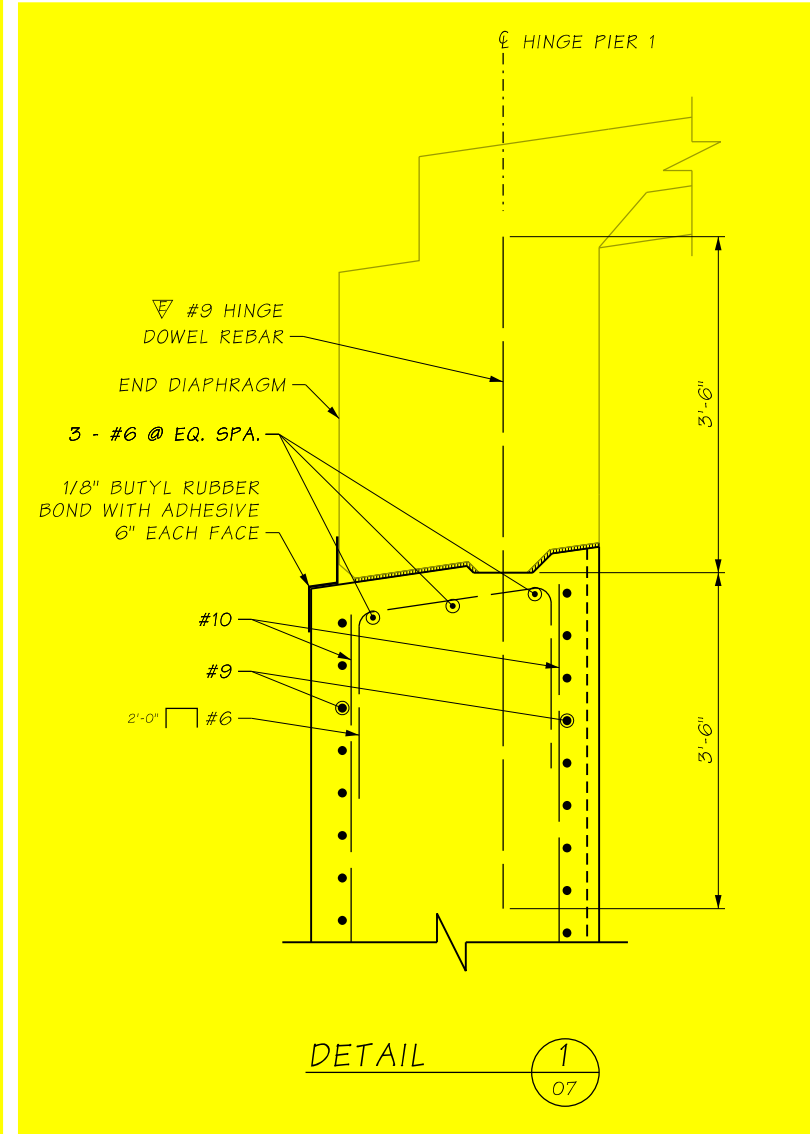
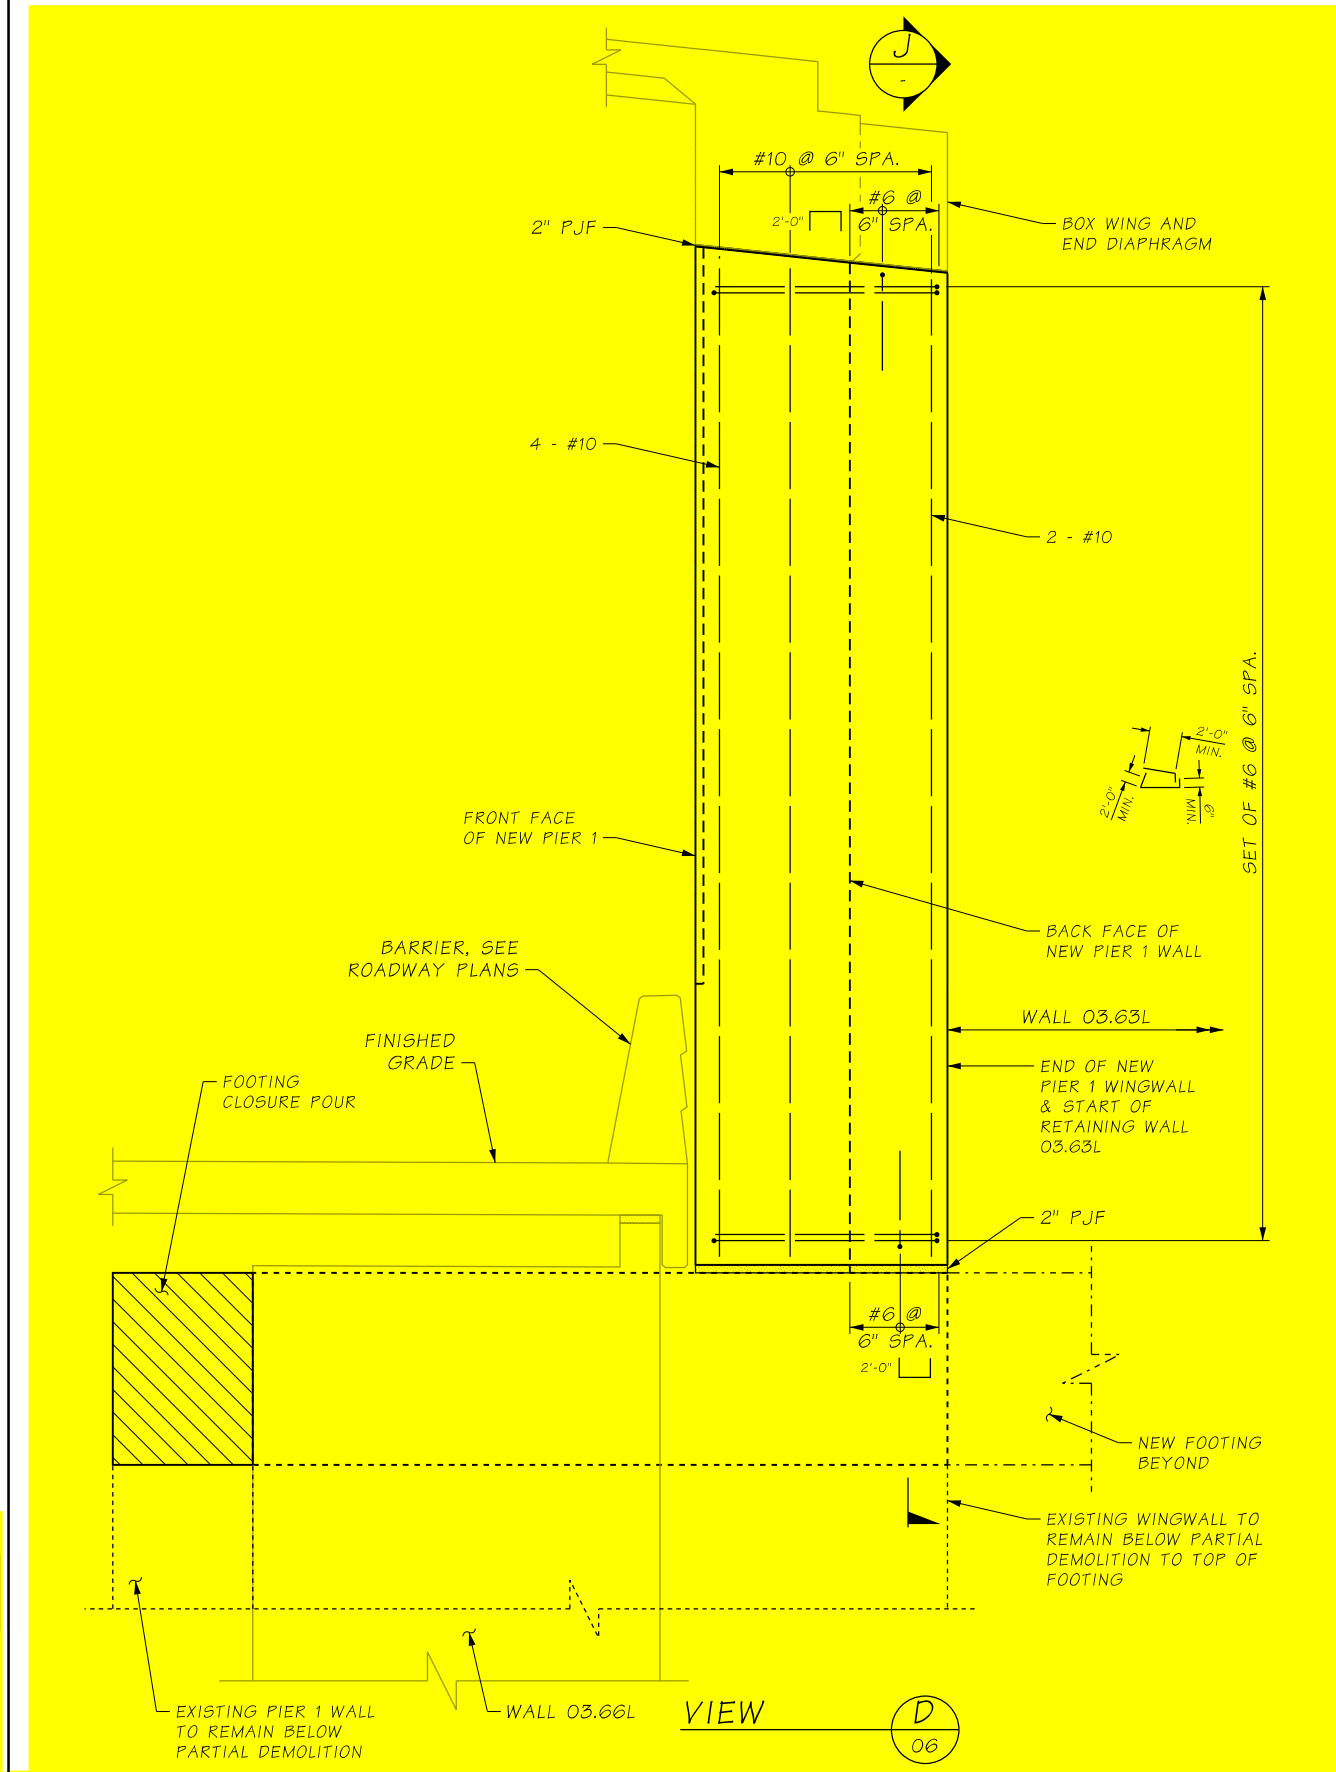


No. _____	Date _____
<b>CHECK PRINT</b>	
Dwg. Only: Checked against calcs. and specs.	
Confirmed by _____	Date _____
Originator <u>PTWL</u>	Date <u>12/21/2021</u>
Checker <u>MWBM</u>	Date <u>12/21/2021</u>
Backchecker _____	Date _____
Updater _____	Date _____
Rechecker _____	Date _____


c:\users\mkal\documents\projectwise\workingdir\wsdot\dms22941\XL5467_09_DE_BG_BR17.7-Pier1Det3.dgn				RELEASE FOR CONSTRUCTION RECORD		REGION NO.		STATE		FED. AID, PROJ. NO.		SHEET NO.		TOTAL SHEETS	
Design Mgr:	B. BELL					10		WASH.							
Designed By:	R. GARG														
Checked By:	M. BAUGHMAN														
Detailed By:	J. MILNE														
Current Revision By:															
Date:	12/20/2021														
Time:	10:48:05 AM														
DESCRIPTION				DATE	NO	JOB NUMBER		CONTRACT NO.		C9242					

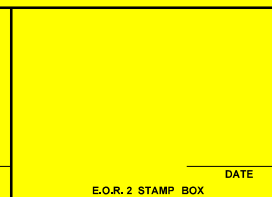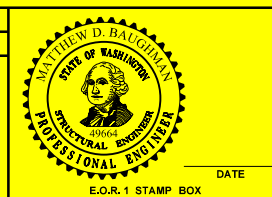

I-405; RENTON TO BELLEVUE WIDENING AND EXPRESS TOLL LANES PROJECT		PLAN REF. NO. BG17.7-09
BRIDGE 405/17.7 - RENTON AVE OVER I-405		SHEET OF SHEETS
PIER 1 DETAILS 3 OF 3		

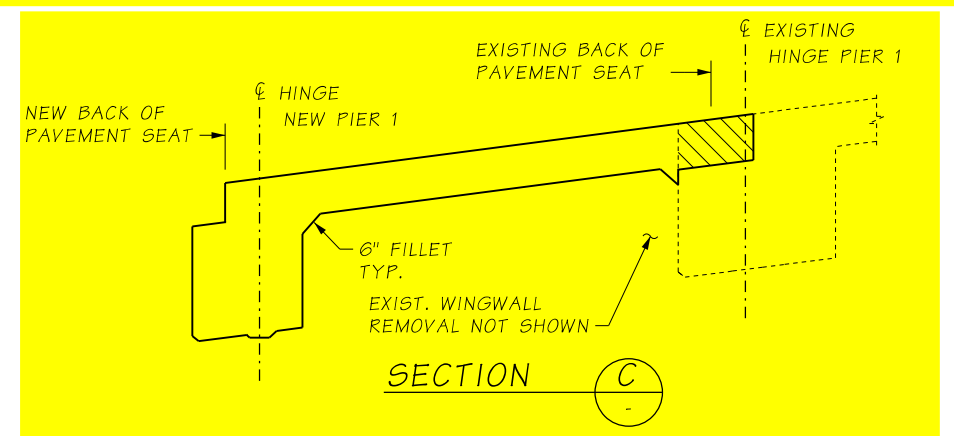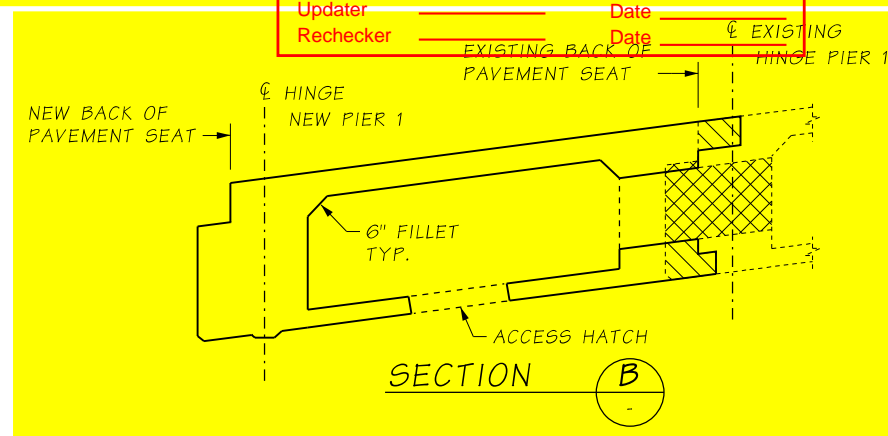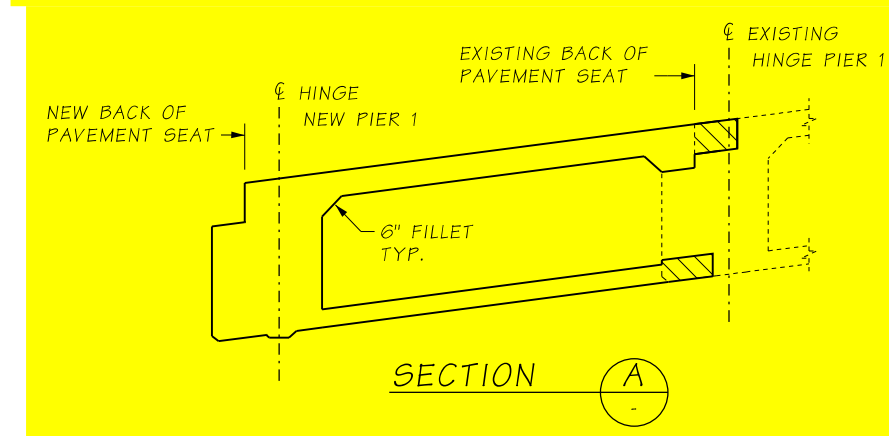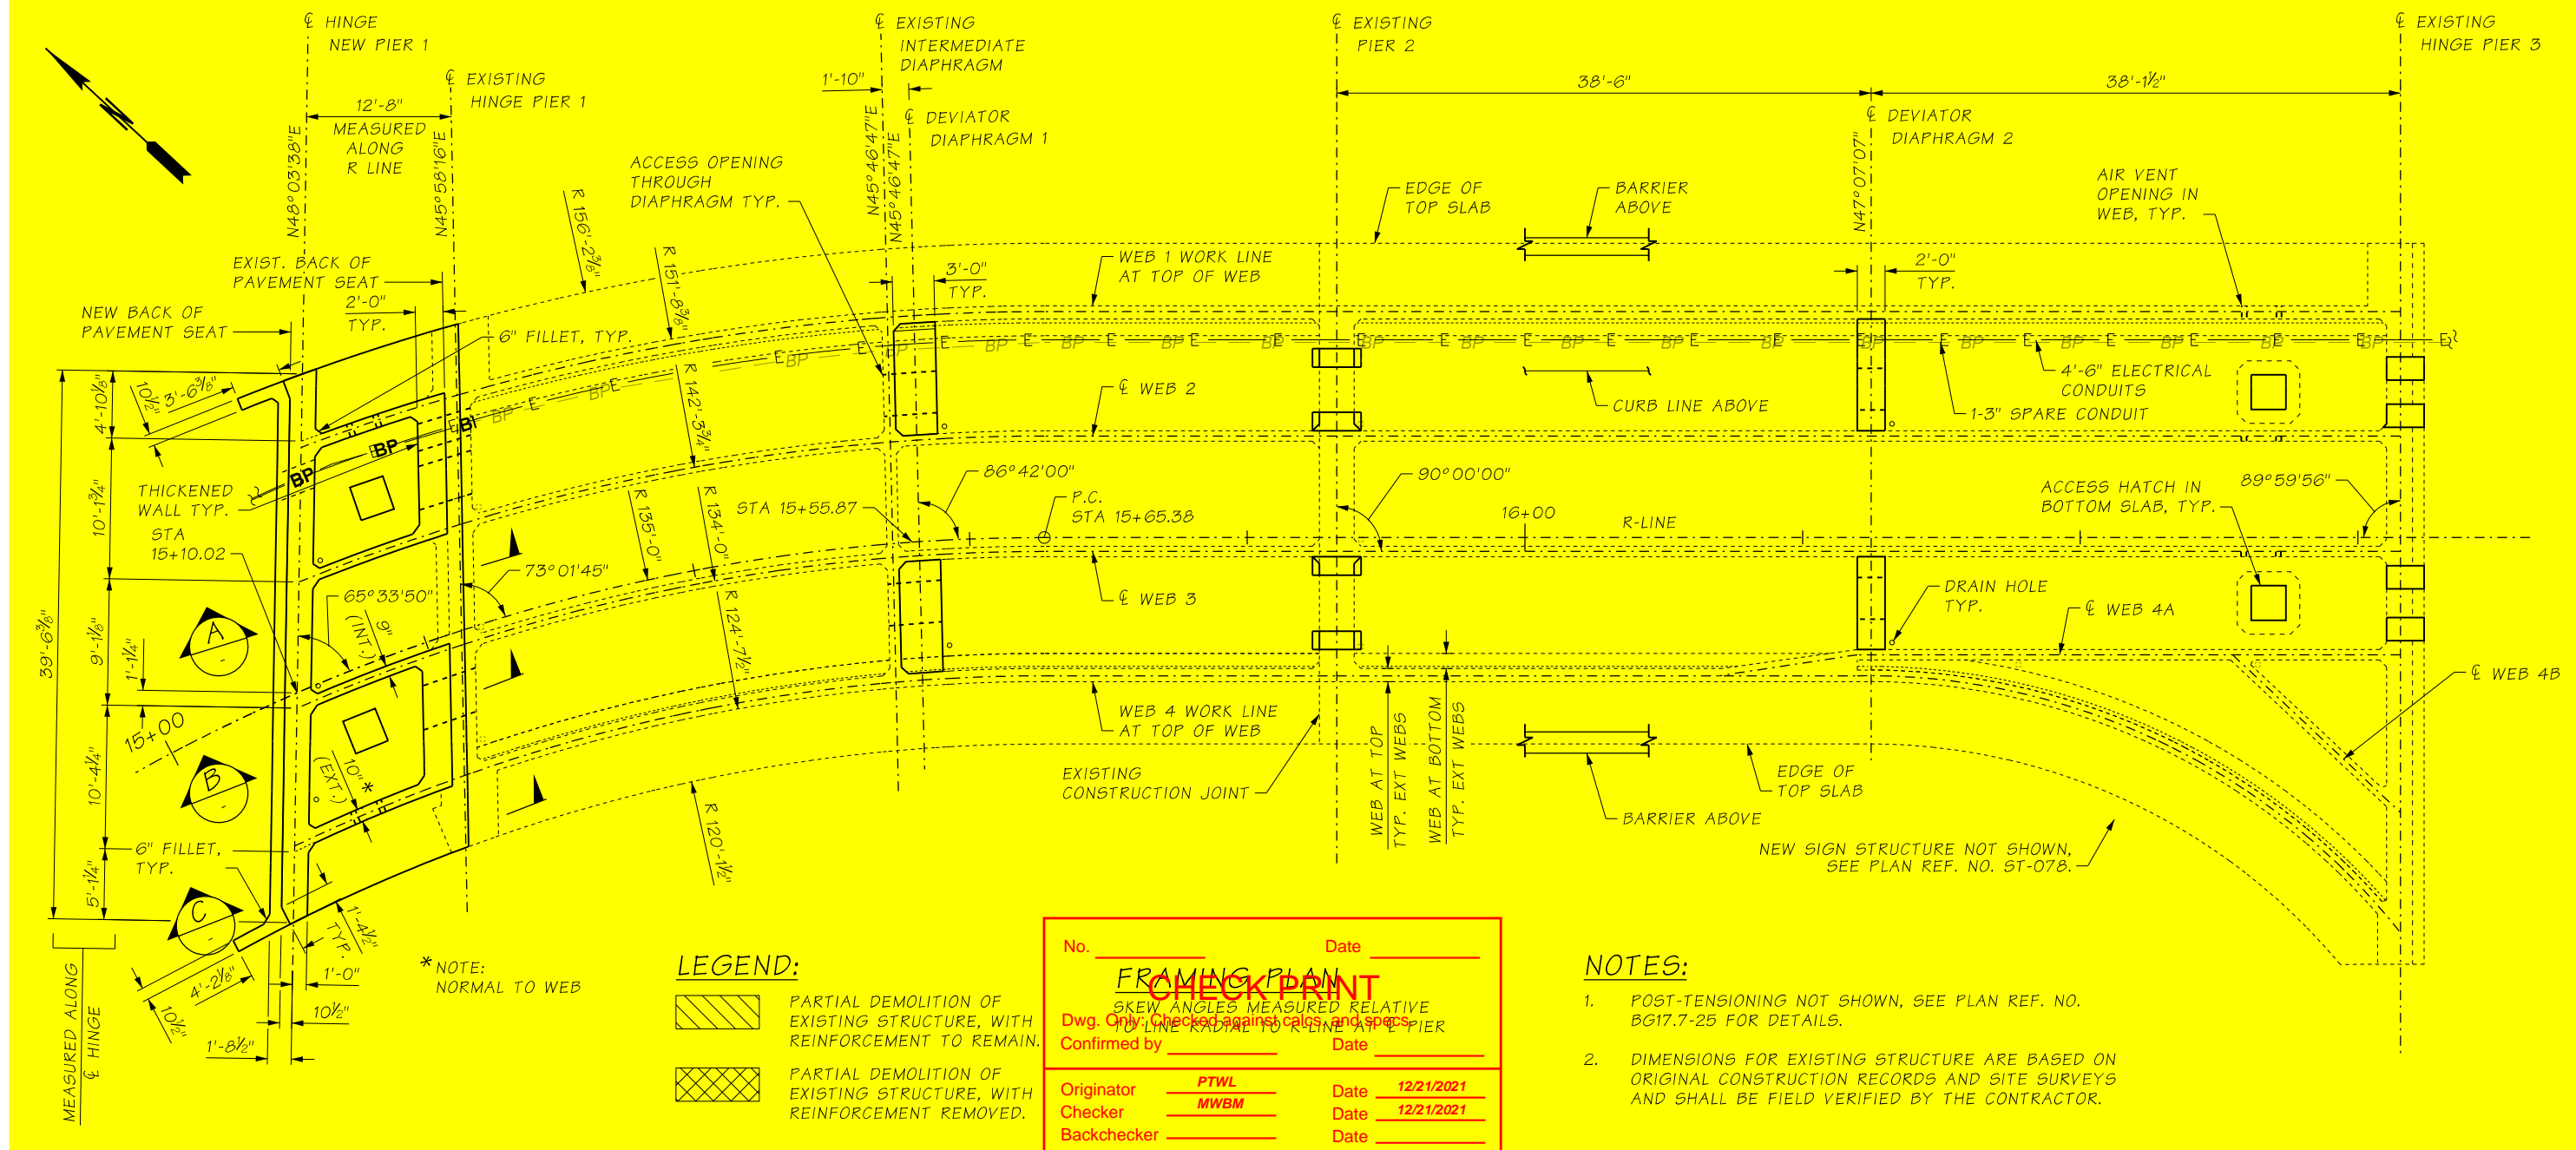

c:\users\jagn\documents\projectwise\workingdir\wsdot\dms22941\XL5467_10_DE_BG_BR17.7-FramePlan.dgn			
Design Mgr:	B. BELL	RELEASE FOR CONSTRUCTION RECORD	
Designed By:	B. HU	REGION NO.	STATE
Checked By:	M. BAUGHMAN	10	WASH.
Detailed By:	J. GANASSIN	JOB NUMBER	
Current Revision By:		XL5467	
Date:	12/15/2021	CONTRACT NO.	
Time:	4:04:05 PM	C9242	
DESCRIPTION		DATE	NO

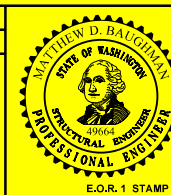


DATE

E.O.R. 1 STAMP BOX

DATE

E.O.R. 2 STAMP BOX

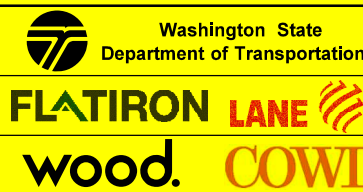


**I-405; RENTON TO BELLEVUE WIDENING AND EXPRESS TOLL LANES PROJECT**

**BRIDGE 405/17.7 - RENTON AVE OVER I-405**

**FRAMING PLAN**

PLAN REF. NO.  
**BG17.7-10**  
SHEET  
OF  
SHEETS

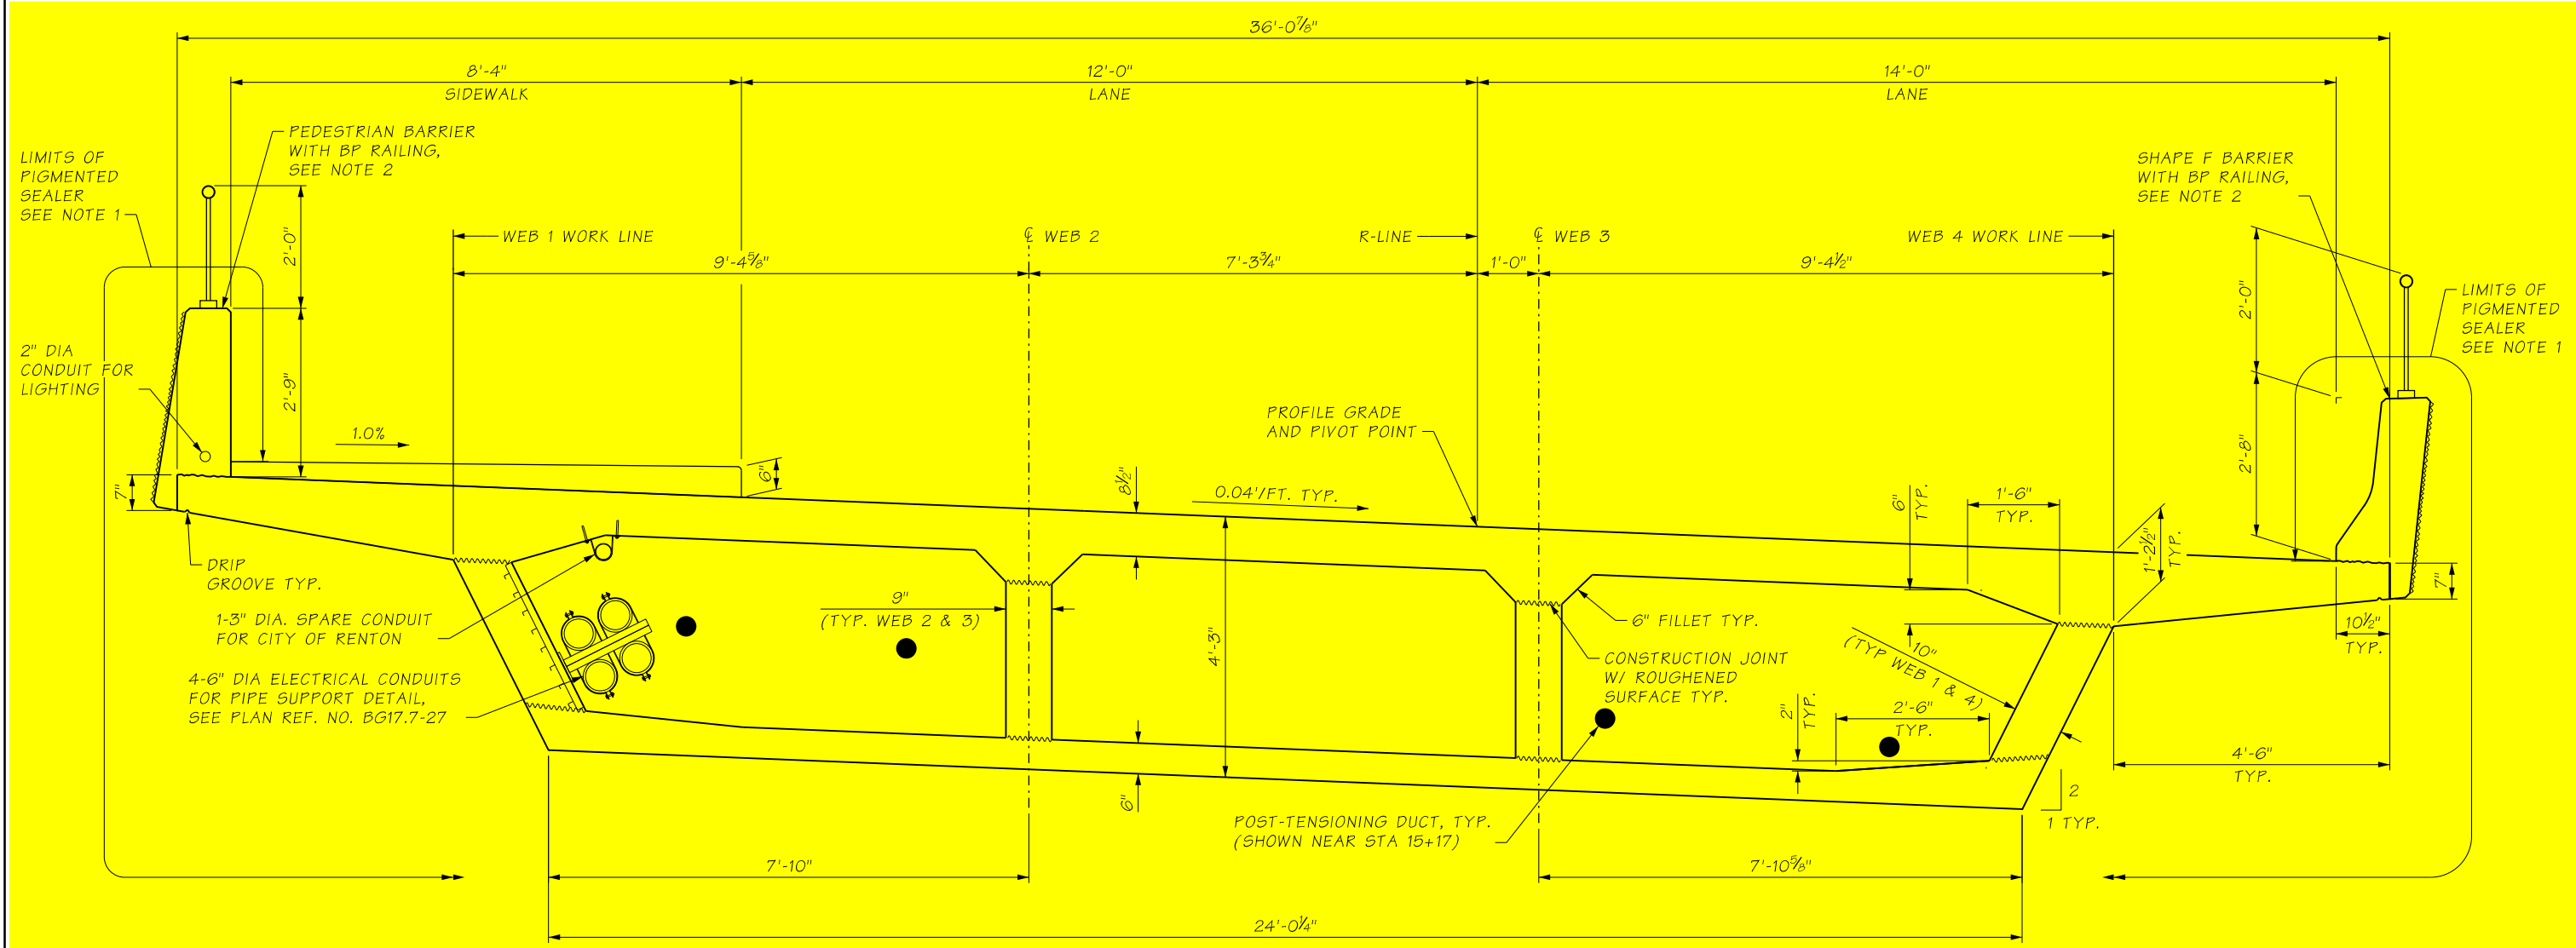

TYPICAL SECTION  
(LOOKING UP ON STATION)  
(DIMENSIONS SHOWN ARE PERPENDICULAR TO BASELINE)

No. \_\_\_\_\_ Date \_\_\_\_\_

CHECK PRINT

Dwg. Only: Checked against calcs. and specs.

Confirmed by \_\_\_\_\_ Date \_\_\_\_\_

Originator PTWL Date 12/21/2021

Checker MWBM Date 12/21/2021

Backchecker \_\_\_\_\_ Date \_\_\_\_\_

Updater \_\_\_\_\_ Date \_\_\_\_\_

Rechecker \_\_\_\_\_ Date \_\_\_\_\_

- NOTES:
- PIGMENTED SEALER SHALL BE APPLIED TO NEW PORTION OF BOX GIRDER AS SHOWN. COLOR SHALL BE MT. ST. HELENS. SEALER LIMITS SHALL EXTEND TO FRONT FACE OF EXISTING PIER 1.
  - EXTERIOR FACES OF PEDESTRIAN BARRIER AND SHAPE F BARRIER SHALL HAVE FRACTURED FIN FINISH TO MATCH EXISTING.
  - BRIDGE DECK TEXTURING FOR ROADWAY SHALL BE IN THE TRANSVERSE DIRECTION TO MATCH EXISTING BRIDGE DECK TO REMAIN, AND IN ACCORDANCE WITH SECTION 6-02.3(10)D5 OF THE WSDOT STANDARD SPECIFICATIONS.
  - FOR BRIDGE DECK FINISH UNDER SIDEWALK, SEE PLAN REF. NO. BG17.7-28.
  - BOX GEOMETRY IS TO MATCH EXISTING, CONTRACTOR TO FIELD VERIFY.

I-405 FILE NO. 9242 SHEET

c:\users\mkal\documents\projectwise\workingdir\wsdot\dms22941\XL5467_11_DE_BG_BR17.7-TypSect.dgn					
Design Mgr:	B. BELL	RELEASE FOR CONSTRUCTION RECORD		REGION NO.	STATE
Designed By:	B. HU			10	WASH.
Checked By:	M. BAUGHMAN			JOB NUMBER	
Detailed By:	J. GANASSIN			XL5467	
Current Revision By:				CONTRACT NO.	
Date:	12/6/2021			C9242	
Time:	4:16:52 PM	DESCRIPTION	DATE	NO	




E.O.R. 2 STAMP BOX




FLATIRON LANE  
wood. COWI

I-405; RENTON TO BELLEVUE WIDENING AND EXPRESS TOLL LANES PROJECT		PLAN REF. NO. BG17.7-11
BRIDGE 405/17.7 - RENTON AVE OVER I-405		SHEET OF SHEETS
TYPICAL SECTION		

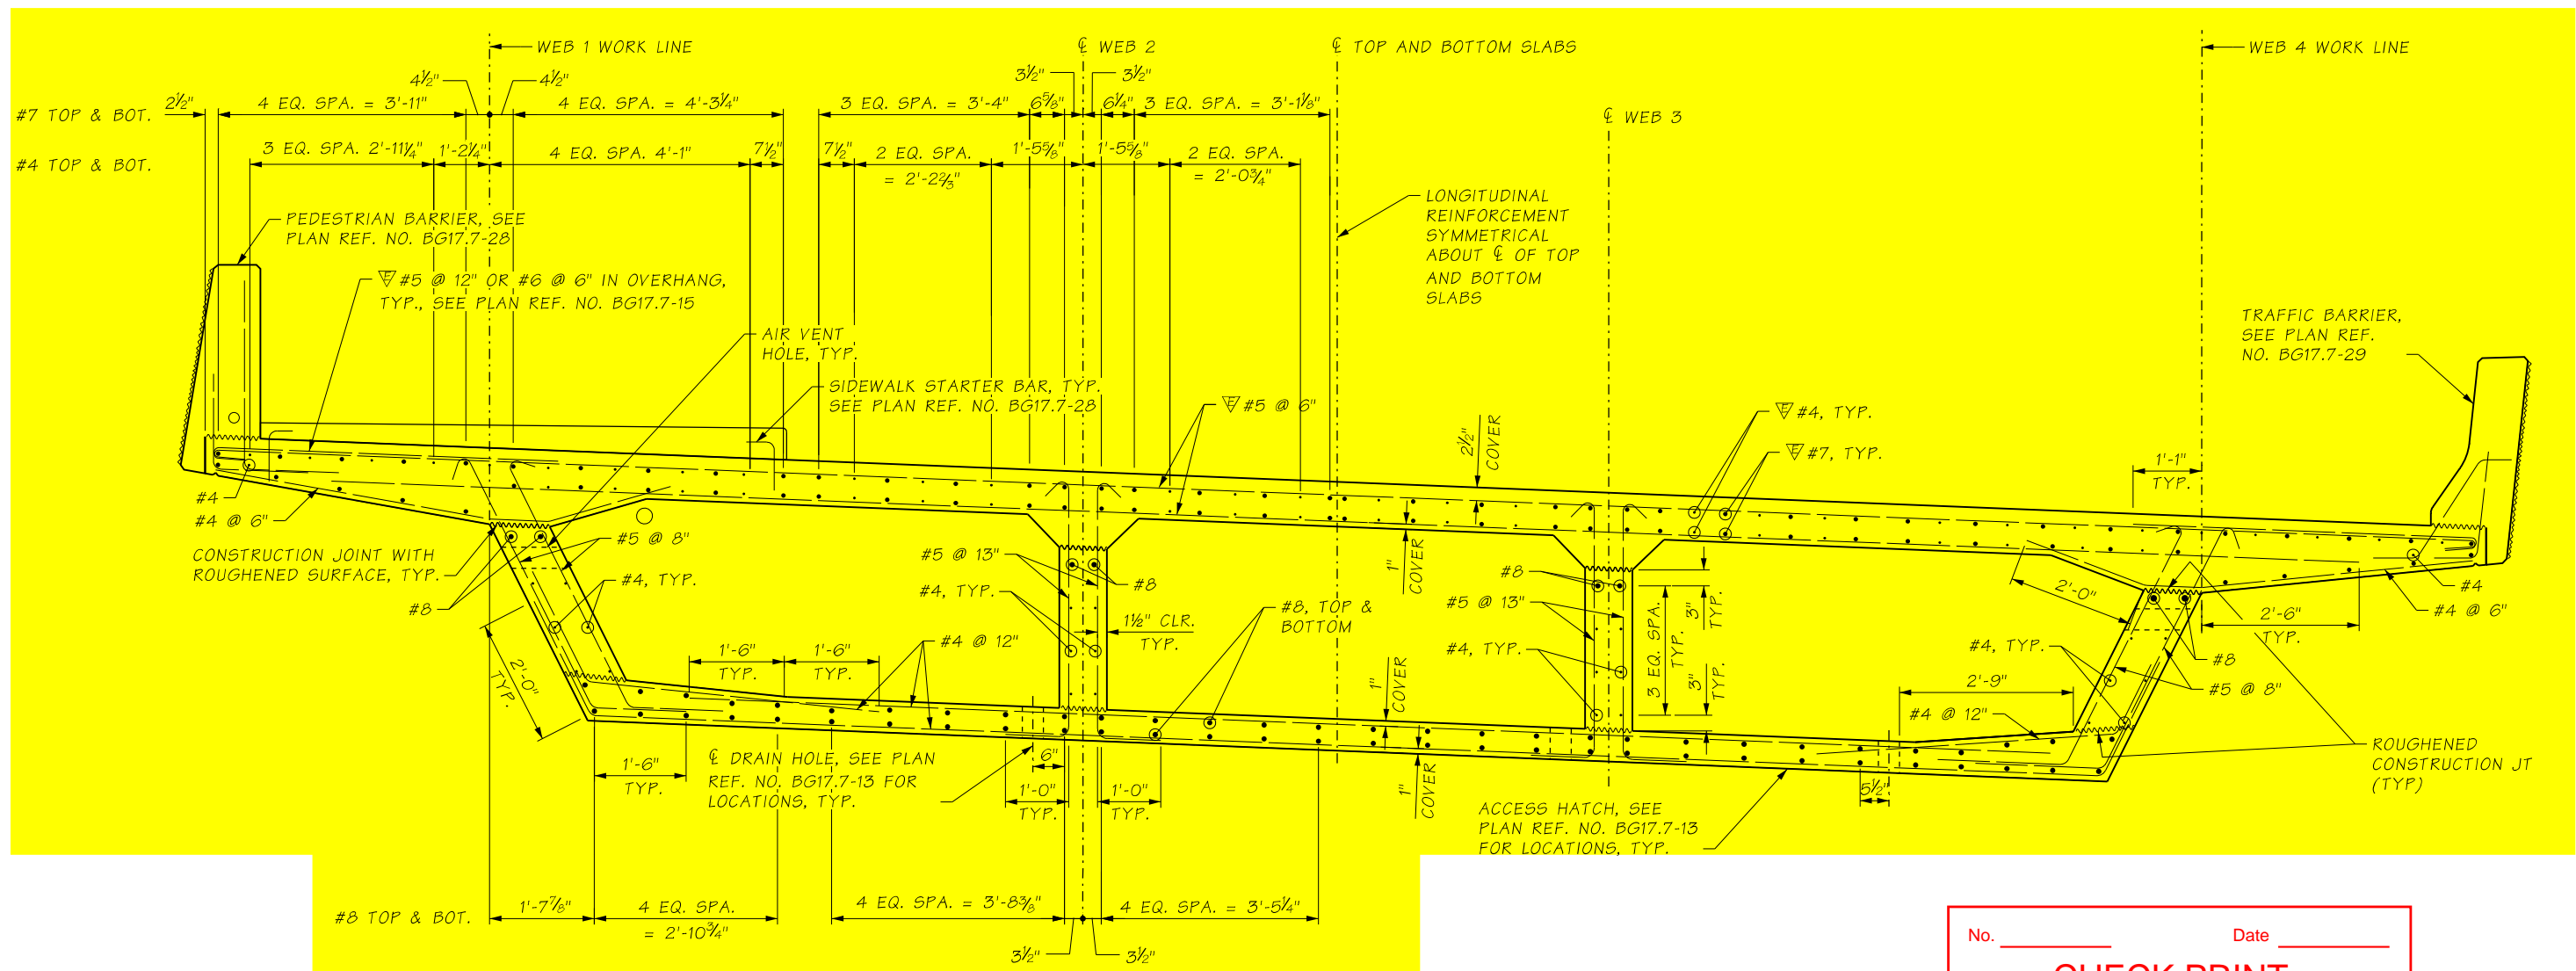


**TYPICAL SECTION - REINFORCEMENT**  
(LOOKING UP ON STATION)  
(DIMENSIONS SHOWN ARE PERPENDICULAR TO R-LINE)


No. _____	Date _____
<b>CHECK PRINT</b>	
Dwg. Only: Checked against calcs. and specs.	
Confirmed by _____	Date _____
Originator <u>PTWL</u>	Date <u>12/21/2021</u>
Checker <u>MWBM</u>	Date <u>12/21/2021</u>
Backchecker _____	Date _____
Updater _____	Date _____
Rechecker _____	Date _____

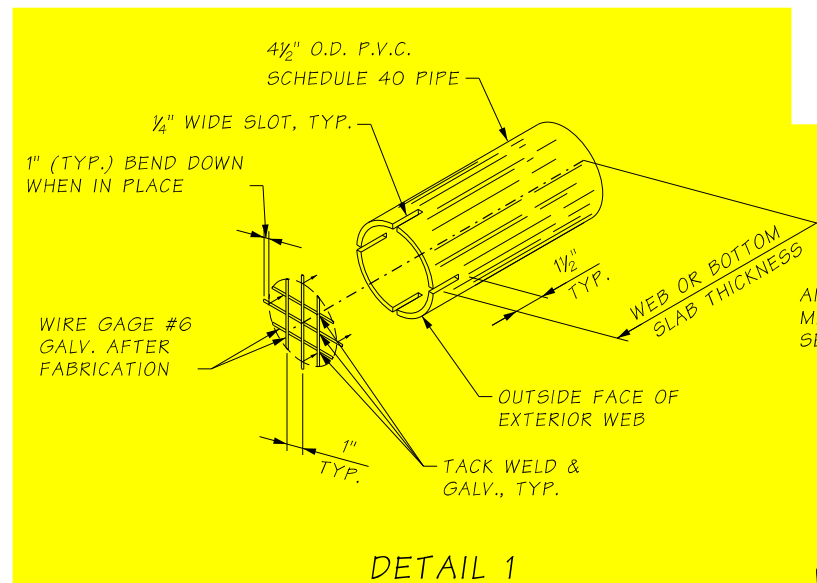

**DETAIL 1**

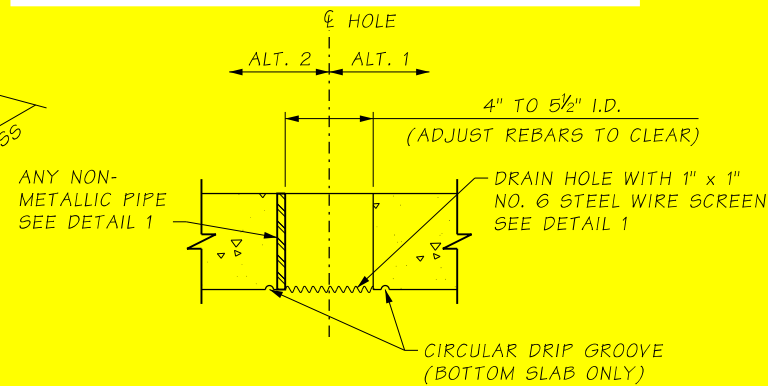

**BOTTOM SLAB DRAIN HOLE AND  
WEB AIR VENT HOLE IN NEW BOX**

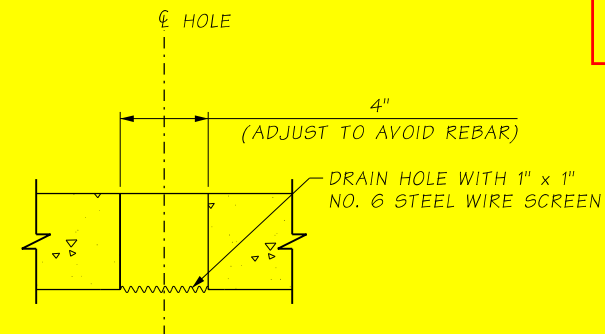

**BOTTOM SLAB DRAIN HOLE AND WEB  
AIR VENT HOLE IN EXISTING BOX**

**NOTES:**

- POST-TENSIONING AND ELECTRICAL CONDUIT NOT SHOWN.
- TRANSVERSE REINFORCEMENT SHALL BE PLACED PARALLEL TO THE EXISTING  $\phi$  OF PIER 1, WITH SPACING MEASURED ALONG  $\phi$  OF BOX.
- LONGITUDINAL REINFORCEMENT SPACING IS MEASURED AT EACH END OF NEW BOX. ADJUST AS REQUIRED TO SPLICE WITH EXISTING REINFORCEMENT.

FILE NO. 9242 SHEET 1-405

c:\users\mkal\documents\projectwise\workingdir\wsdot\dms22941\XL5467_12_DE_BG_BR17.7-GirdDef1.dgn			
Design Mgr:	B. BELL	RELEASE FOR CONSTRUCTION RECORD	
Designed By:	B. HU	REGION NO.	STATE
Checked By:	M. BAUGHMAN	10	WASH.
Detailed By:	P. CONRAD	JOB NUMBER	
Current Revision By:		XL5467	
Date:	12/20/2021	CONTRACT NO.	
Time:	8:54:39 AM	C9242	
	DESCRIPTION	DATE	NO




DATE

E.O.R. 1 STAMP BOX

DATE

E.O.R. 2 STAMP BOX

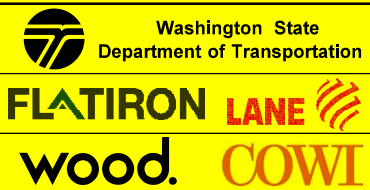


**I-405; RENTON TO BELLEVUE WIDENING  
AND EXPRESS TOLL LANES PROJECT**

**BRIDGE 405/17.7 - RENTON AVE OVER I-405**

**CONCRETE BOX DETAILS 1 OF 13**

PLAN REF. NO.  
**BG17.7-12**  
SHEET  
OF  
SHEETS



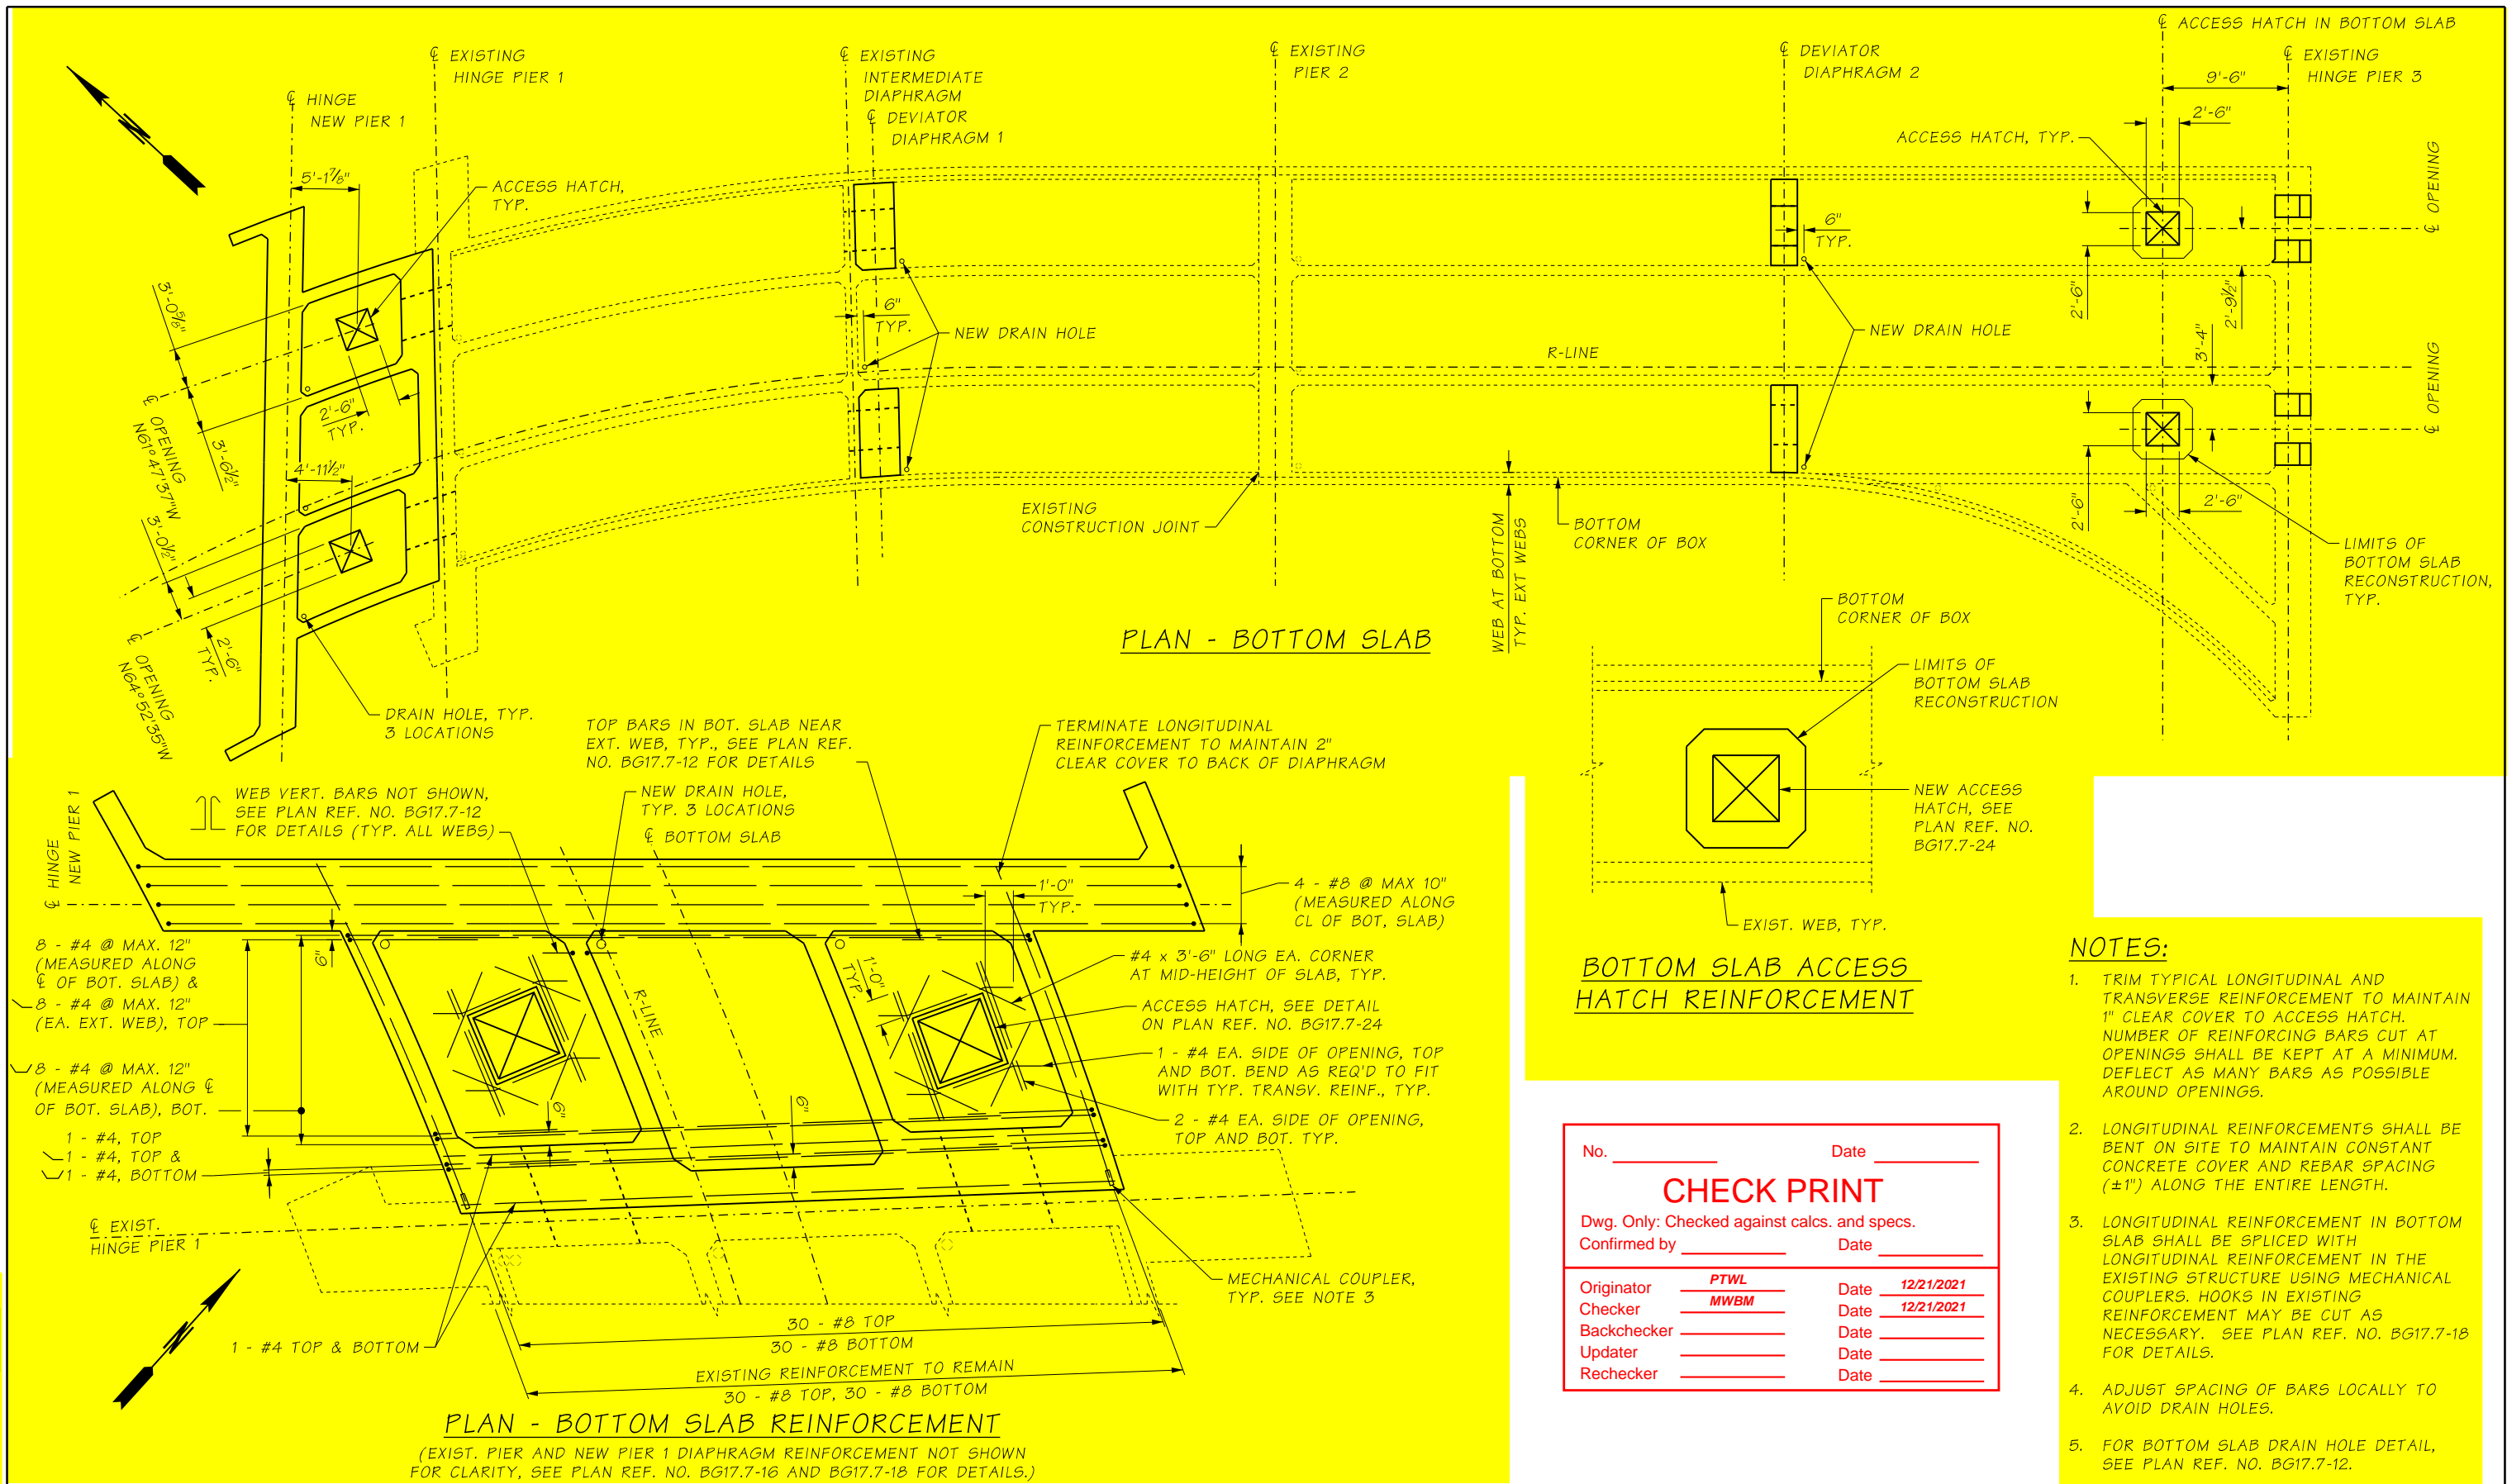

c:\users\mkal\documents\projectwise\workingdir\wsdot\dms22941\XL5467\_13\_DE\_BG\_BR17.7-GirdDef2.dgn

Design Mgr:	B. BELL	RELEASE FOR CONSTRUCTION RECORD		REGION NO.	STATE	FED. AID, PROJ. NO.	SHEET NO.	TOTAL SHEETS
Designed By:	B. HU			10	WASH.			
Checked By:	M. BAUGHMAN				JOB NUMBER			
Detailed By:	J. GANASSIN				XL5467			
Current Revision By:					CONTRACT NO.			
Date:	12/16/2021				C9242			
Time:	2:52:50 PM	DESCRIPTION	DATE	NO				



DATE

E.O.R. 1 STAMP BOX

DATE

Washington State  
Department of Transportation

FLATIRON LANE

wood. COWI

I-405; RENTON TO BELLEVUE WIDENING  
AND EXPRESS TOLL LANES PROJECT

BRIDGE 405/17.7 - RENTON AVE OVER I-405

CONCRETE BOX DETAILS 2 OF 13

PLAN REF. NO.

BG17.7-13

SHEET

OF

SHEETS

I-405  
FILE NO. 9242  
SHEET

### NOTES:

1. CONTRACTOR SHALL AVOID DAMAGE TO EXISTING STEEL REINFORCEMENT DURING DRILLING OPERATIONS. CONTRACTOR SHALL NOTIFY ENGINEER IMMEDIATELY IF ANY EXISTING REBAR OR ANCHOR BOLTS ARE DAMAGED.
2. CORE DRILLING IS PERMISSIBLE FOR NEW AIR VENT OPENINGS IN EXISTING BOX. SEE NOTE 1.
3. DRILLED HOLES SHALL HAVE A MINIMUM DISTANCE TO EDGE OF CONCRETE OF 4 INCHES.
4. INTERIOR WEB STIRRUPS SHALL BE VERTICAL, EXTERIOR WEB STIRRUPS SHALL BE IN PLANE OF WEB.
5. WEB LONGITUDINAL BARS SHALL BE BENT TO MAINTAIN CONSTANT CONCRETE COVER AND SPACING ( $\pm 1"$ ) ALONG THE ENTIRE LENGTH.
6. ADJUST SPACING OF BARS LOCALLY TO AVOID AIR VENT HOLES.
7. FOR WEB AIR VENT HOLE DETAIL, SEE PLAN REF. NO. BG17.7-12.

### ELEVATION - INTERIOR WEBS

No. _____	Date _____
<b>CHECK PRINT</b>	
Dwg. Only: Checked against calcs. and specs.	
Confirmed by _____	Date _____
Originator <u>PTWL</u>	Date <u>12/21/2021</u>
Checker <u>MWBM</u>	Date <u>12/21/2021</u>
Backchecker _____	Date _____
Updater _____	Date _____
Rechecker _____	Date _____

### ELEVATION - EXTERIOR WEBS


### INTERIOR WEBS REINFORCEMENT


### EXTERIOR WEBS REINFORCEMENT

(WEBS 1 AND 4)


c:\users\mkal\documents\projectwise\workingdir\wsdot\dms22941\XL5467\_14\_DE\_BG\_BR17.7-GirdDet3.dgn

Design Mgr:	B. BELL	RELEASE FOR CONSTRUCTION RECORD		REGION NO.	STATE	FED. AID, PROJ. NO.	SHEET NO.	TOTAL SHEETS
Designed By:	B. HU			10	WASH.			
Checked By:	M. BAUGHMAN				JOB NUMBER			
Detailed By:	J. GANASSIN				XL5467			
Current Revision By:					CONTRACT NO.			
Date:	12/20/2021				C9242			
Time:	10:06:44 AM	DESCRIPTION	DATE	NO				

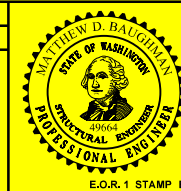


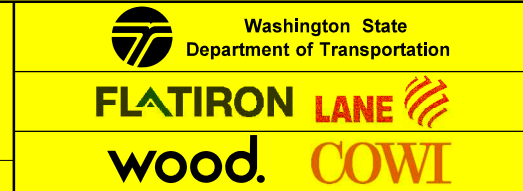
I-405; RENTON TO BELLEVUE WIDENING AND EXPRESS TOLL LANES PROJECT	PLAN REF. NO. BG17.7-14
BRIDGE 405/17.7 - RENTON AVE OVER I-405	SHEET OF SHEETS
CONCRETE BOX DETAILS 3 OF 13	

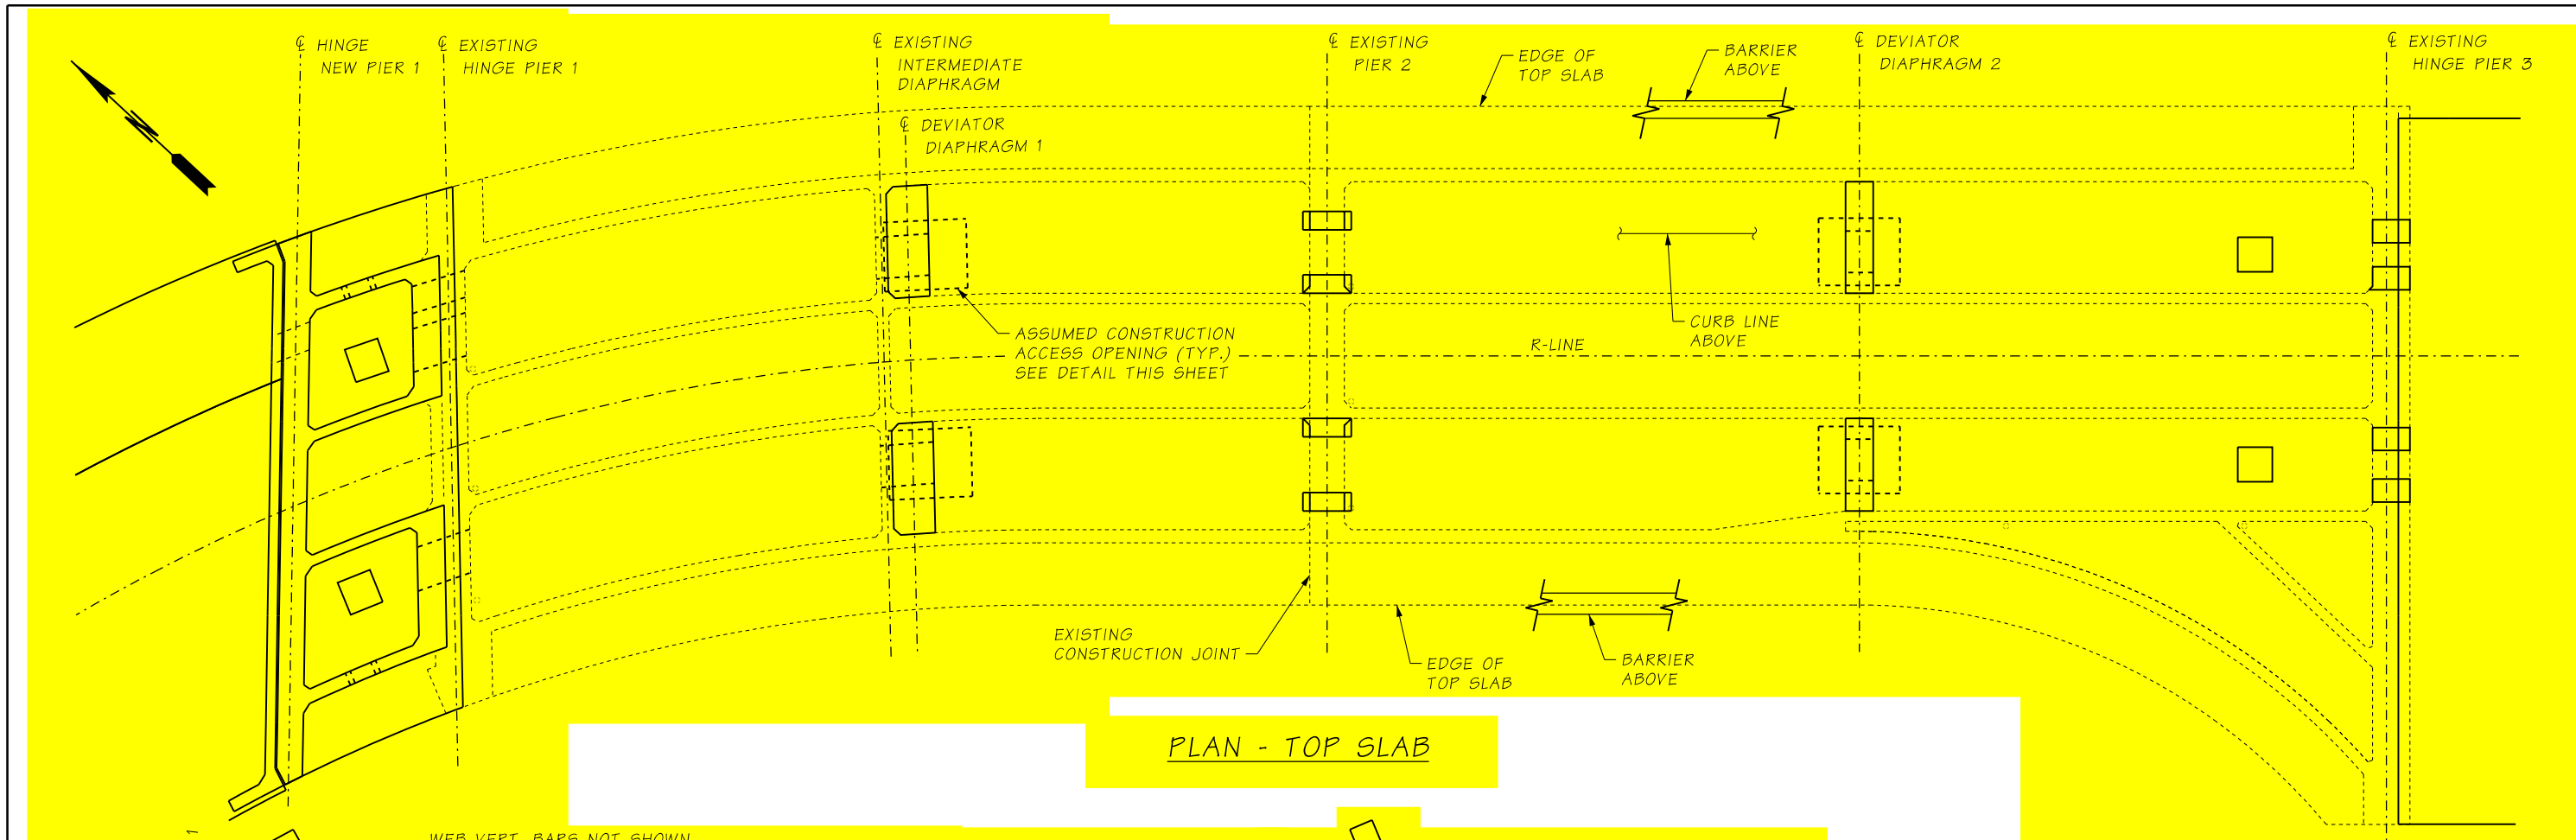


PLAN - TOP SLAB

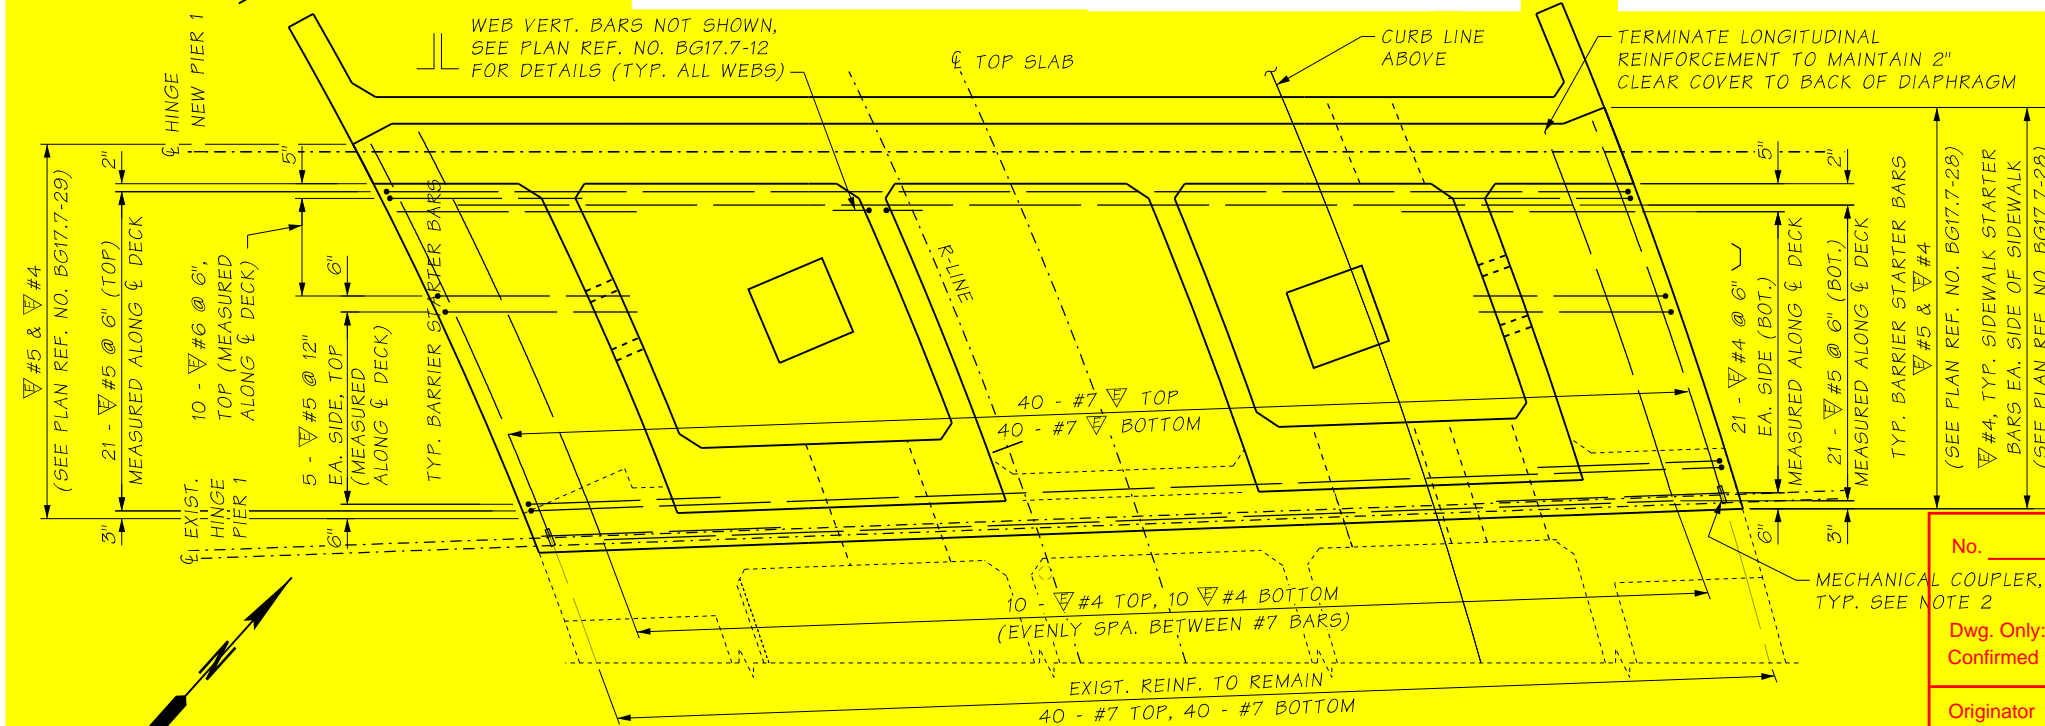

PLAN - TOP SLAB REINFORCEMENT

(EXISTING PIER 1 AND NEW PIER 1 DIAPHRAGM REINFORCEMENT NOT SHOWN FOR CLARITY, SEE PLAN REF. NO. BG17.7-16 AND BG17.7-18 FOR DETAILS.)

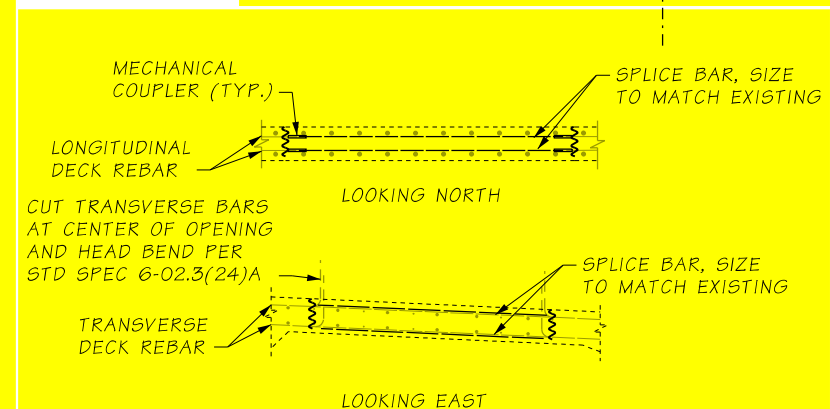

TEMPORARY TOP SLAB OPENING DETAILS

No.	_____	Date	_____
<b>CHECK PRINT</b>			
Dwg. Only: Checked against calcs. and specs.			
Confirmed by	_____	Date	_____
Originator	PTWL	Date	12/21/2021
Checker	MWBM	Date	12/21/2021
Backchecker	_____	Date	_____
Updater	_____	Date	_____
Rechecker	_____	Date	_____

**NOTES:**

1. LONGITUDINAL REINFORCEMENT SHALL BE BENT ON SITE TO MAINTAIN CONSTANT CONCRETE COVER AND SPACING ( $\pm 1"$ ) ALONG THE ENTIRE LENGTH.
2. LONGITUDINAL REINFORCEMENT IN TOP SLAB SHALL BE SPLICED WITH LONGITUDINAL REINFORCEMENT IN THE EXISTING STRUCTURE USING MECHANICAL COUPLERS. SEE PLAN REF. NO. BG17.7-18 FOR DETAILS.

c:\users\mkal\documents\projectwise\workingdir\wsdot\dms22941\XL5467\_15\_DE\_BG\_BR17.7-GirdDet4.dgn

Design Mgr:	B. BELL	RELEASE FOR CONSTRUCTION RECORD		REGION NO.	STATE	FED. AID, PROJ. NO.	SHEET NO.	TOTAL SHEETS
Designed By:	B. HU			10	WASH.			
Checked By:	M. BAUGHMAN				JOB NUMBER			
Detailed By:	J. GANASSIN				XL5467			
Current Revision By:					CONTRACT NO.			
Date:	12/20/2021				C9242			
Time:	11:22:57 AM	DESCRIPTION	DATE	NO				



DATE

E.O.R. 1 STAMP BOX

DATE

Washington State  
Department of Transportation

FLATIRON LANE

wood. COWI

I-405; RENTON TO BELLEVUE WIDENING  
AND EXPRESS TOLL LANES PROJECT

BRIDGE 405/17.7 - RENTON AVE OVER I-405

CONCRETE BOX DETAILS 4 OF 13

PLAN REF. NO.

BG17.7-15

SHEET



OF

SHEETS









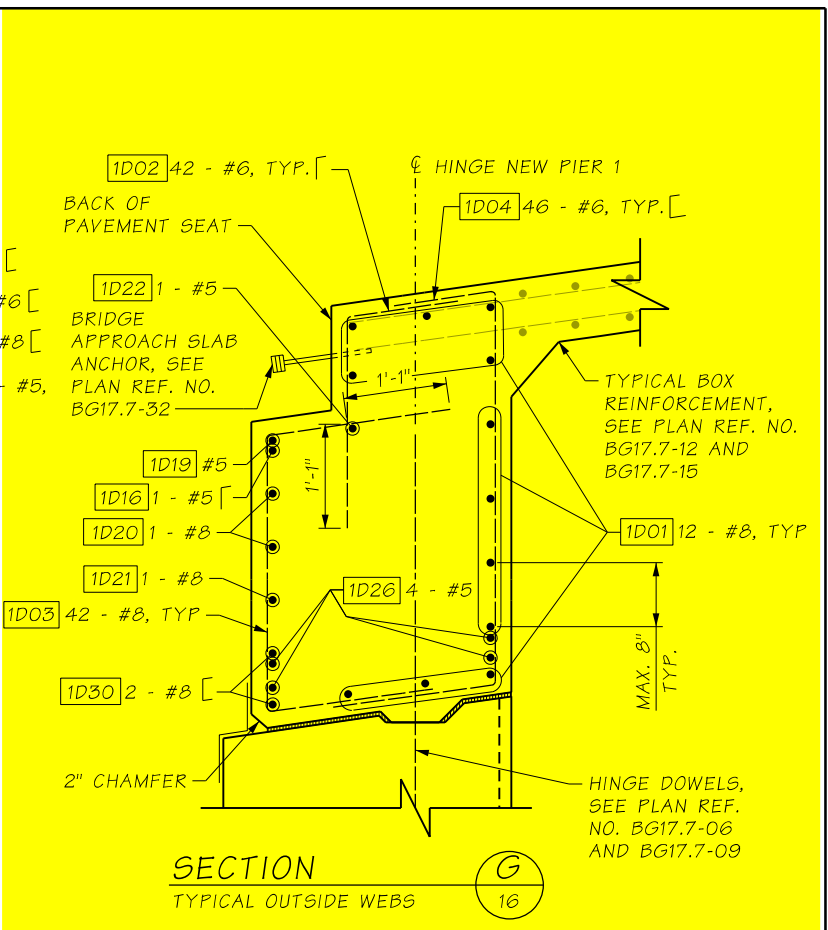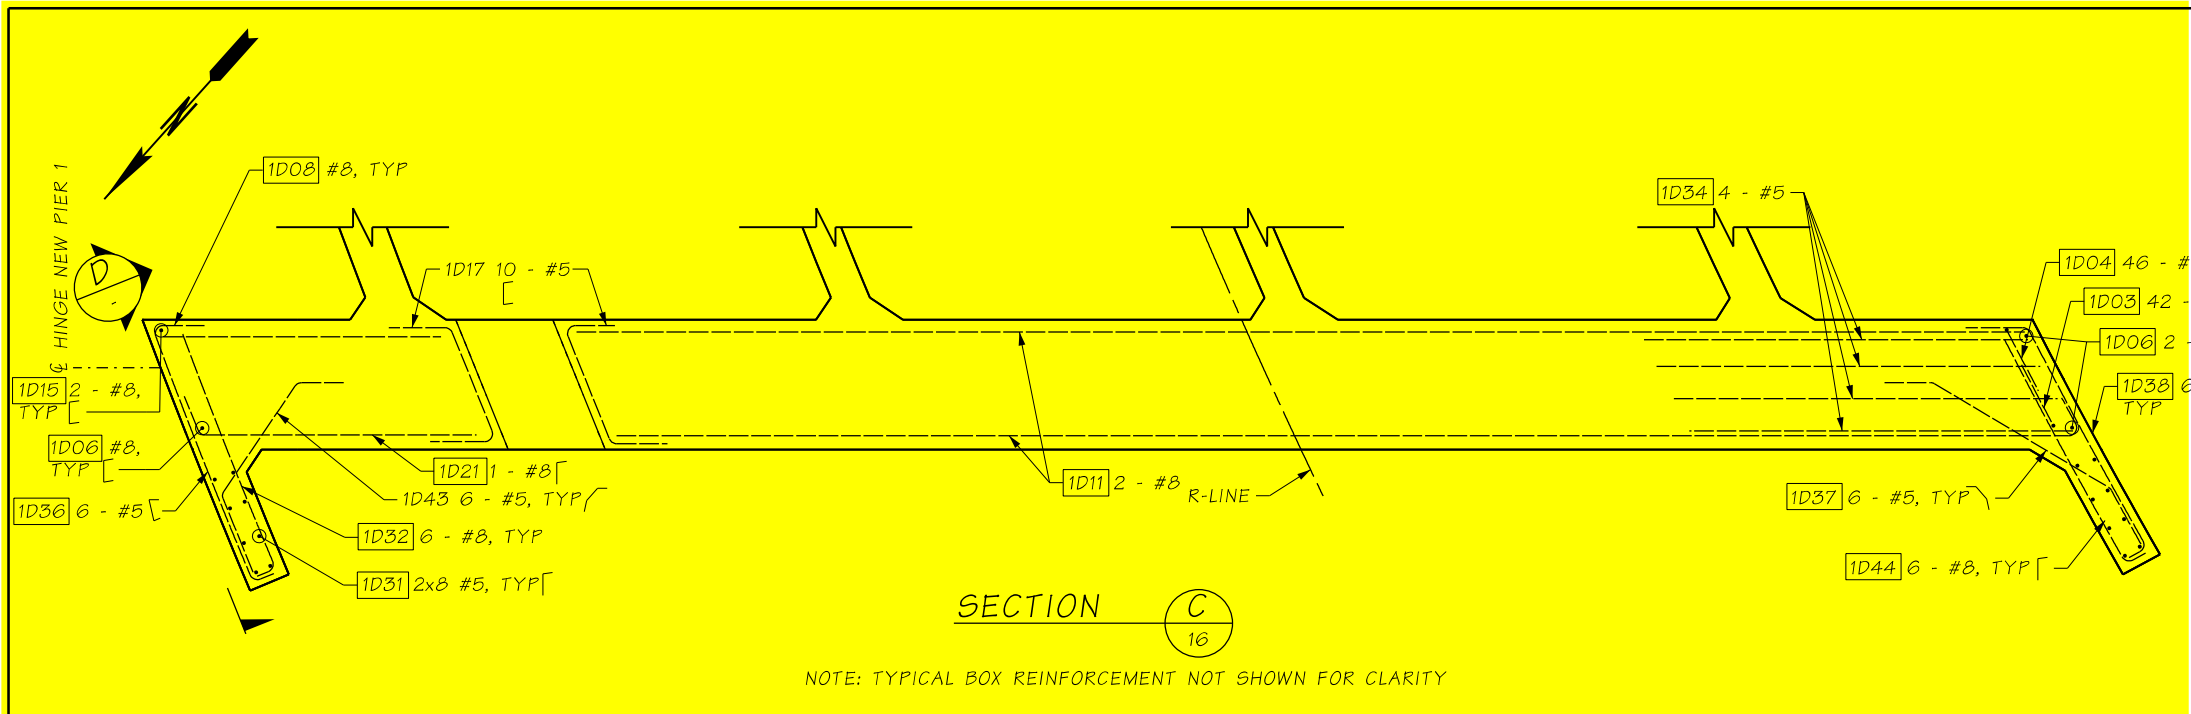

No. _____	Date _____
<b>CHECK PRINT</b>	
Dwg. Only: Checked against calcs. and specs.	
Confirmed by _____	Date _____
Originator <u>PTWL</u>	Date <u>12/21/2021</u>
Checker <u>MWBM</u>	Date <u>12/21/2021</u>
Backchecker _____	Date _____
Updater _____	Date _____
Rechecker _____	Date _____

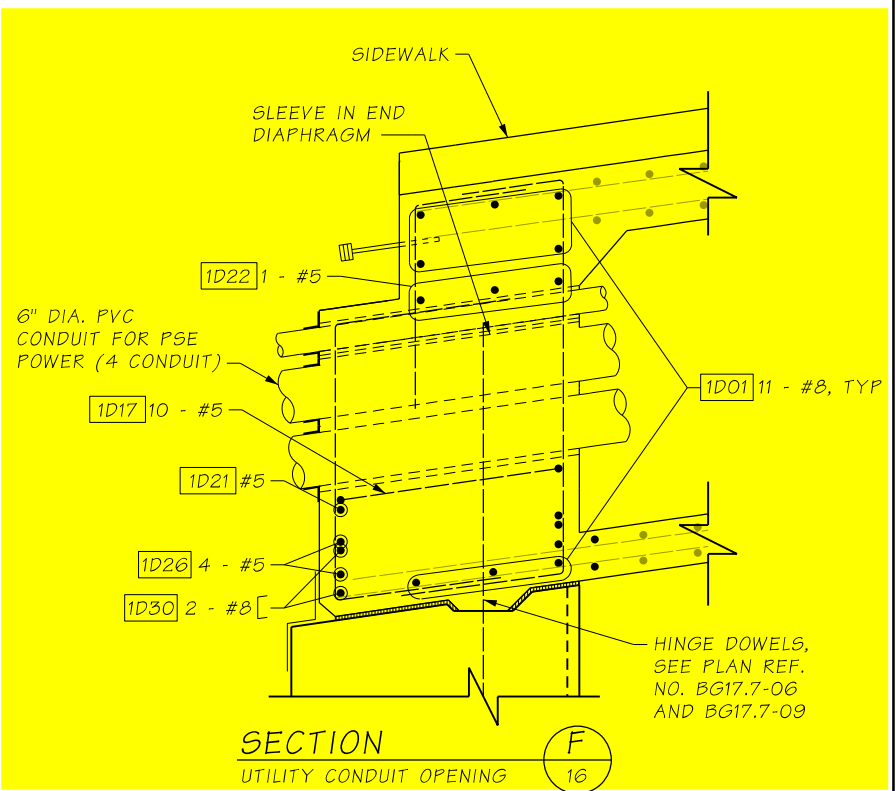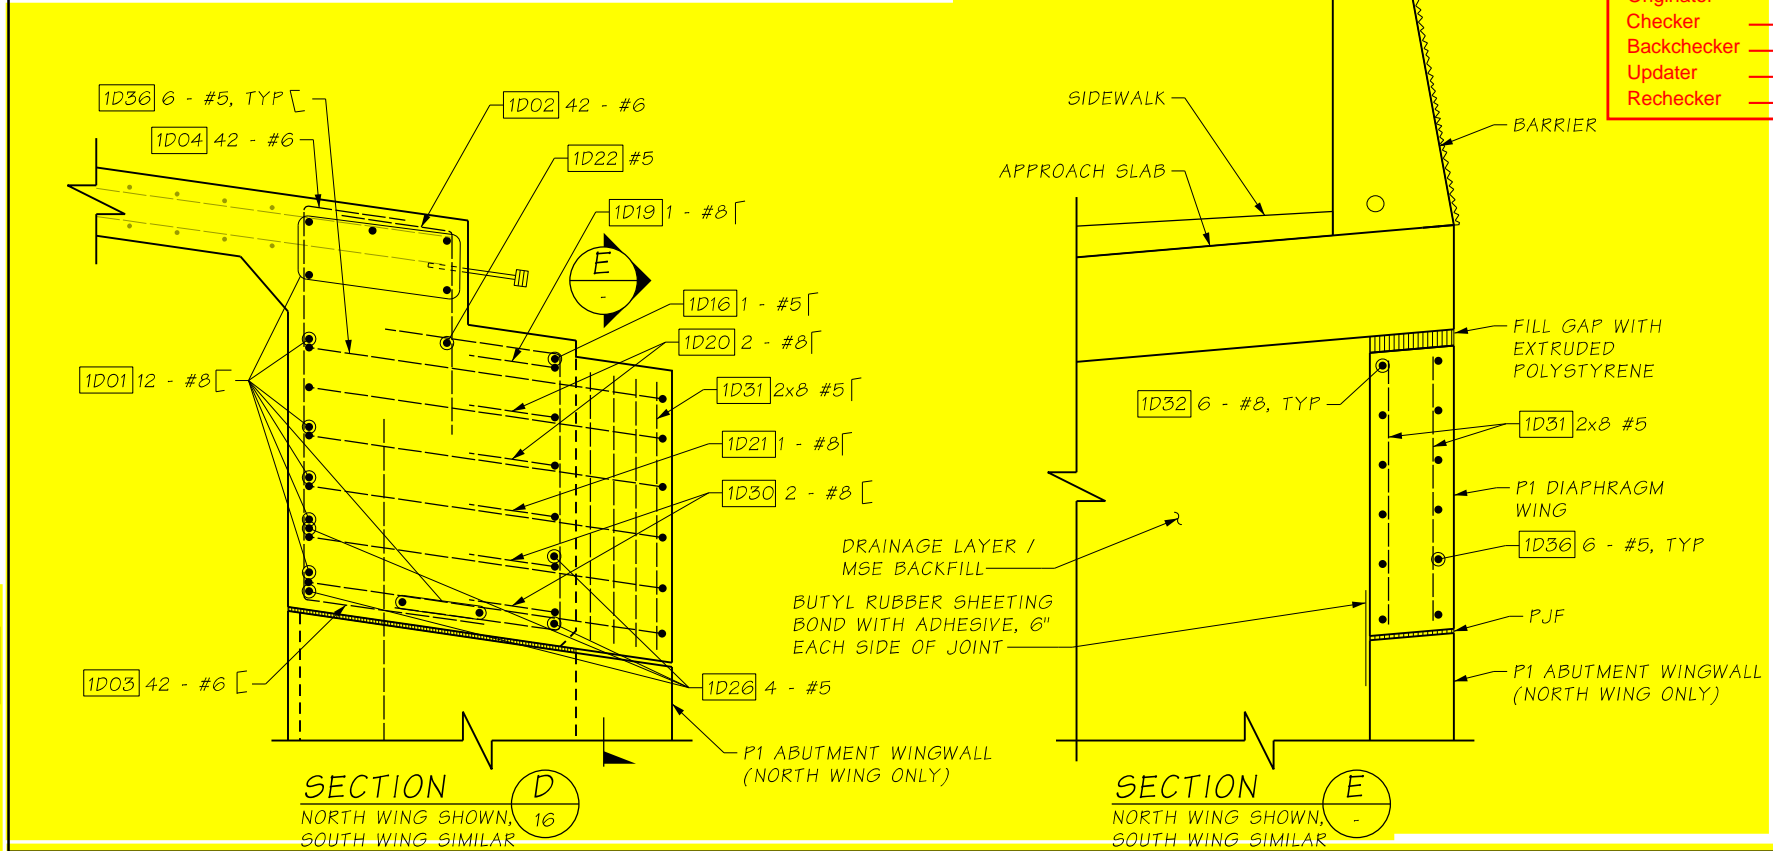


I-405  
FILE NO. 9242  
SHEET


c:\users\mkal\documents\projectwise\workingdir\wsdot\dms22941\XL5467_17_DE_BG_BR17.7-GirdDet6.dgn			
Design Mgr:	B. BELL	RELEASE FOR CONSTRUCTION RECORD	
Designed By:	B. HU	REGION NO.	STATE
Checked By:	M. BAUGHMAN	10	WASH.
Detailed By:	J. GANASSIN	JOB NUMBER	
Current Revision By:		XL5467	
Date:	12/20/2021	CONTRACT NO.	
Time:	12:06:38 PM	C9242	
DESCRIPTION		DATE	NO




DATE _____	DATE _____
E.O.R. 1 STAMP BOX	E.O.R. 2 STAMP BOX

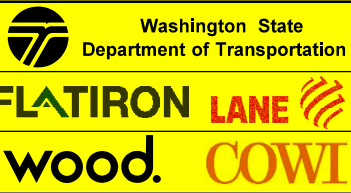

I-405; RENTON TO BELLEVUE WIDENING AND EXPRESS TOLL LANES PROJECT		PLAN REF. NO. BG17.7-17
BRIDGE 405/17.7 - RENTON AVE OVER I-405		SHEET OF SHEETS
CONCRETE BOX DETAILS 6 OF 13		

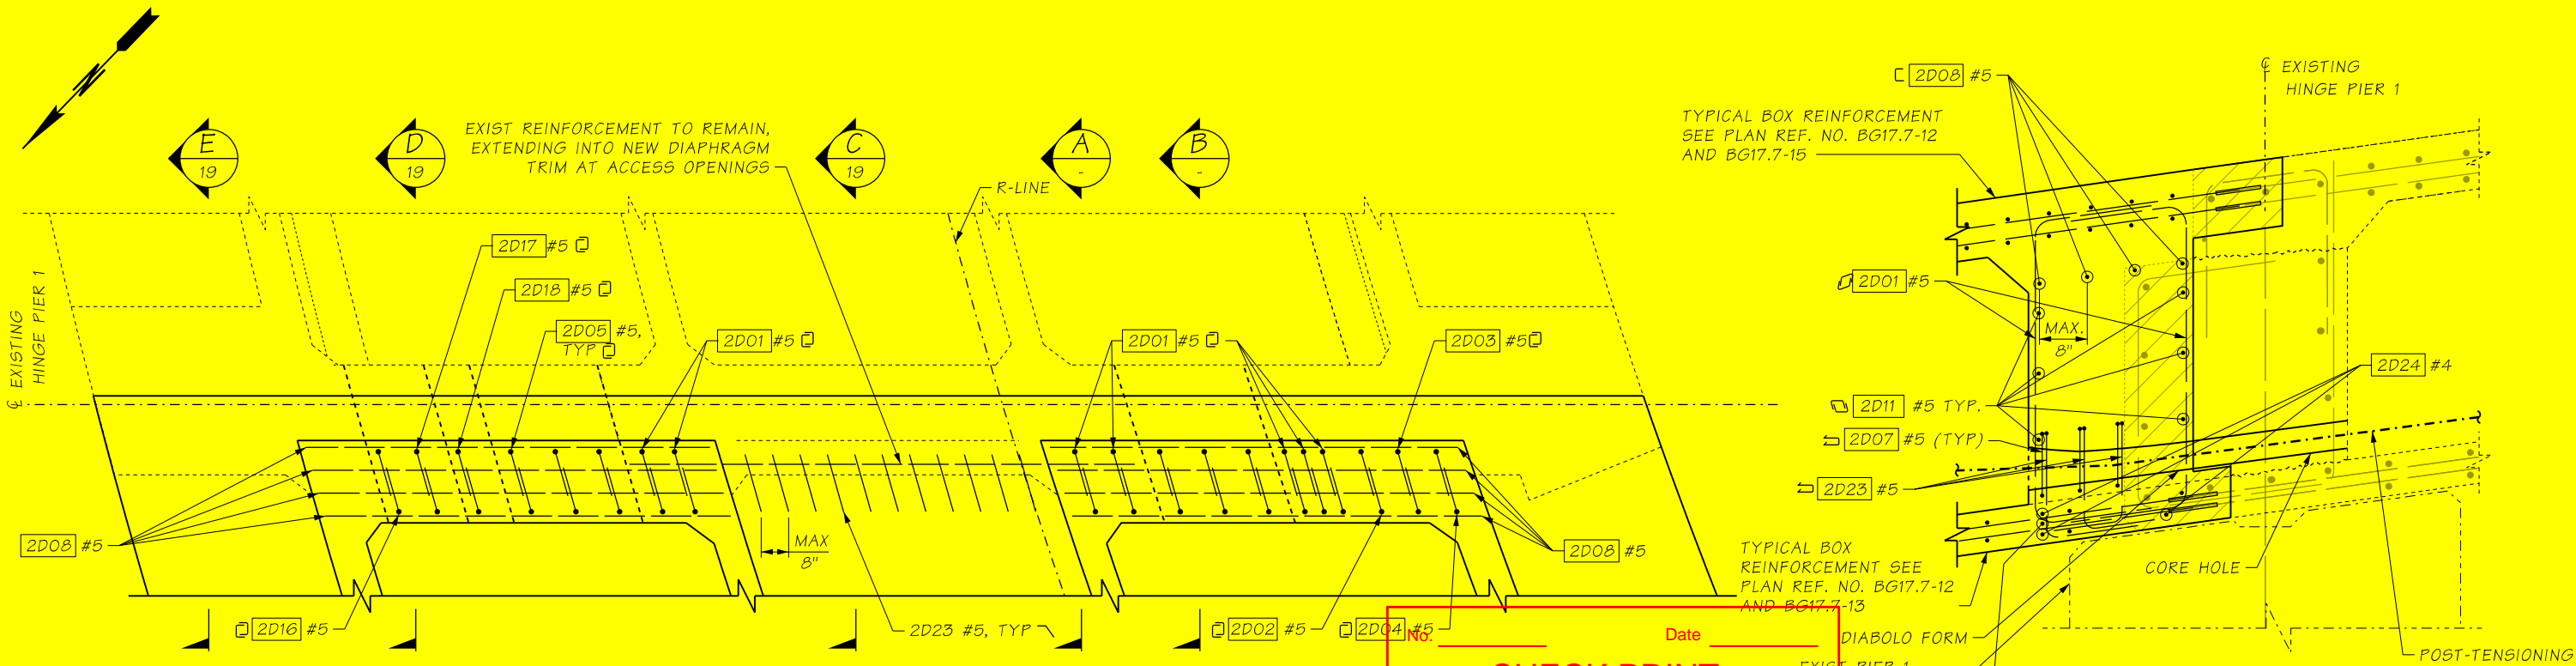


PLAN - EXISTING PIER 1 DIAPHRAGM  
NOTE: TYPICAL BOX REINFORCEMENT NOT SHOWN FOR CLARITY

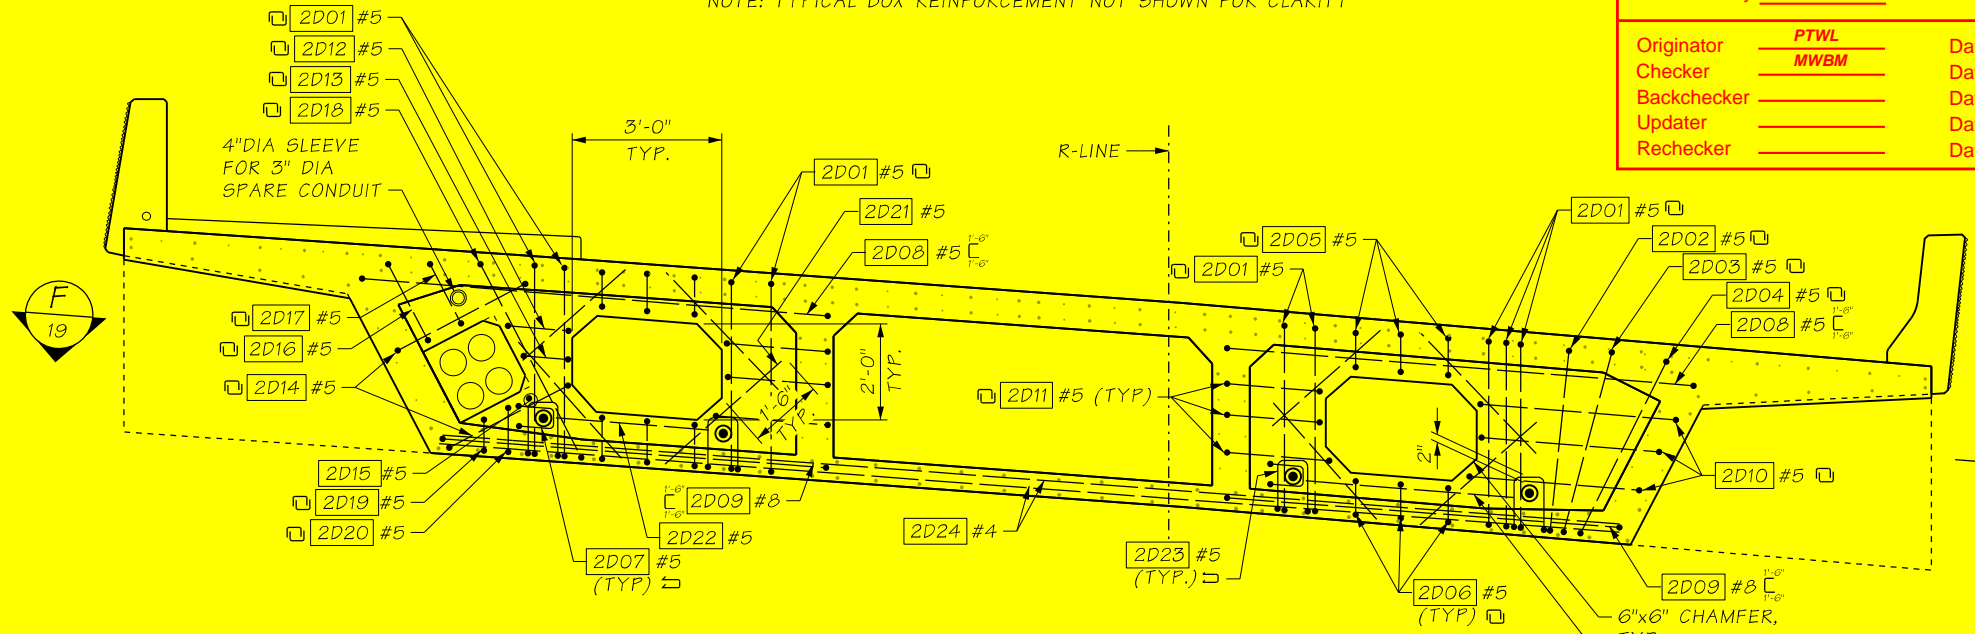

ELEVATION - EXISTING PIER 1 DIAPHRAGM  
(EXISTING PIER 1 TO BE REMOVED, NOT SHOWN)

NOTES:  
1. FOR LOCATION AND DETAILS OF PT DIABOLO FORM, SEE PLAN REF. NO. BG17.7-25

**CHECK PRINT**  
Dwg. Only: Checked against calcs. and specs.  
Confirmed by \_\_\_\_\_ Date \_\_\_\_\_  
Originator PTWL Date 12/21/2021  
Checker MWBM Date 12/21/2021  
Backchecker \_\_\_\_\_ Date \_\_\_\_\_  
Updater \_\_\_\_\_ Date \_\_\_\_\_  
Rechecker \_\_\_\_\_ Date \_\_\_\_\_

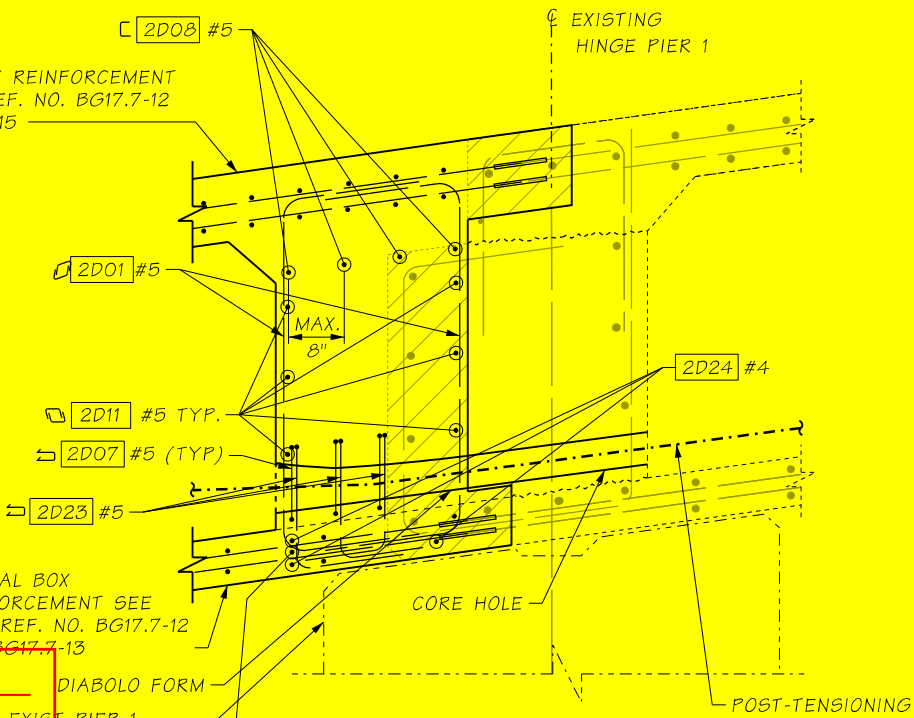


SECTION A  
TYPICAL IN EXTERIOR CELLS AWAY FROM ACCESS OPENINGS

TYPICAL BOX REINFORCEMENT SEE PLAN REF. NO. BG17.7-12 AND BG17.7-13

TYPICAL BOX REINFORCEMENT SEE PLAN REF. NO. BG17.7-12 AND BG17.7-15


TYPICAL BOX REINFORCEMENT, SEE PLAN REF. NO. BG17.7-12 AND BG17.7-13

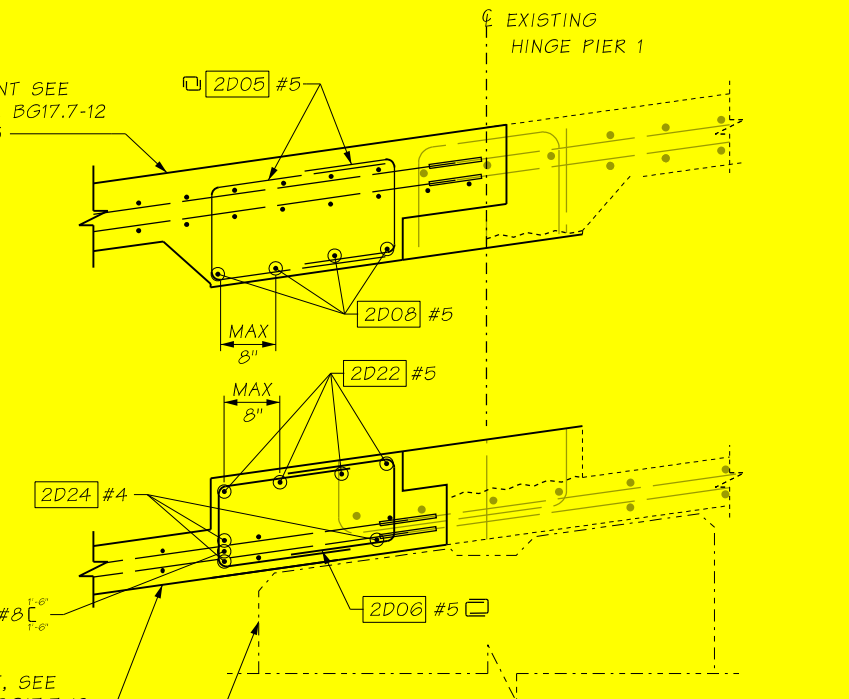


SECTION B  
TYPICAL AT ACCESS OPENINGS

FILE NO. 9242 SHEET 1-405


c:\users\mkal\documents\projectwise\workingdir\wsdot\dms22941\XL5467_18_DE_BG_BR17.7-GirdDef7.dgn			
Design Mgr:	B. BELL	RELEASE FOR CONSTRUCTION RECORD	
Designed By:	B. HU	REGION NO.	STATE
Checked By:	M. BAUGHMAN	10	WASH.
Detailed By:	J. GANASSIN	JOB NUMBER	
Current Revision By:		XL5467	
Date:	12/20/2021	CONTRACT NO.	
Time:	12:14:47 PM	C9242	
	DESCRIPTION	DATE	NO

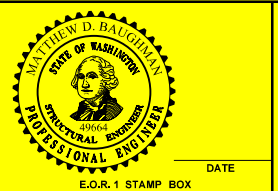




E.O.R. 1 STAMP BOX DATE \_\_\_\_\_  
E.O.R. 2 STAMP BOX DATE \_\_\_\_\_

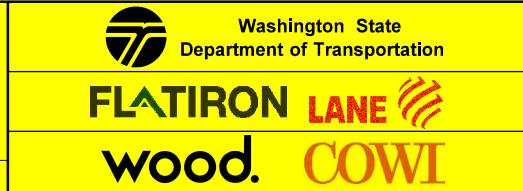

I-405; RENTON TO BELLEVUE WIDENING AND EXPRESS TOLL LANES PROJECT		PLAN REF. NO. BG17.7-18
BRIDGE 405/17.7 - RENTON AVE OVER I-405		SHEET OF SHEETS
CONCRETE BOX DETAILS 7 OF 13		

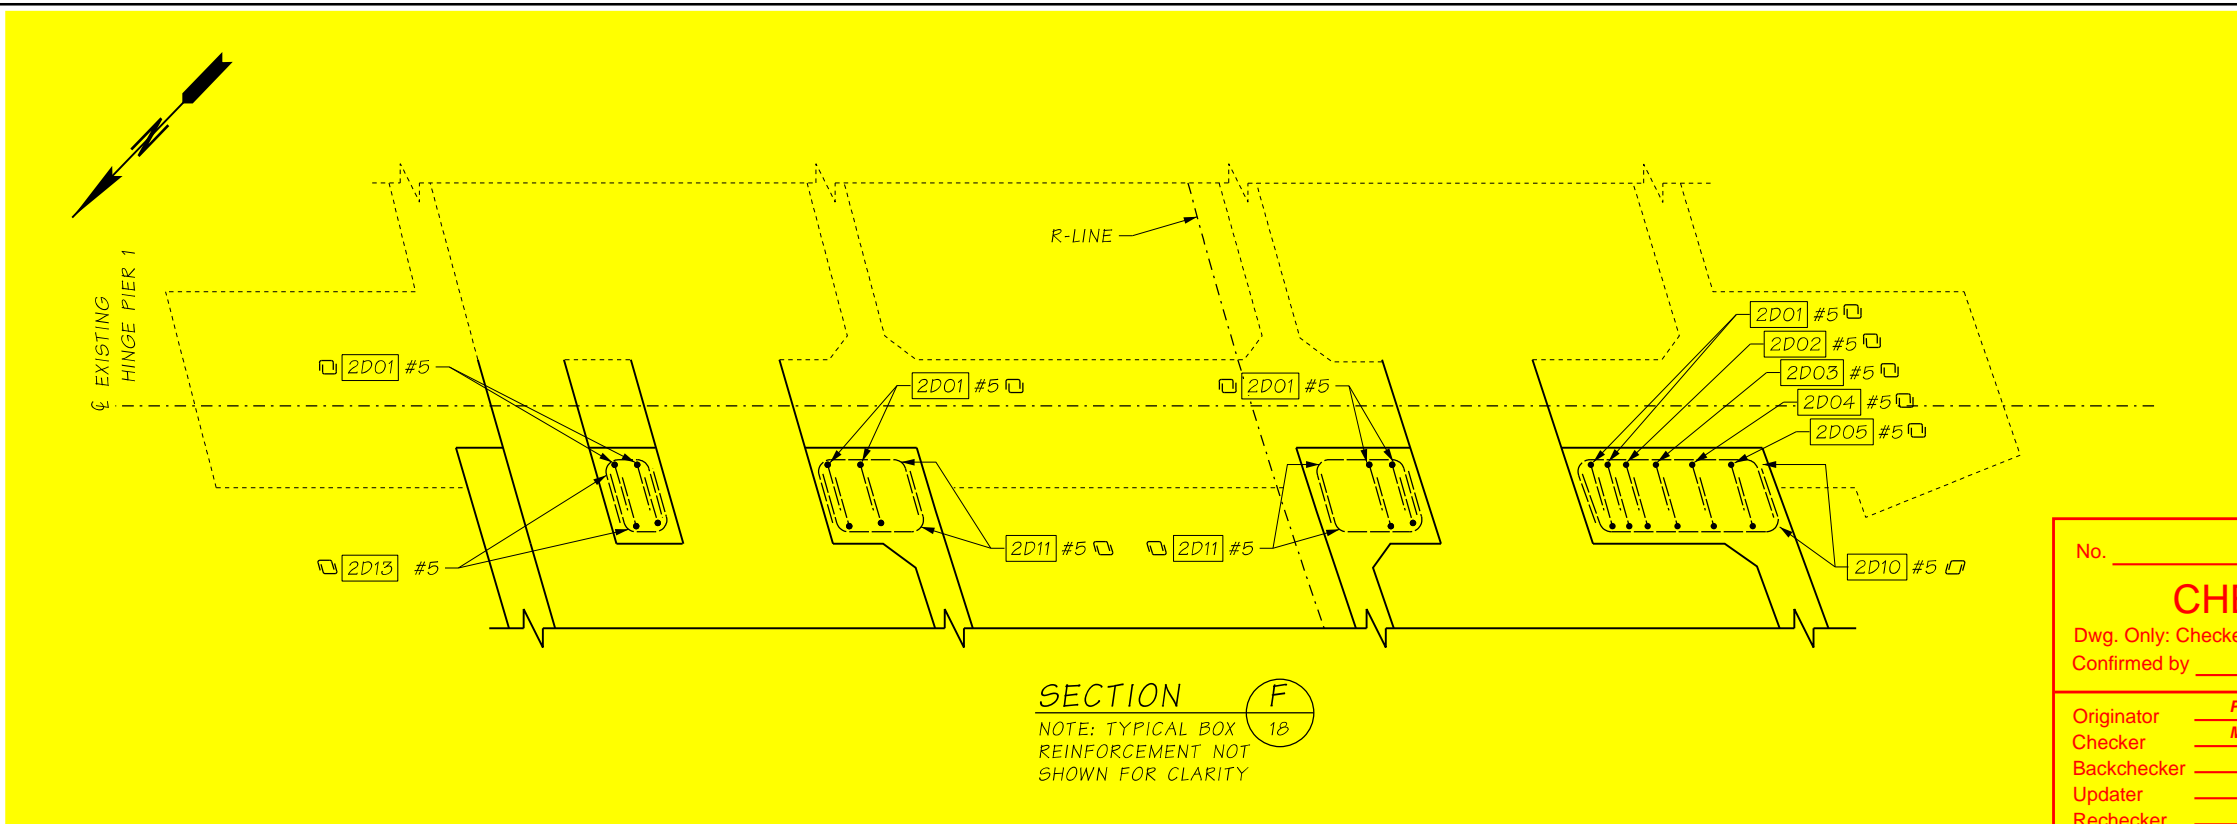

No.			Date		
<b>CHECK PRINT</b>					
Dwg. Only: Checked against calcs. and specs.					
Confirmed by			Date		
Originator	PTWL		Date	12/21/2021	
Checker	MWBM		Date	12/21/2021	
Backchecker			Date		
Updater			Date		
Rechecker			Date		

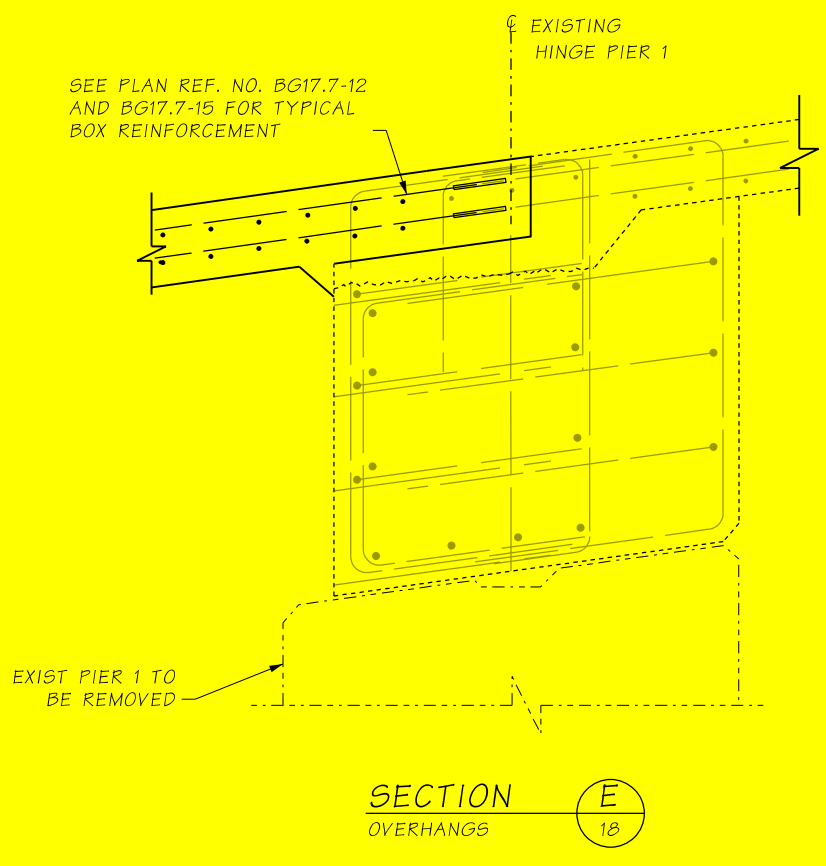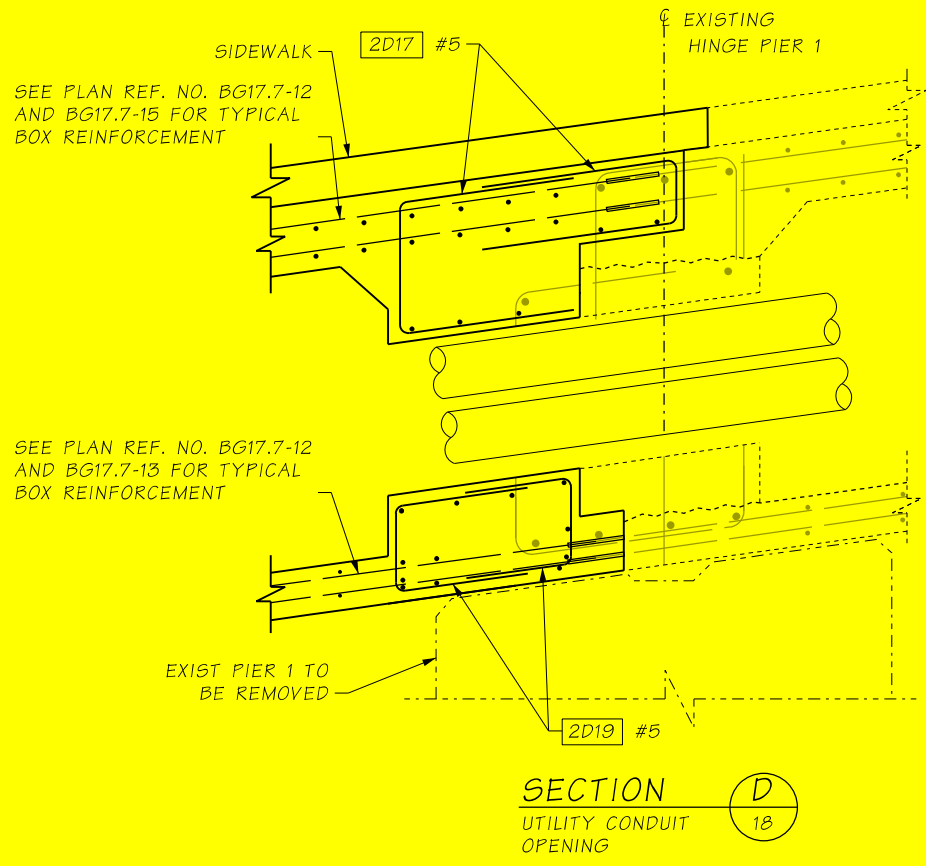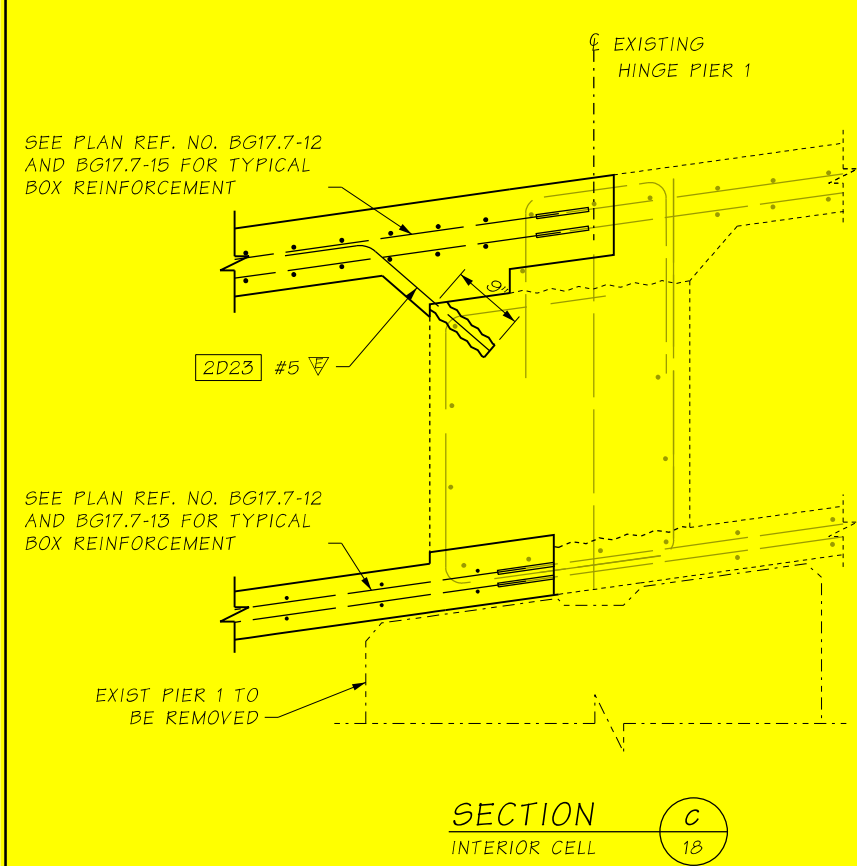

I-405  
FILE NO. 9242  
SHEET

c:\users\mkal\documents\projectwise\workingdir\wsdot\dms22941\XL5467_19_DE_BG_BR17.7-GirdDet8.dgn									
Design Mgr:	B. BELL	RELEASE FOR CONSTRUCTION RECORD			REGION NO.	STATE	FED. AID. PROJ. NO.	SHEET NO.	TOTAL SHEETS
Designed By:	B. HU				10	WASH.			
Checked By:	M. BAUGHMAN				JOB NUMBER				
Detailed By:	J. GANASSIN				XL5467				
Current Revision By:					CONTRACT NO.				
Date:	12/14/2021				C9242				
Time:	12:10:19 PM	DESCRIPTION	DATE	NO					



DATE

E.O.R. 1 STAMP BOX

DATE



Washington State  
Department of Transportation

FLATIRON LANE

wood. COWI


I-405; RENTON TO BELLEVUE WIDENING  
AND EXPRESS TOLL LANES PROJECT

BRIDGE 405/17.7 - RENTON AVE OVER I-405

CONCRETE BOX DETAILS 8 OF 13


PLAN REF. NO.  
BG17.7-19

SHEET  
OF  
SHEETS

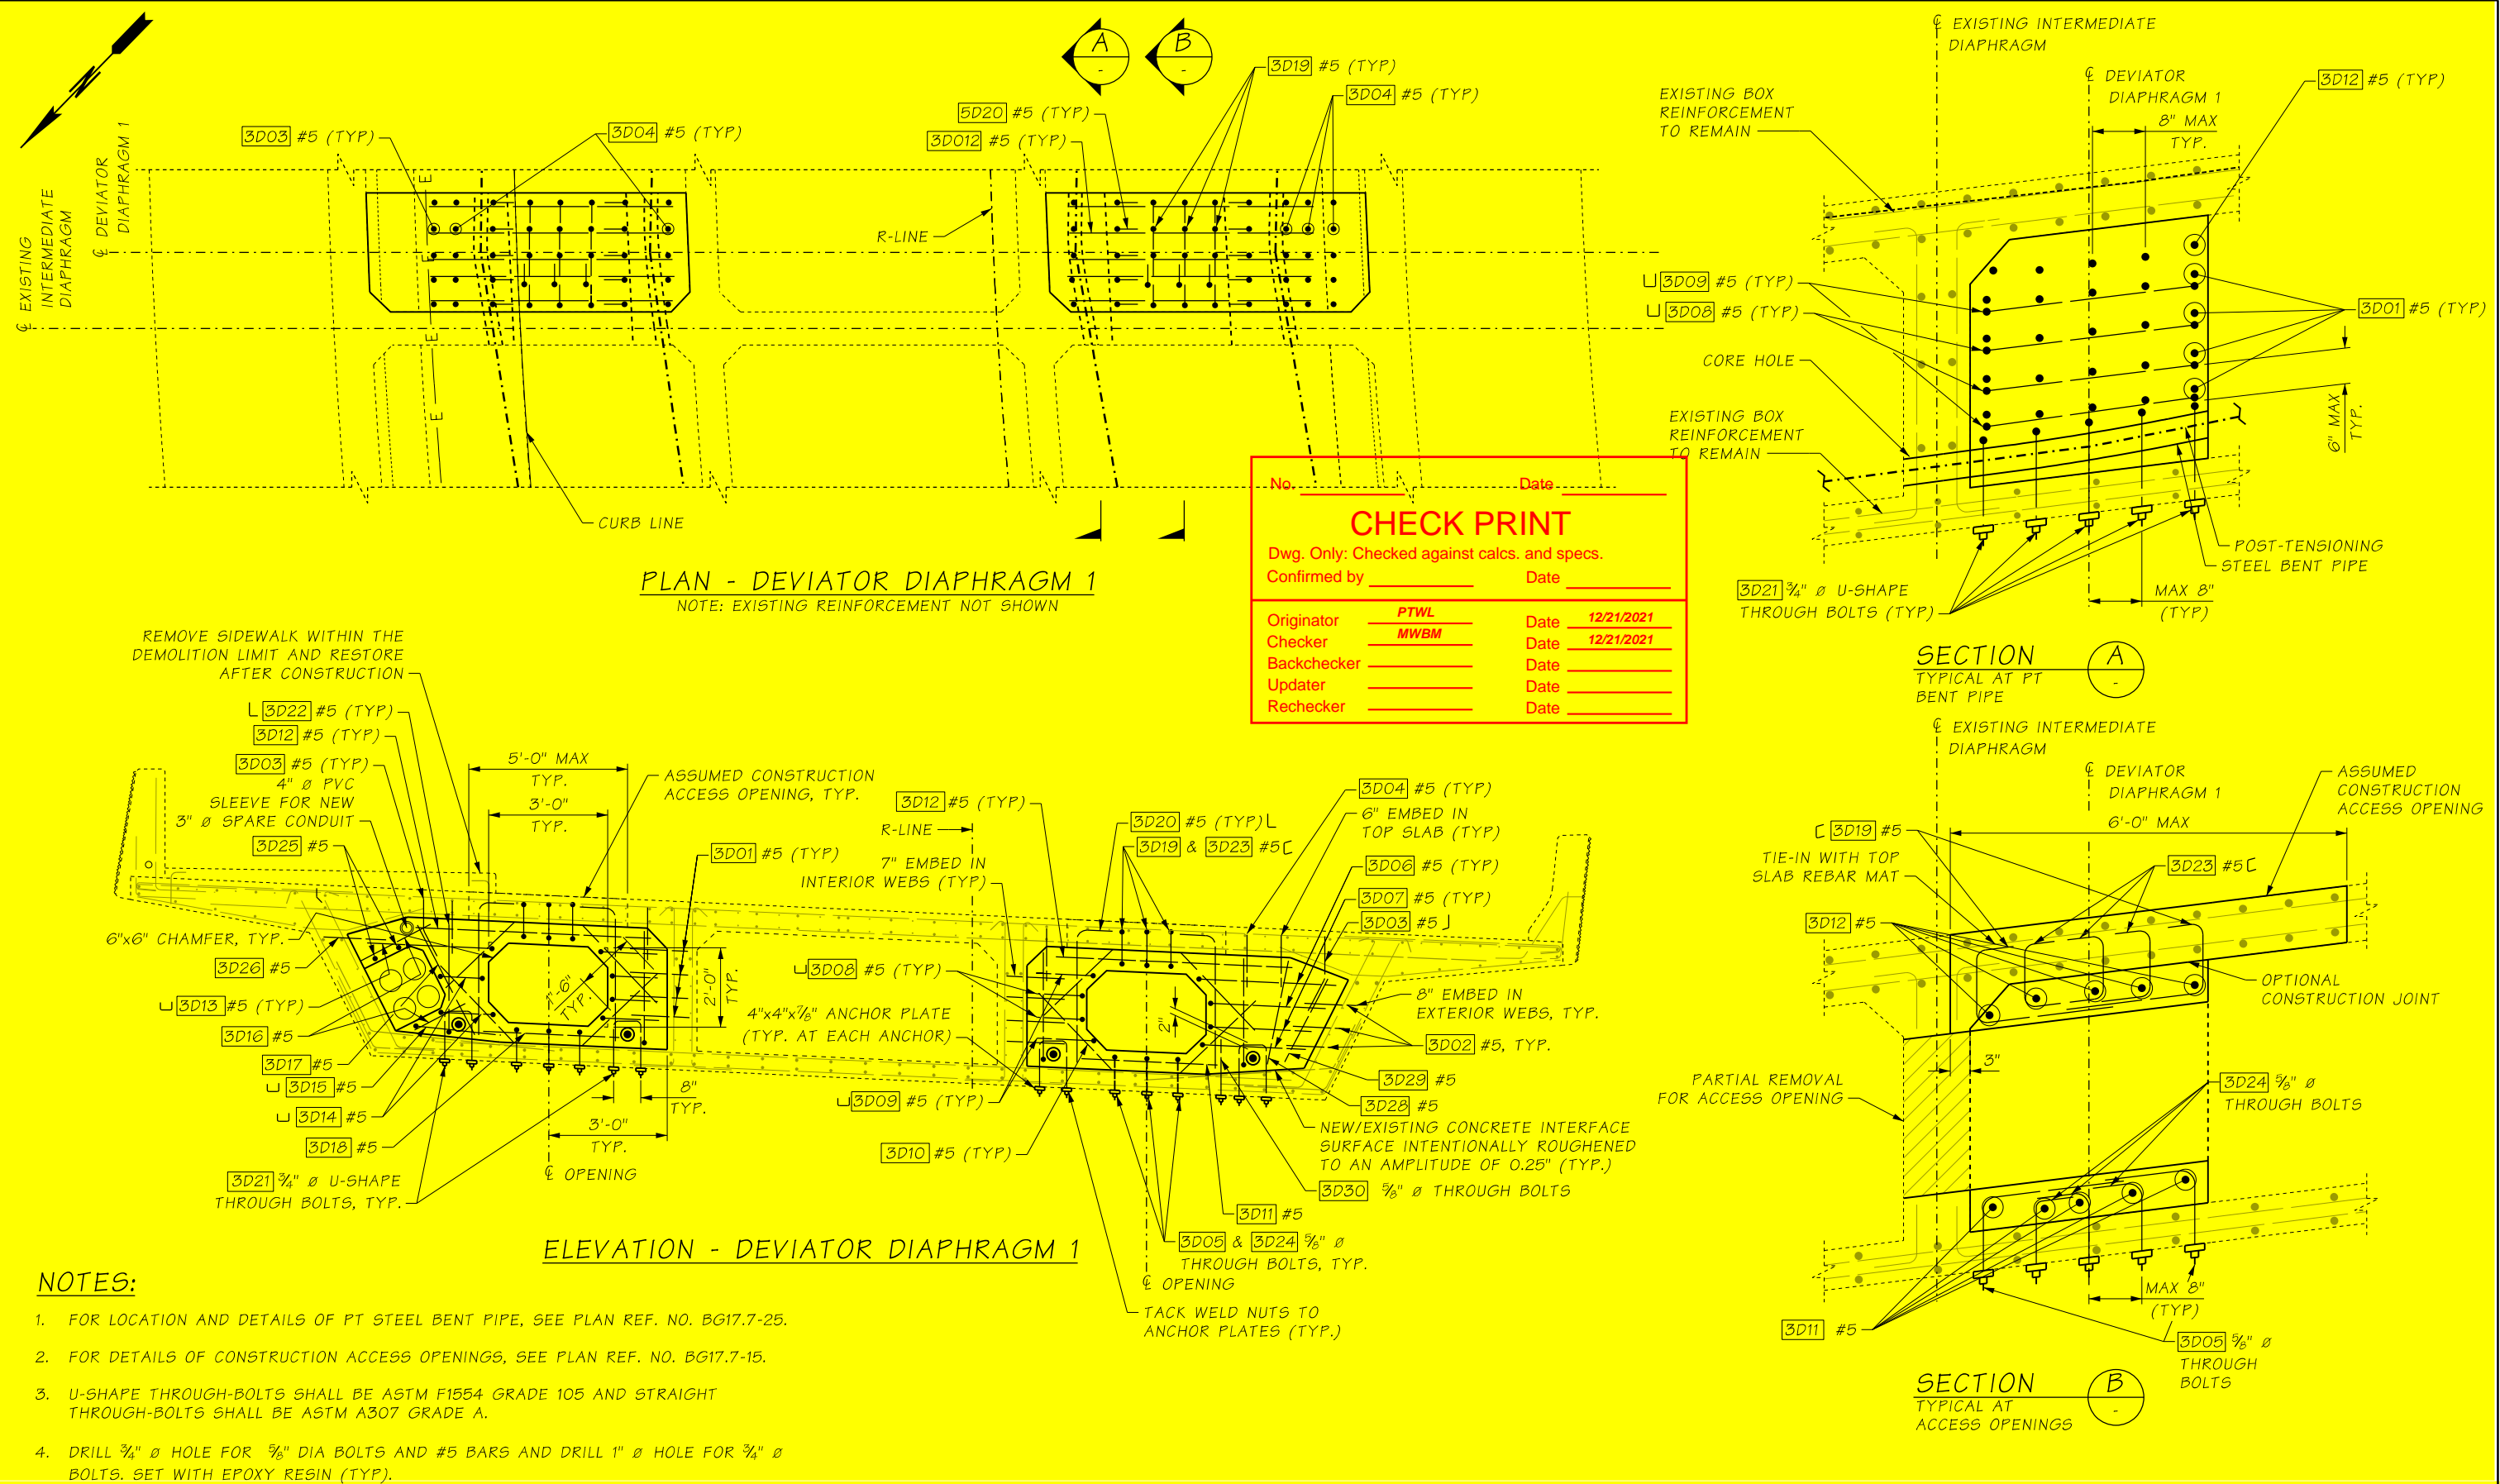

c:\users\mkal\documents\projectwise\workingdir\wsdot\dms22941\XL5467\_20\_DE\_BG\_BR17.7-GirdDet9.dgn

Design Mgr:	B. BELL	RELEASE FOR CONSTRUCTION RECORD	REGION NO.	STATE	FED. AID, PROJ. NO.	SHEET NO.	TOTAL SHEETS
Designed By:	B. HU		10	WASH.			
Checked By:	M. BAUGHMAN			JOB NUMBER			
Detailed By:	J. GANASSIN			XL5467			
Current Revision By:				CONTRACT NO.			
Date:	12/20/2021			C9242			
Time:	1:05:49 PM	DESCRIPTION	DATE	NO			

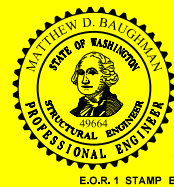

DATE

E.O.R. 1 STAMP BOX

DATE

E.O.R. 2 STAMP BOX

Washington State  
Department of Transportation

FLATIRON LANE

wood. COWI

I-405; RENTON TO BELLEVUE WIDENING  
AND EXPRESS TOLL LANES PROJECT

BRIDGE 405/17.7 - RENTON AVE OVER I-405

CONCRETE BOX DETAILS 9 OF 13

PLAN REF. NO.


BG17.7-20

SHEET

OF


SHEETS



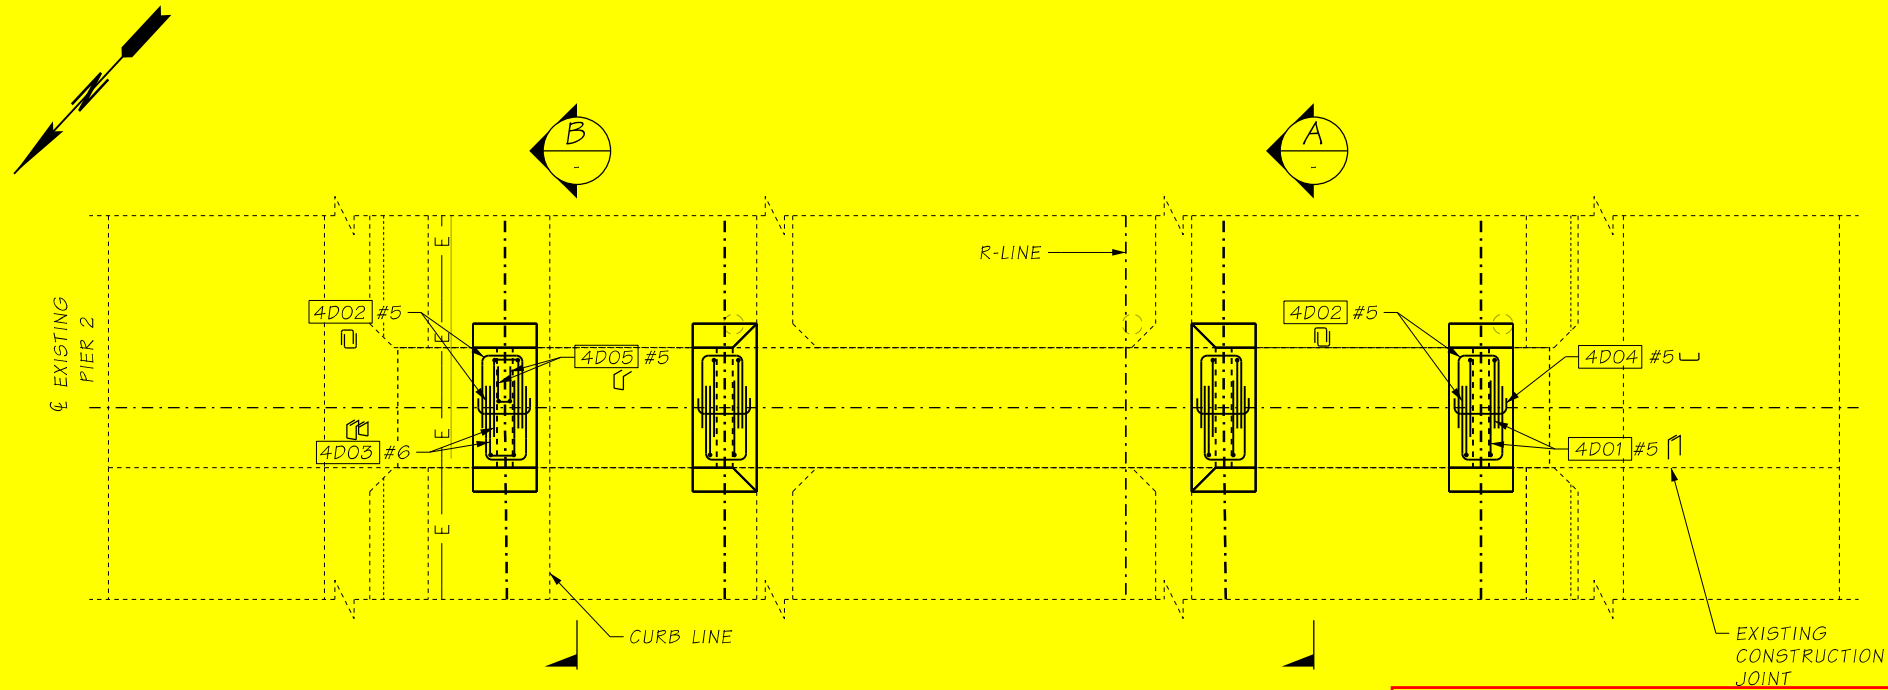


PLAN - EXISTING PIER 2 DIAPHRAGM  
NOTE: EXISTING REINFORCEMENT NOT SHOWN


No. _____	Date _____
<b>CHECK PRINT</b>	
Dwg. Only: Checked against calcs. and specs.	
Confirmed by _____	Date _____
Originator <u>PTWL</u>	Date <u>12/21/2021</u>
Checker <u>MWBM</u>	Date <u>12/21/2021</u>
Backchecker _____	Date _____
Updater _____	Date _____
Rechecker _____	Date _____

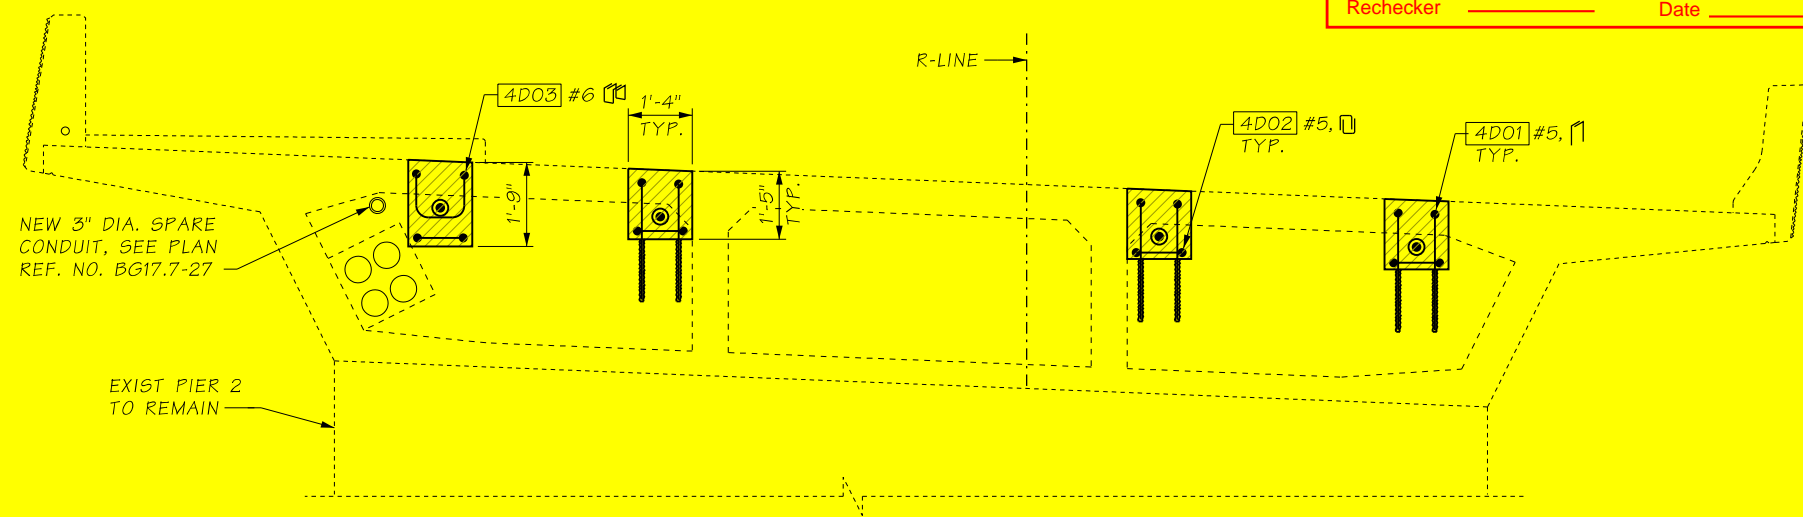

ELEVATION - EXISTING PIER 2 DIAPHRAGM  
NOTE: EXISTING REINFORCEMENT NOT SHOWN

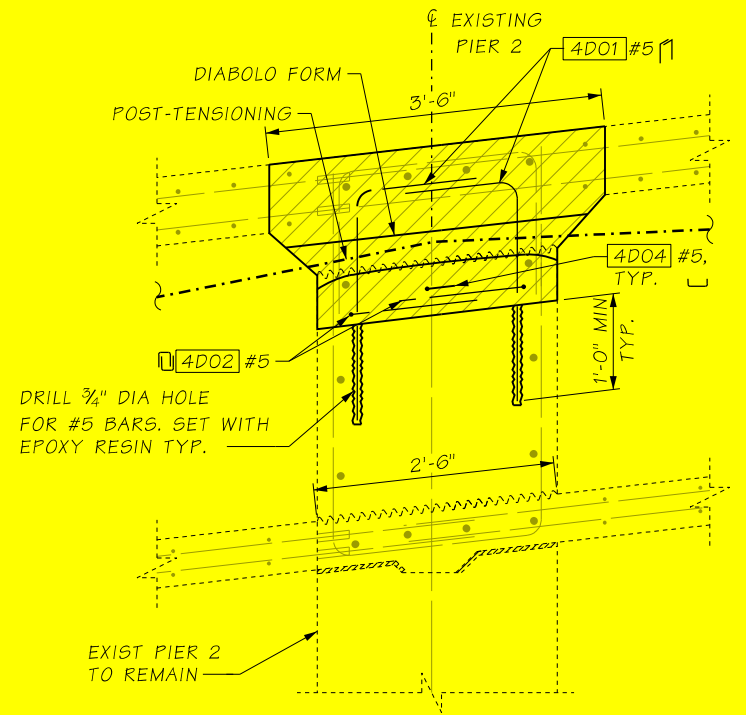

SECTION A  
TYPICAL AT PT-2  
THROUGH PT-4

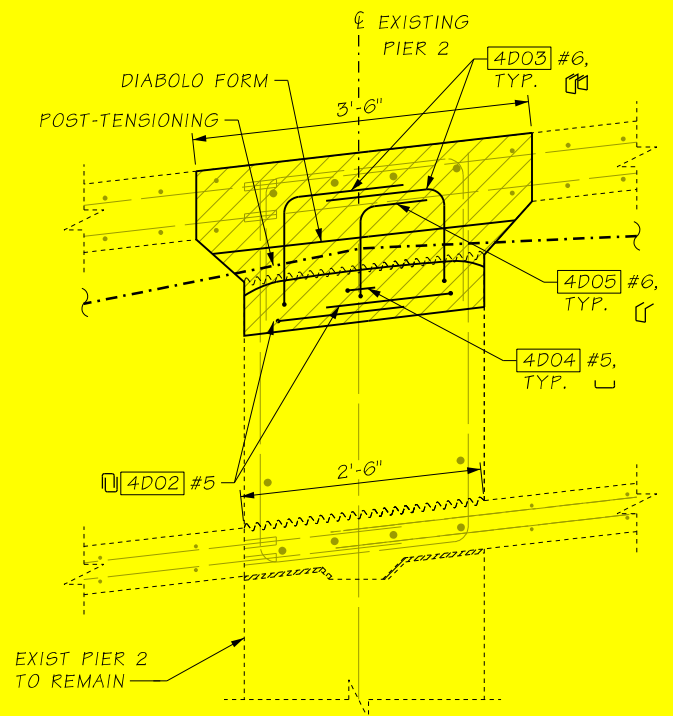

SECTION B  
AT PT-1 ONLY

NOTES:

- FOR LOCATION AND DETAILS OF PT DIABOLO FORM, SEE PLAN REF. NO. BG17.7-25.
- ALL EXISTING REINFORCEMENT IN THE PIER DIAPHRAGM SHALL REMAIN OR BE RESTORED AFTER CONSTRUCTION.

I-405  
FILE NO. 9242  
SHEET

c:\users\mkal\documents\projectwise\workingdir\wsdot\dms22941\XL5467_21_DE_BG_BR17.7-GirdDef10.dgn						
Design Mgr:	B. BELL	RELEASE FOR CONSTRUCTION RECORD			REGION NO.	TOTAL SHEETS
Designed By:	B. HU				10	
Checked By:	M. BAUGHMAN				STATE	
Detailed By:	J. GANASSIN				WASH.	
Current Revision By:					JOB NUMBER	
Date:	12/20/2021				XL5467	
Time:	1:36:36 PM				CONTRACT NO.	
		DESCRIPTION	DATE	NO	C9242	



DATE

E.O.R. 1 STAMP BOX

DATE

E.O.R. 2 STAMP BOX



Washington State  
Department of Transportation

FLATIRON LANE

wood. COWI

I-405; RENTON TO BELLEVUE WIDENING  
AND EXPRESS TOLL LANES PROJECT

BRIDGE 405/17.7 - RENTON AVE OVER I-405

CONCRETE BOX DETAILS 10 OF 13


PLAN REF. NO.

BG17.7-21


SHEET

OF

SHEETS

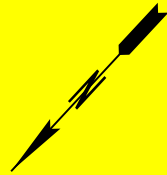


No. _____	Date _____
<b>CHECK PRINT</b>	
Dwg. Only: Checked against calcs. and specs.	
Confirmed by _____	Date _____
Originator <u>PTWL</u>	Date <u>12/21/2021</u>
Checker <u>MWBM</u>	Date <u>12/21/2021</u>
Backchecker _____	Date _____
Updater _____	Date _____
Rechecker _____	Date _____

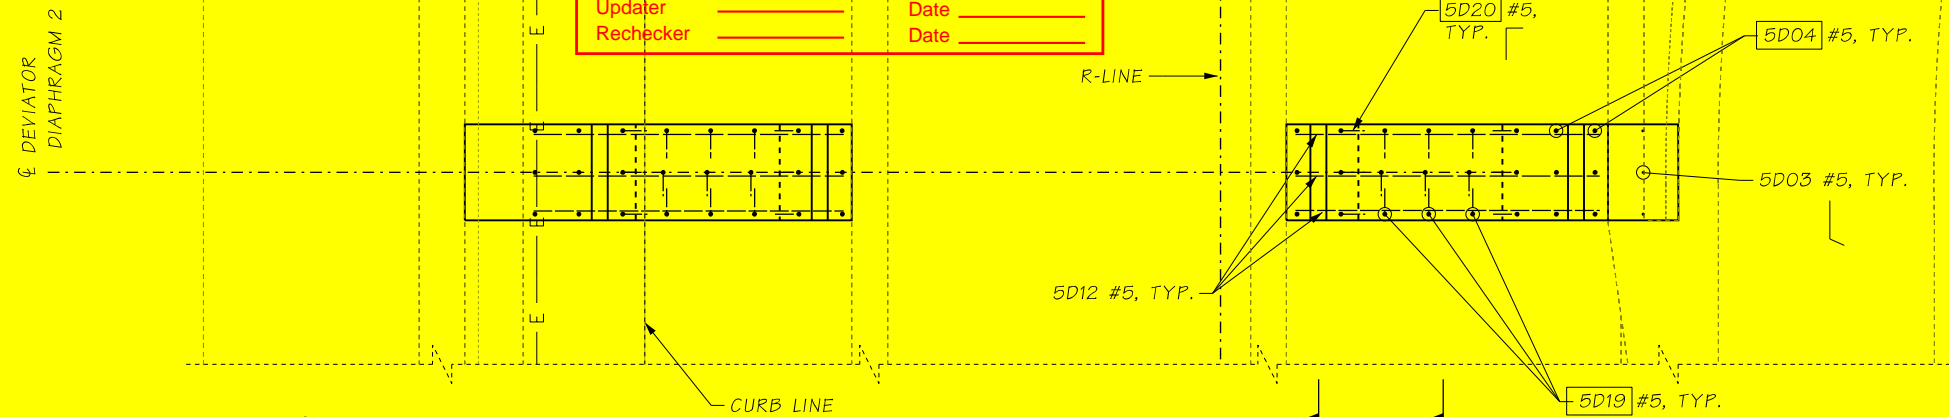

REMOVE SIDEWALK  
WITHIN THE DEMOLITION  
LIMIT AND RESTORE  
AFTER CONSTRUCTION


### PLAN - DEVIATOR DIAPHRAGM 2

NOTE: EXISTING REINFORCEMENT NOT SHOWN

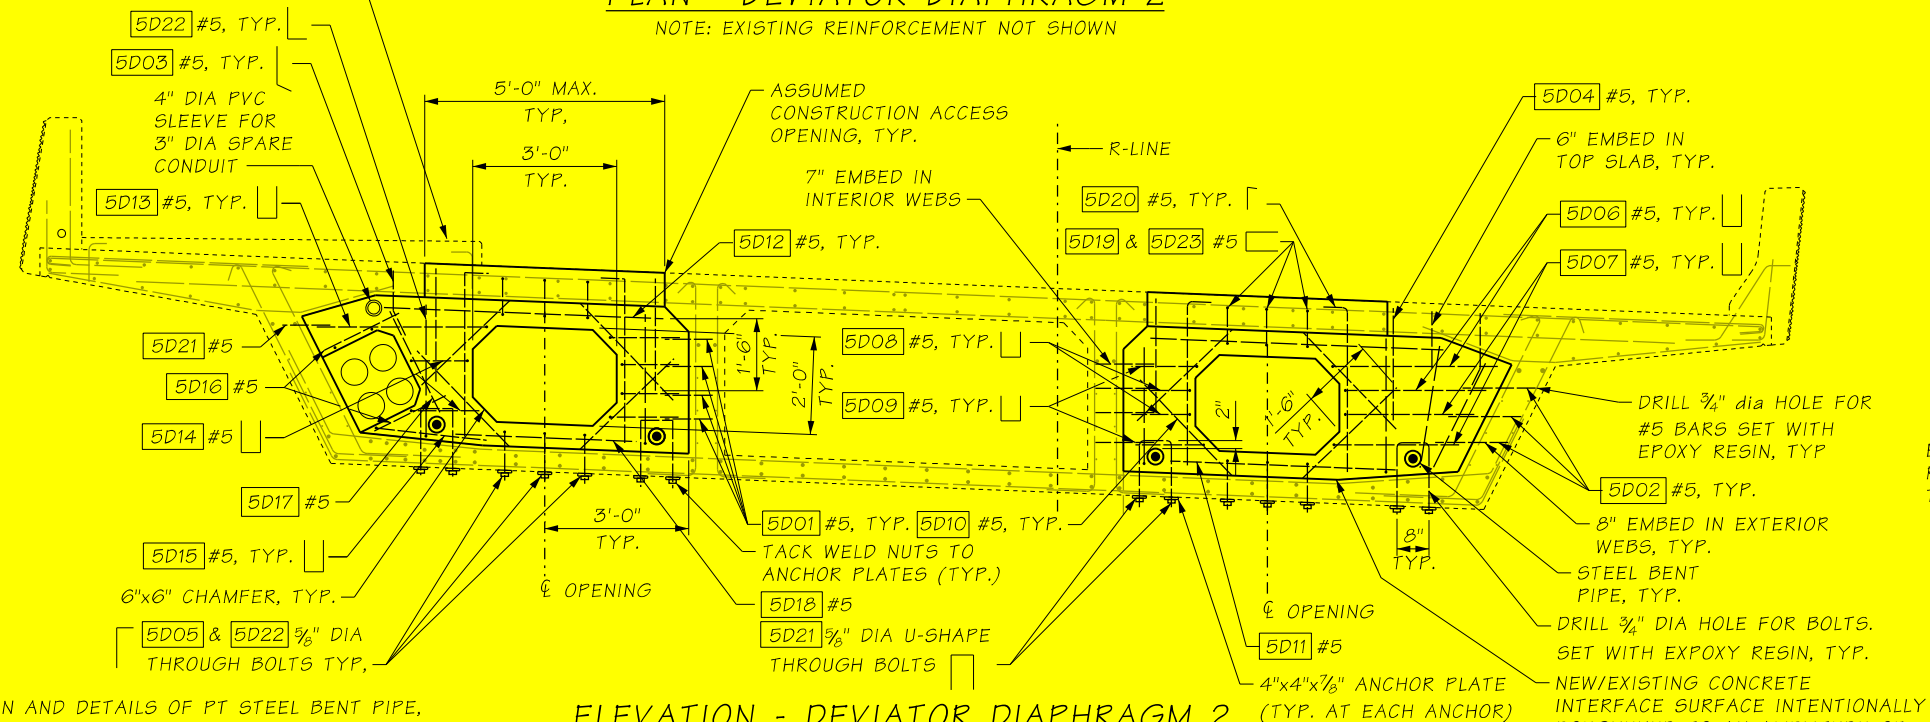


#### NOTES:

- FOR LOCATION AND DETAILS OF PT STEEL BENT PIPE, SEE PLAN REF. NO. BG17.7-25.
- FOR DETAILS OF CONSTRUCTION ACCESS OPENINGS, SEE PLAN REF. NO. BG17.7-15.
- U-SHAPE THROUGH-BOLTS SHALL BE ASTM F1554 GRADE 105 AND STRAIGHT THROUGH-BOLTS SHALL BE ASTM A307 GRADE A.
- DRILL  $\frac{3}{4}$ " DIA HOLE FOR  $\frac{5}{8}$ " DIA BOLTS AND #5 BARS. SET WITH EPOXY RESIN, TYP.

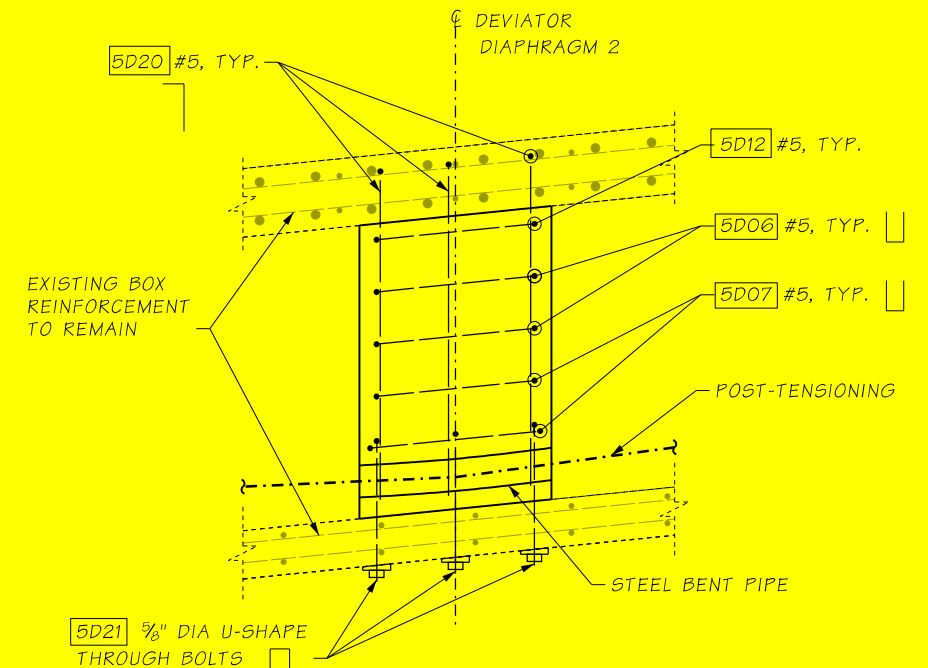

#### SECTION A-A

TYP AT PT-2 AND PT-3

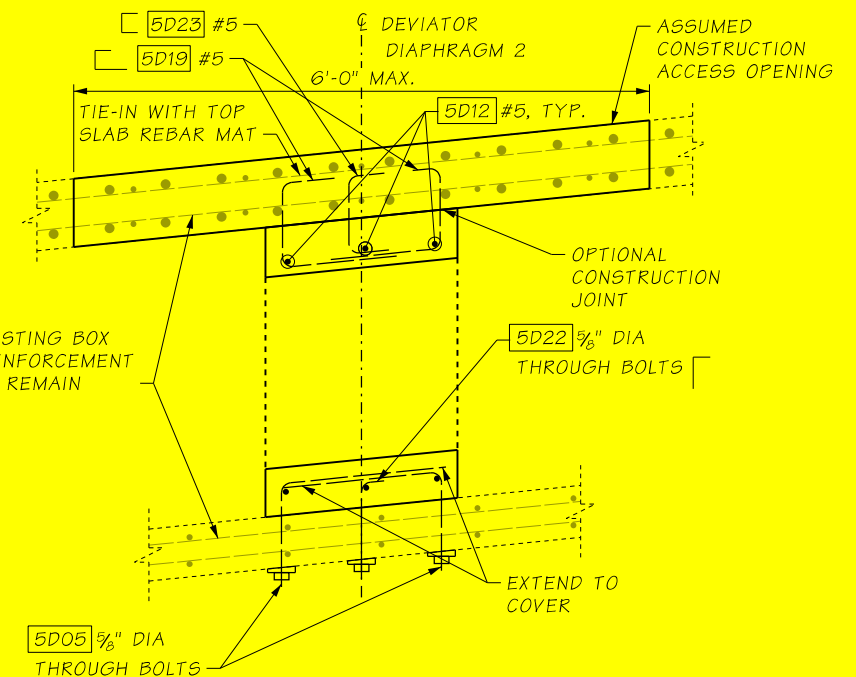


#### SECTION B-B

TYP AT ACCESS OPENINGS

FILE NO. 9242 SHEET I-405

c:\users\mkal\documents\projectwise\workingdir\wsdot\dms22941\XL5467_22_DE_BG_BR17.7-GirdDef11.dgn			
Design Mgr: B. BELL	RELEASE FOR CONSTRUCTION RECORD		REGION NO. STATE
Designed By: B. HU			10 WASH.
Checked By: M. BAUGHMAN			JOB NUMBER
Detailed By: J. GANASSIN			XL5467
Current Revision By:			CONTRACT NO.
Date: 12/20/2021			C9242
Time: 2:03:03 PM	DESCRIPTION	DATE	NO

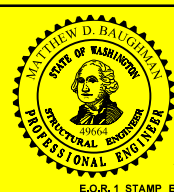

DATE

E.O.R. 1 STAMP BOX

DATE

E.O.R. 2 STAMP BOX



Washington State  
Department of Transportation


FLATIRON LANE  
wood. COWI

I-405; RENTON TO BELLEVUE WIDENING  
AND EXPRESS TOLL LANES PROJECT


BRIDGE 405/17.7 - RENTON AVE OVER I-405

CONCRETE BOX DETAILS 11 OF 13

PLAN REF. NO.  
BG17.7-22  
SHEET  
OF  
SHEETS

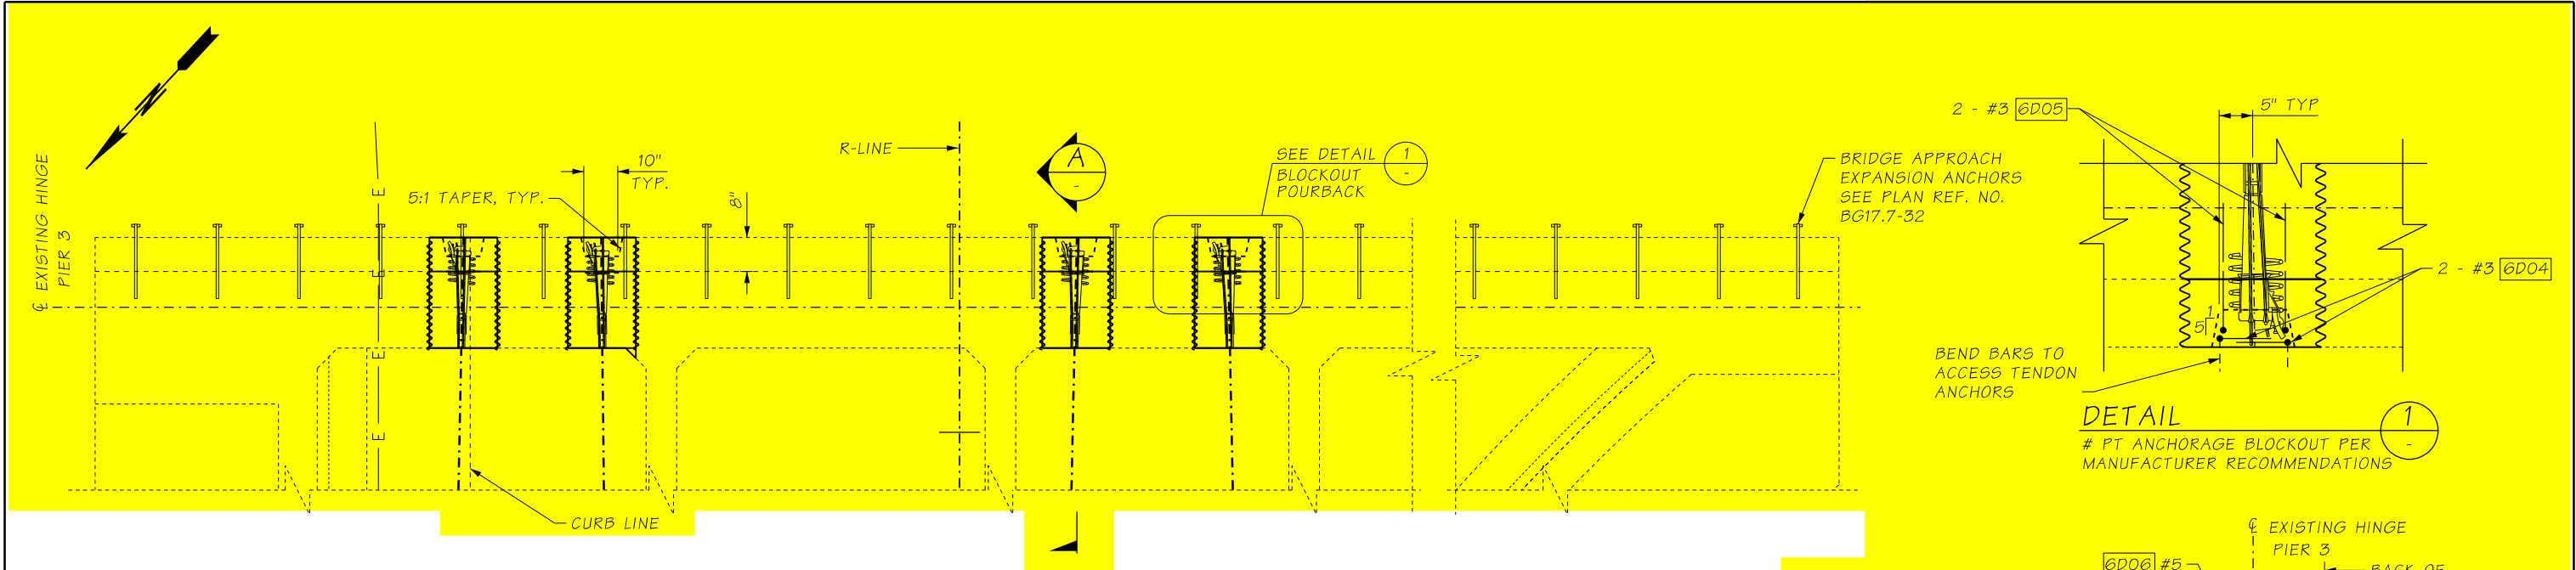

PLAN - EXISTING PIER 3 DIAPHRAGM  
NOTE: EXISTING REINFORCEMENT NOT SHOWN

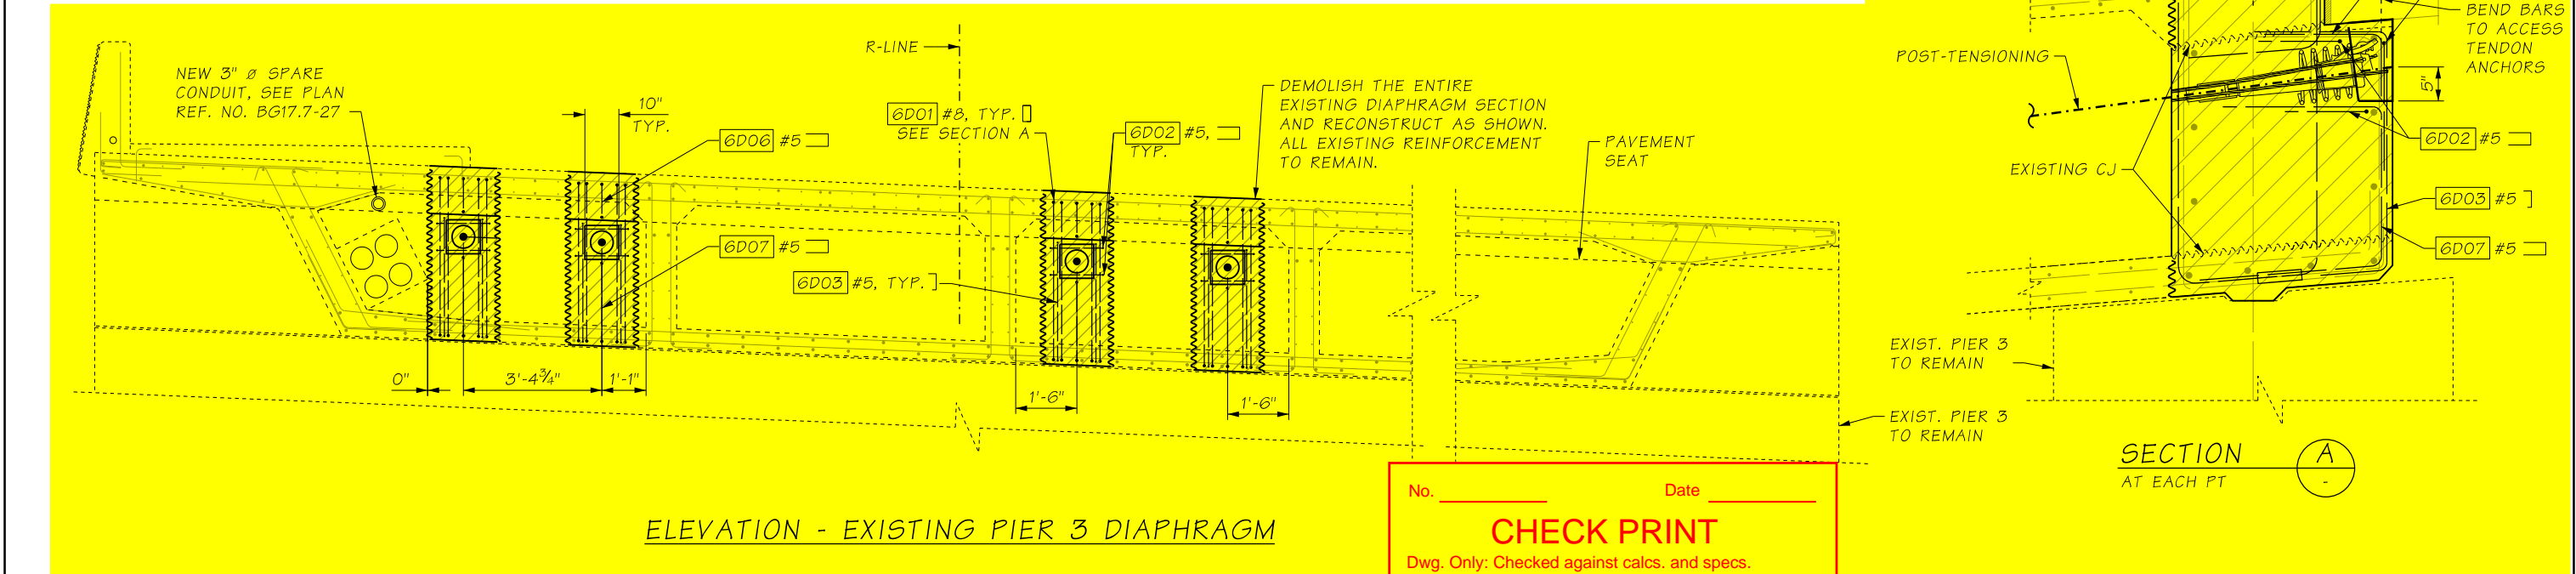

ELEVATION - EXISTING PIER 3 DIAPHRAGM

No. _____	Date _____
<b>CHECK PRINT</b>	
Dwg. Only: Checked against calcs. and specs.	
Confirmed by _____	Date _____
Originator <b>PTWL</b>	Date <b>12/21/2021</b>
Checker <b>MWBM</b>	Date <b>12/21/2021</b>
Backchecker _____	Date _____
Updater _____	Date _____
Rechecker _____	Date _____


- NOTES:
- FOR PT ANCHORAGE LOCATIONS, SEE PLAN BG17.7-25.
  - ALL EXISTING REINFORCEMENT IN THE PIER DIAPHRAGM SHALL REMAIN OR BE RESTORED AFTER CONSTRUCTION.

I-405  
FILE NO. 9242  
SHEET

c:\users\mkal\documents\projectwise\workingdir\wsdot\dms22941\XL5467_23_DE_BG_BR17.7-GirdDef12.dgn									
Design Mgr:	B. BELL	RELEASE FOR CONSTRUCTION RECORD			REGION NO.	STATE	FED. AID, PROJ. NO.	SHEET NO.	TOTAL SHEETS
Designed By:	B. HU				10	WASH.			
Checked By:	M. BAUGHMAN								
Detailed By:	J. GANASSIN					JOB NUMBER			
Current Revision By:						XL5467			
Date:	12/20/2021					CONTRACT NO.			
Time:	2:30:03 PM	DESCRIPTION	DATE	NO		C9242			
					MATTHEW D. BAUGHMAN STATE OF WASHINGTON PROFESSIONAL ENGINEER E.O.R. 1 STAMP BOX		DATE	E.O.R. 2 STAMP BOX	
							DATE		
					Washington State Department of Transportation		I-405; RENTON TO BELLEVUE WIDENING AND EXPRESS TOLL LANES PROJECT		PLAN REF. NO. BG17.7-23
					FLATIRON LANE		BRIDGE 405/17.7 - RENTON AVE OVER I-405		SHEET
					wood. COWI		CONCRETE BOX DETAILS 12 OF 13		OF
									SHEETS






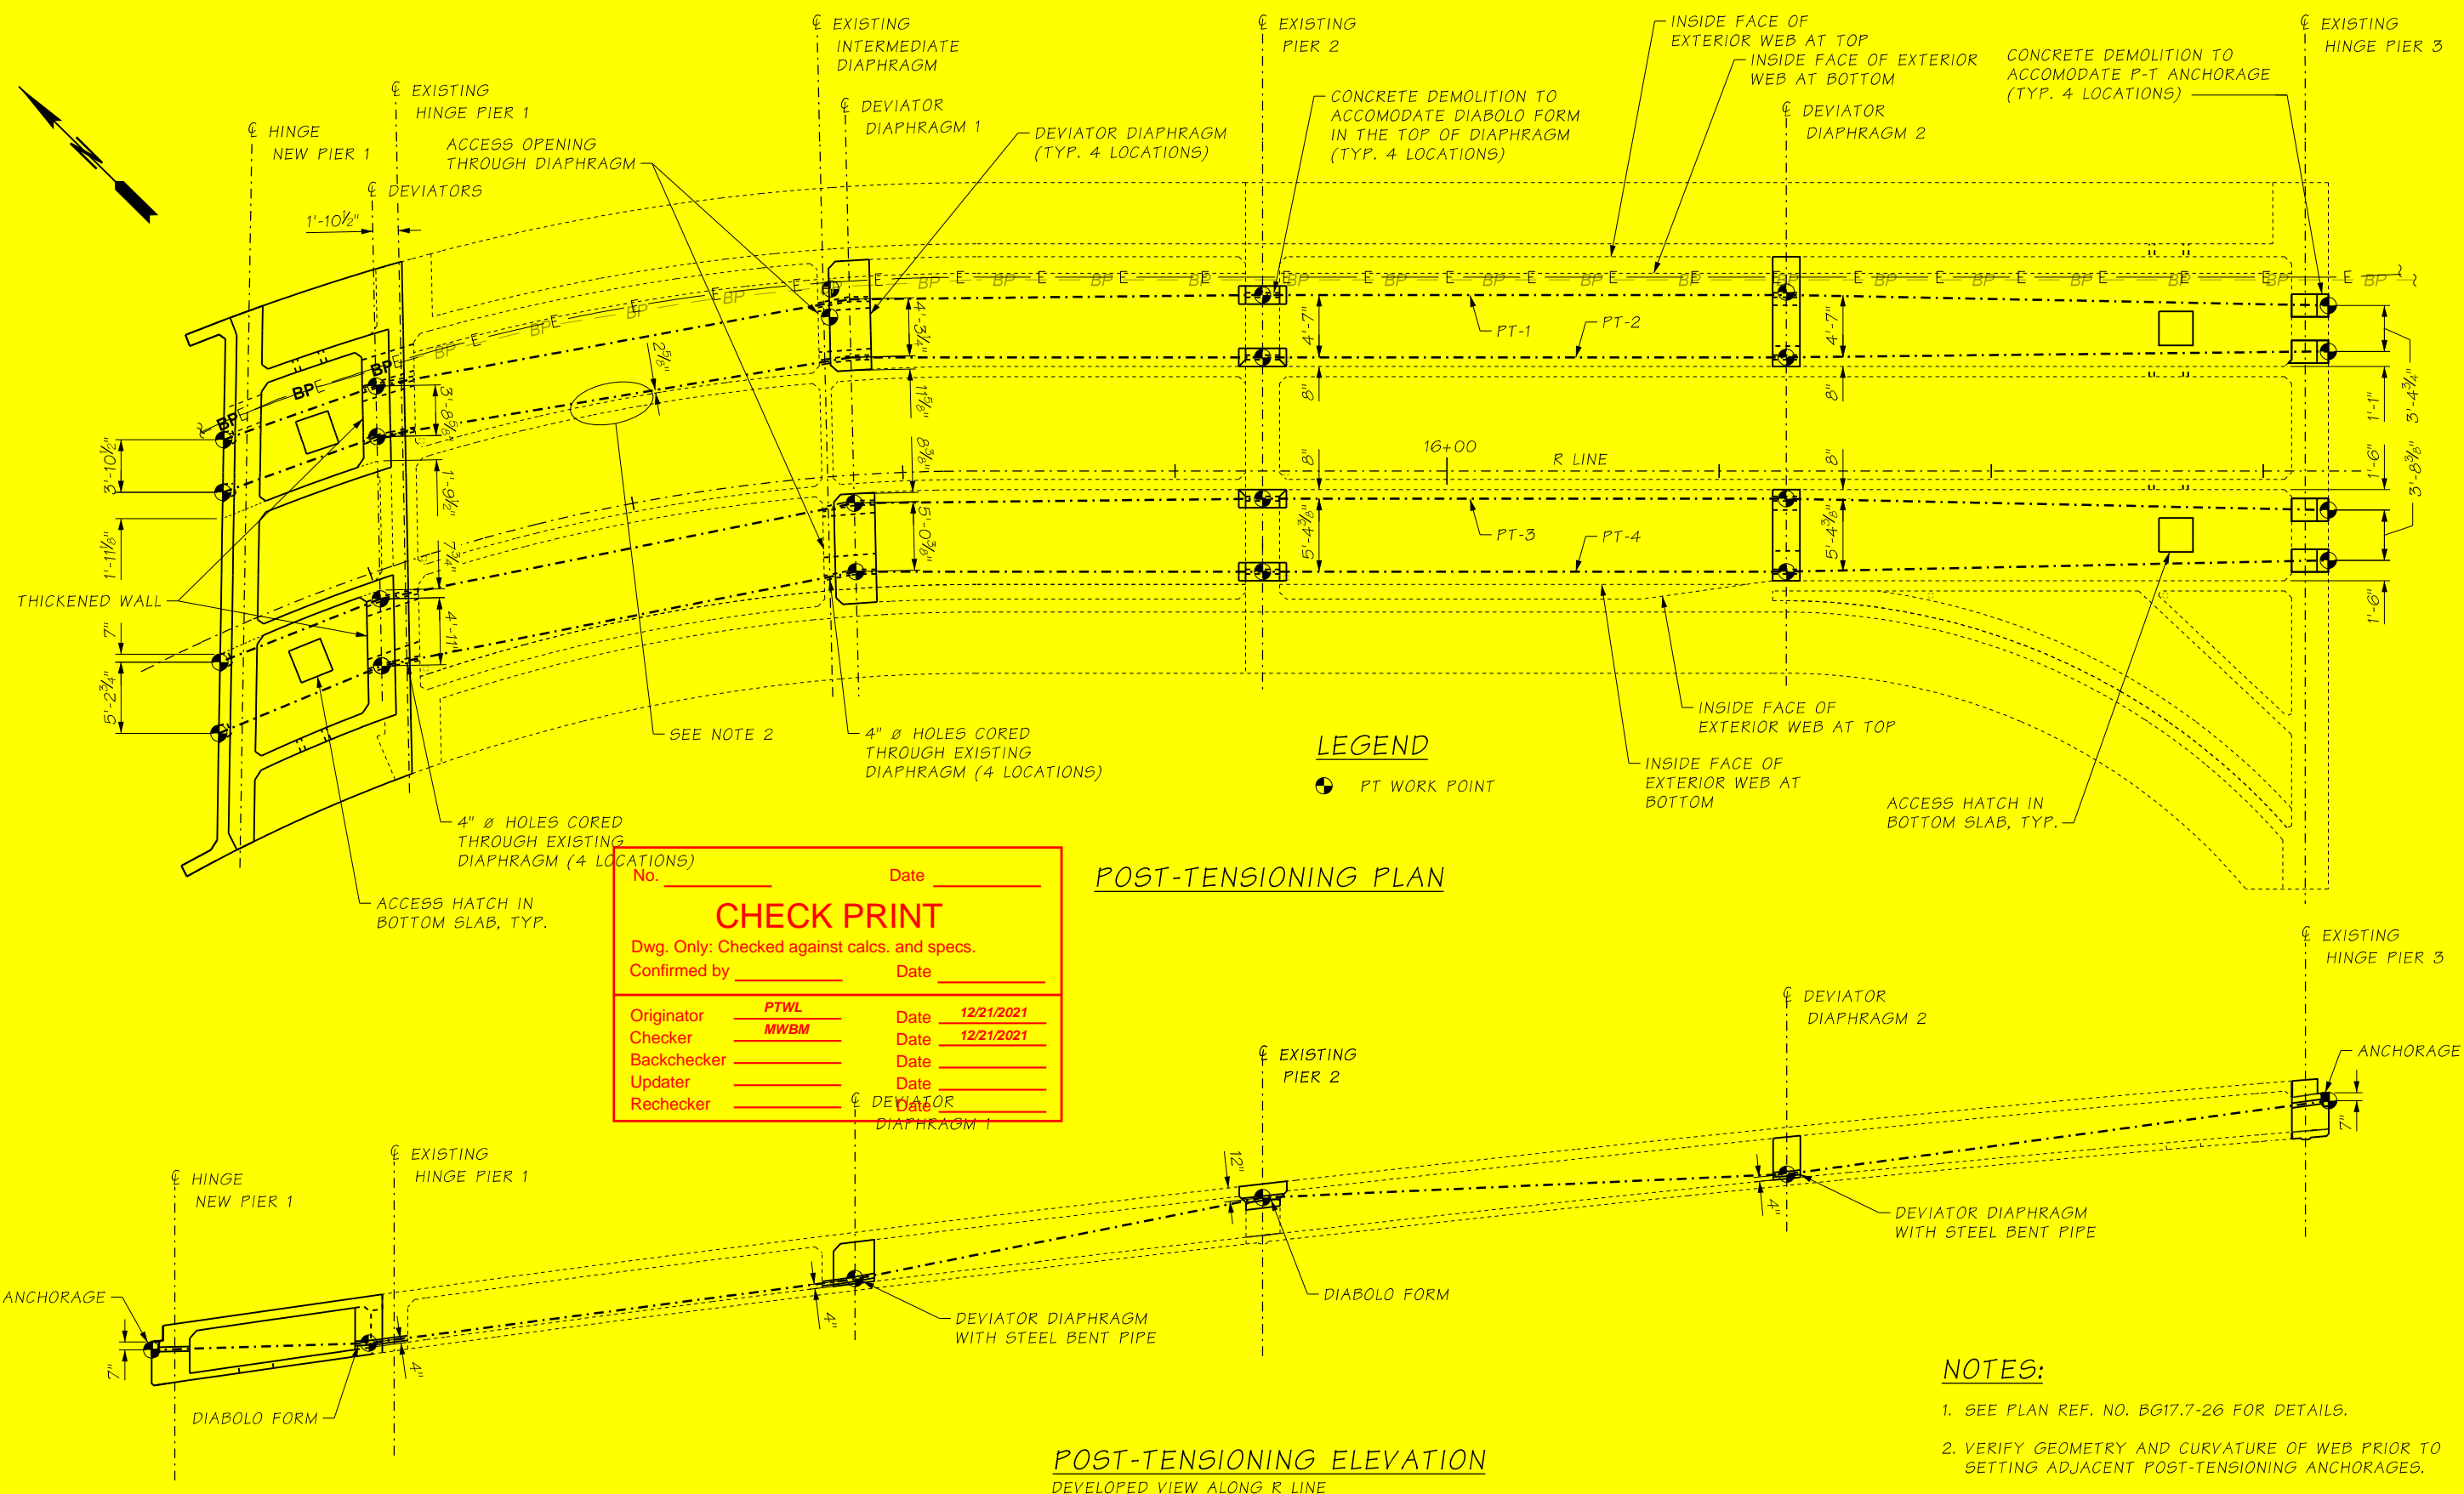

c:\users\jagn\documents\projectwise\workingdir\wsdot\dms22941\XL5467\_25\_DE\_BG\_BR17.7-PTLayout.dgn

Design Mgr:	B. BELL	RELEASE FOR CONSTRUCTION RECORD		REGION NO.	STATE	FED. AID, PROJ. NO.	SHEET NO.	TOTAL SHEETS
Designed By:	B. HU			10	WASH.			
Checked By:	M. BAUGHMAN				JOB NUMBER			
Detailed By:	J. GANASSIN				XL5467			
Current Revision By:					CONTRACT NO.			
Date:	12/15/2021				C9242			
Time:	4:30:16 PM	DESCRIPTION	DATE	NO				

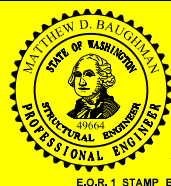

DATE

E.O.R. 2 STAMP BOX

Washington State  
Department of Transportation

FLATIRON LANE

wood. COWI

I-405; RENTON TO BELLEVUE WIDENING  
AND EXPRESS TOLL LANES PROJECT

BRIDGE 405/17.7 - RENTON AVE OVER I-405

POST-TENSIONING LAYOUT

PLAN REF. NO.

BG17.7-25


SHEET

OF


SHEETS

TENDON INFORMATION TABLE

TENDON DESIGNATION	NUMBER OF STRANDS	TENDON LENGTH (ft)	TENDON WEIGHT (lbs)	STRESSING FORCE/TENDON (kips)	STRESSING END	LIVE END FORCE AFTER ANCHOR SET (kips)	DEAD END FORCE AFTER ANCHOR SET (kips)	ELONGATION BEFORE ANCHOR SET (in)	ELONGATION AFTER ANCHOR SET (in)	STRESSING SEQUENCE
PT-1	7	157.2	814	332	PIER 1	274	180	10.2	8.5	3
PT-2	7	157.2	814	332	PIER 1	272	180	10.2	8.5	1
PT-3	7	157.8	818	332	PIER 1	273	179	10.2	8.5	2
PT-4	7	158.0	819	332	PIER 1	272	178	10.2	8.5	4

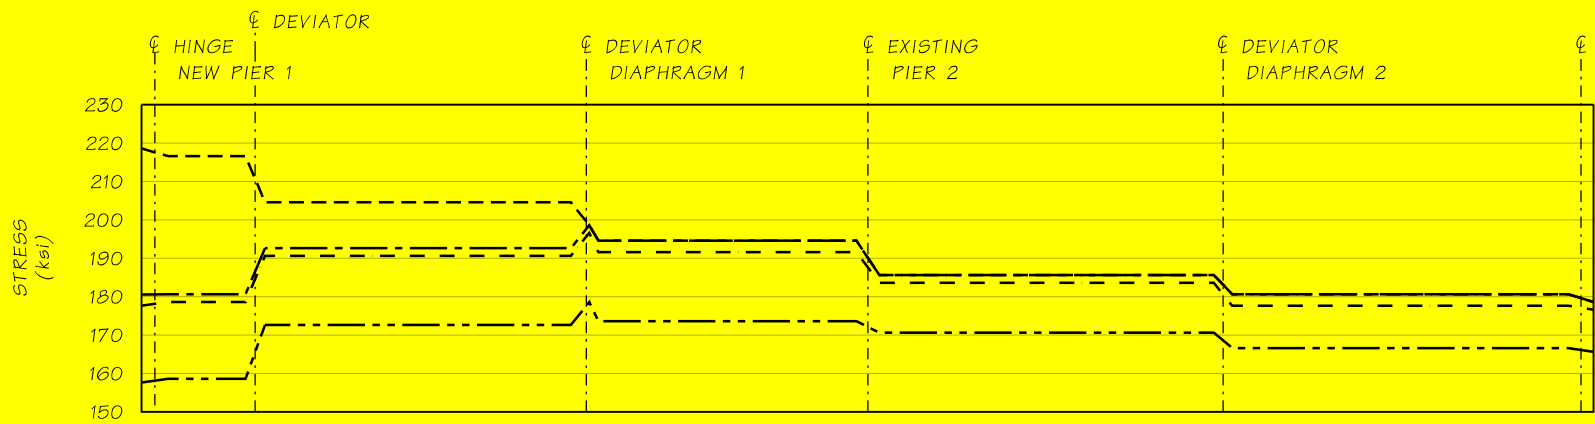

AVERAGE STRESS IN  
POST-TENSIONING TENDONS

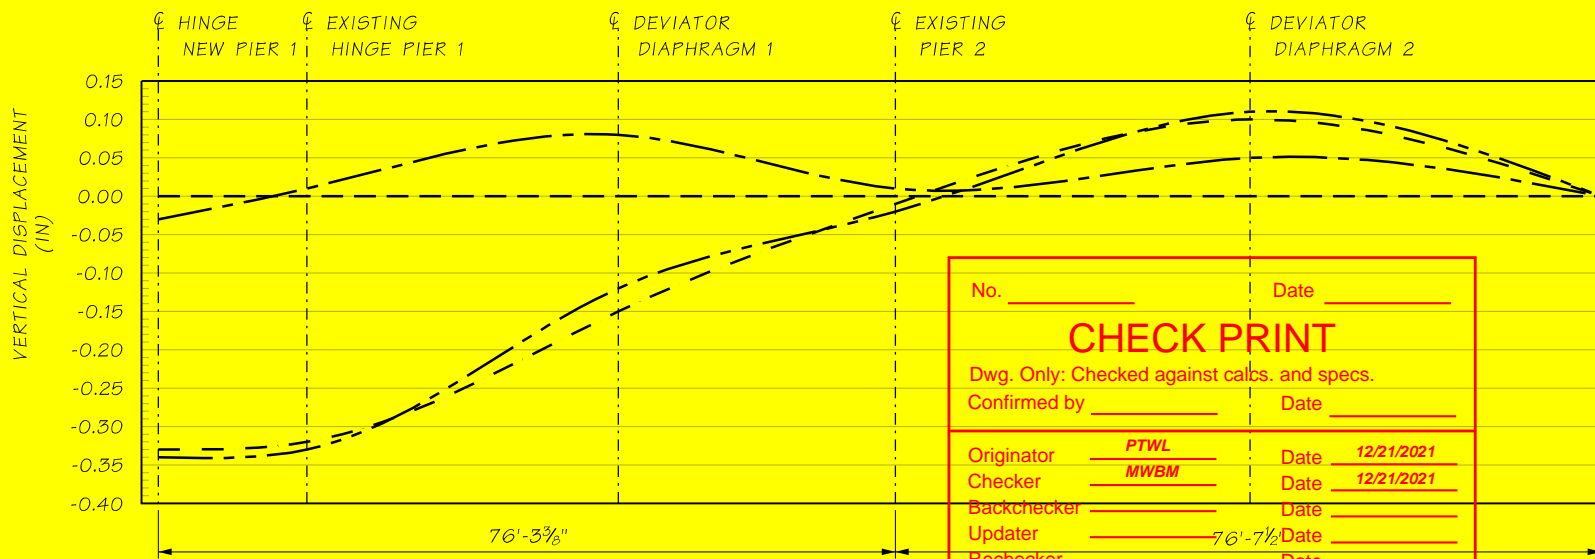

NOTE:  
ANTICIPATED DEFLECTION DIAGRAM INCLUDES ANTICIPATED SETTLEMENT OF PIER 1 FOOTING DUE TO LOADING FROM BRIDGE AND RETAINING WALL 03.63L BACKFILL.

ANTICIPATED DEFLECTION

LEGEND

- TENDONS AT JACKING
- .- TENDONS AT TRANSFER (AFTER FRICTION AND ANCHOR SET)
- ... SHORT-TERM EFFECTIVE TENDON STRESSES
- \_\_\_ LONG-TERM EFFECTIVE TENDON STRESSES (AFTER ALL LOSSES)

LEGEND

- EXISTING CONDITION AND NEW BOX EXTENSION ON FALSEWORK
- .- AFTER STRESSING OF PT
- ... AFTER REMOVAL OF EXISTING PIER 1
- \_\_\_ END OF CONSTRUCTION

NOTES:

- POST-TENSIONING SHALL BE IN ACCORDANCE WITH SECTION 6-02.3(26) OF THE WSDOT STANDARD SPECIFICATIONS, UNLESS NOTED OTHERWISE.
- POST-TENSIONING LAYOUT IS AS SHOWN ON PLAN REF. NO. BG17.7-25.
- THE MINIMUM COMPRESSIVE STRENGTH OF THE CAST-IN-PLACE CONCRETE AT THE TIME OF POST-TENSIONING SHALL BE 5.0ksi.
- THE MAXIMUM OUTSIDE DIAMETER OF THE DUCT SHALL BE 2.875 INCHES. THE AREA OF THE DUCT SHALL BE AT LEAST 2.5 TIMES THE NET AREA OF THE POST-TENSIONING STEEL IN THE DUCT.
- THE DESIGN IS BASED ON 0.6" DIA LOW RELAXATION STRANDS WITH AN ANCHOR SET OF 3/8". A CURVATURE FRICTION COEFFICIENT,  $\mu$  = 0.20 AND A WOBBLE FRICTION COEFFICIENT,  $k$  = 0.0002/FT. THE ACTUAL ANCHOR SET AND JACKING FORCE USED BY THE CONTRACTOR SHALL BE SPECIFIED IN THE SHOP PLANS AND INCLUDED IN THE TRANSFER FORCE CALCULATIONS.
- THE DESIGN IS BASED ON THE ESTIMATED PRESTRESS LOSS OF POST-TENSIONING STRANDS SHOWN IN THE POST-TENSIONING TABLE DUE TO STEEL RELAXATION, AND ELASTIC SHORTENING, CREEP AND SHRINKAGE OF CONCRETE.
- THE CONTRACTOR SHALL SUBMIT THE STRESSING SEQUENCE AND ELONGATION CALCULATIONS TO THE ENGINEER FOR APPROVAL. ALL LOSSES DUE TO TENDON VERTICAL AND HORIZONTAL CURVATURE MUST BE INCLUDED IN ELONGATION CALCULATIONS. THE STRESSING SEQUENCE SHALL BE AS SHOWN IN THE TENDON INFORMATION TABLE.
- ALL TENDONS SHALL BE STRESSED FROM ONE END, AS SHOWN IN TENDON INFORMATION TABLE.
- PROVIDE SPIRAL REINFORCEMENT AROUND ANCHORAGE HARDWARE AS PER SUPPLIER'S REQUIREMENTS.
- STEEL BENT PIPES SHALL BE RIGID GALVANIZED STEEL PIPE CONFORMING TO THE REQUIREMENTS OF ASTM A53, TYPE E, GRADE B. THE PIPE SHALL BE SCHEDULE 40 WITH ID OF 2.47 IN. THE PIPE SHALL BE BENT SO AS TO ACCURATELY CONFORM TO THE ALIGNMENT OF THE TENDON TAKING INTO CONSIDERATION THE MINIMUM BENDING RADIUS OF 6 FT.
- WHERE DIABOLOS ARE SPECIFIED IN PLANS, CONTRACTOR MAY USE STEEL BENT PIPES OR DIABOLOS. DIABOLO FORMS SHALL BE HDPE. WORKING DRAWINGS OF THE PROPOSED SYSTEM SHALL BE SUBMITTED TO THE ENGINEER FOR ACCEPTANCE AND APPROVAL, INCLUDING DEMONSTRATION OF PRIOR SUCCESSFUL USE IN SIMILAR BRIDGES.
- EFFECTIVE STRESS AFTER ALL LOSSES VARIES ALONG THE TENDON LENGTH. SEE PROVIDED CHART FOR THEORETICAL STRESSES.
- TENDON ELONGATIONS PROVIDED INCLUDE ESTIMATED ELASTIC SHORTENING OF THE BOX GIRDER AT JACKING AND AFTER ANCHOR SET.
- TENDON LENGTHS ARE MEASURED BETWEEN OUTER FACE OF ANCHOR PLATES ALONG THE CENTERLINE OF DUCTS. MEASUREMENTS SHOWN ALONG  $\phi$  BOX ARE PROVIDED FOR REFERENCE ONLY.
- SEE PLAN REF NO BG17.7-03 FOR CONSTRUCTION SEQUENCE.

c:\users\mkal\documents\projectwise\workingdir\wsdot\dms22941\XL5467\_26\_DE\_BG\_BR17.7-PTDetails.dgn

Design Mgr:	B. BELL	RELEASE FOR CONSTRUCTION RECORD				REGION NO.	STATE	FED. AID, PROJ. NO.	SHEET NO.	TOTAL SHEETS
Designed By:	B. HU					10	WASH.			
Checked By:	M. BAUGHMAN						JOB NUMBER			
Detailed By:	J. GANASSIN						XL5467			
Current Revision By:							CONTRACT NO.			
Date:	12/16/2021						C9242			
Time:	3:08:24 PM	DESCRIPTION	DATE	NO						



DATE

E.O.R. 1 STAMP BOX

DATE

E.O.R. 2 STAMP BOX



Washington State  
Department of Transportation

FLATIRON LANE

wood. COWI

I-405; RENTON TO BELLEVUE WIDENING  
AND EXPRESS TOLL LANES PROJECT

BRIDGE 405/17.7 - RENTON AVE OVER I-405

POST-TENSIONING DETAILS


PLAN REF. NO.

BG17.7-26

SHEET

OF


SHEETS

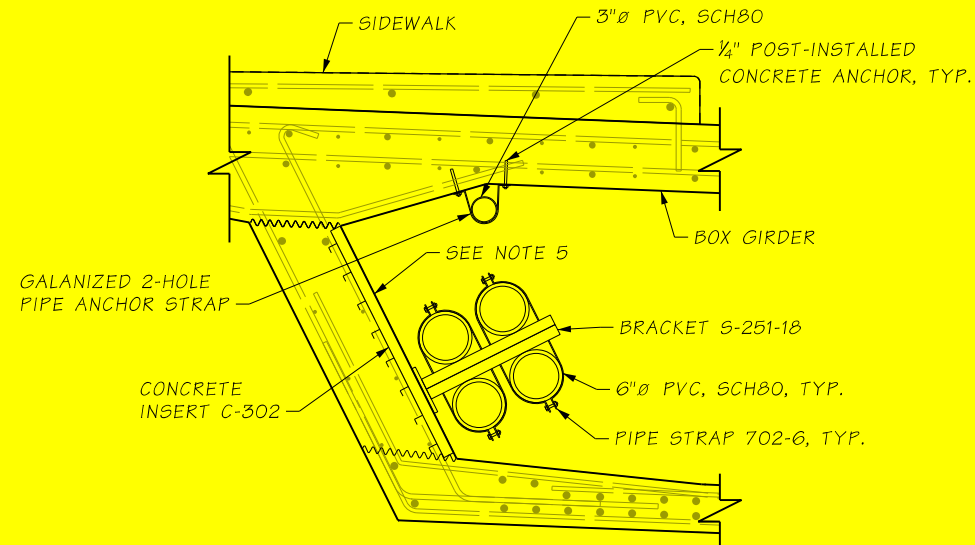

#### NOTES:

- POWER CONDUIT SUPPORTS ASSUME USE OF SUPERSTRUT BY THOMAS & BETTS, OR APPROVED EQUAL.
- ALL MATERIALS USED SHALL BE GALVANIZED.
- POWER CONDUIT SUPPORTS SHALL BE INSTALLED AT 5'-0" MAXIMUM ON CENTER SPACING THROUGH THE BRIDGE LENGTHENING. BRACKETS SHALL BE 1 FOOT MINIMUM FROM FACE OF DIAPHRAGMS.
- CONCRETE INSERTS SHALL BE INSTALLED COMPLETE WITH END CAPS AND FOAM FILLER.
- CONCRETE INSERT SHALL BE INSTALLED FLUSH WITH INTERIOR FACE OF WEB.



#### CONDUIT SUPPORT SHOWN IN NEW BOX LENGTHENING

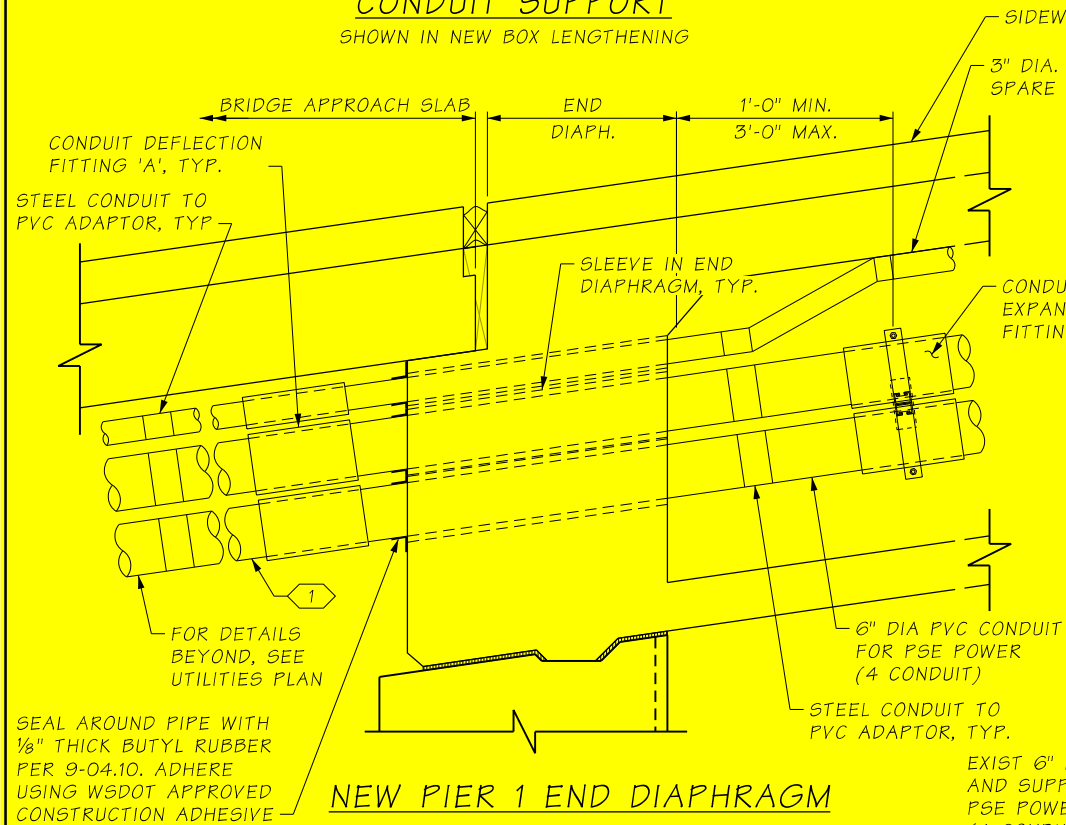

#### NOTES:

- ALL EXISTING ELEMENTS SHOWN ARE BASED ON AVAILABLE AS-BUILT PLANS.
- NEW SPARE CONDUIT SHALL BE HELD IN PLACE WITH GALVANIZED 2-HOLE PIPE ANCHOR STRAPS AT 5'-0" MAXIMUM SPACING. STRAPS SHALL BE ANCHORED TO TOP SLAB OF EXISTING BOX GIRDER USING 1/4" POST-INSTALLED CONCRETE ANCHORS.
- CONTRACTOR SHALL SUBMIT WORKING DRAWING SHOWING LIMIT OF DEMOLITION AND RECONSTRUCTION TO ENGINEER.

#### CONDUIT SUPPORT SHOWN IN EXISTING BOX

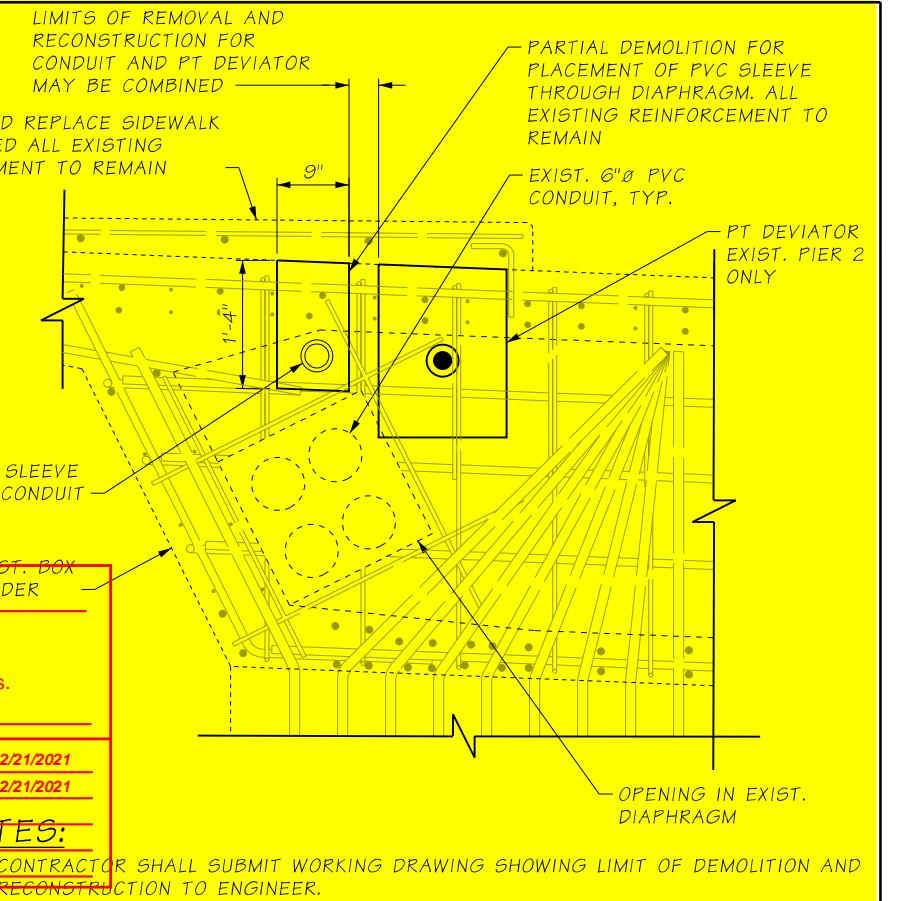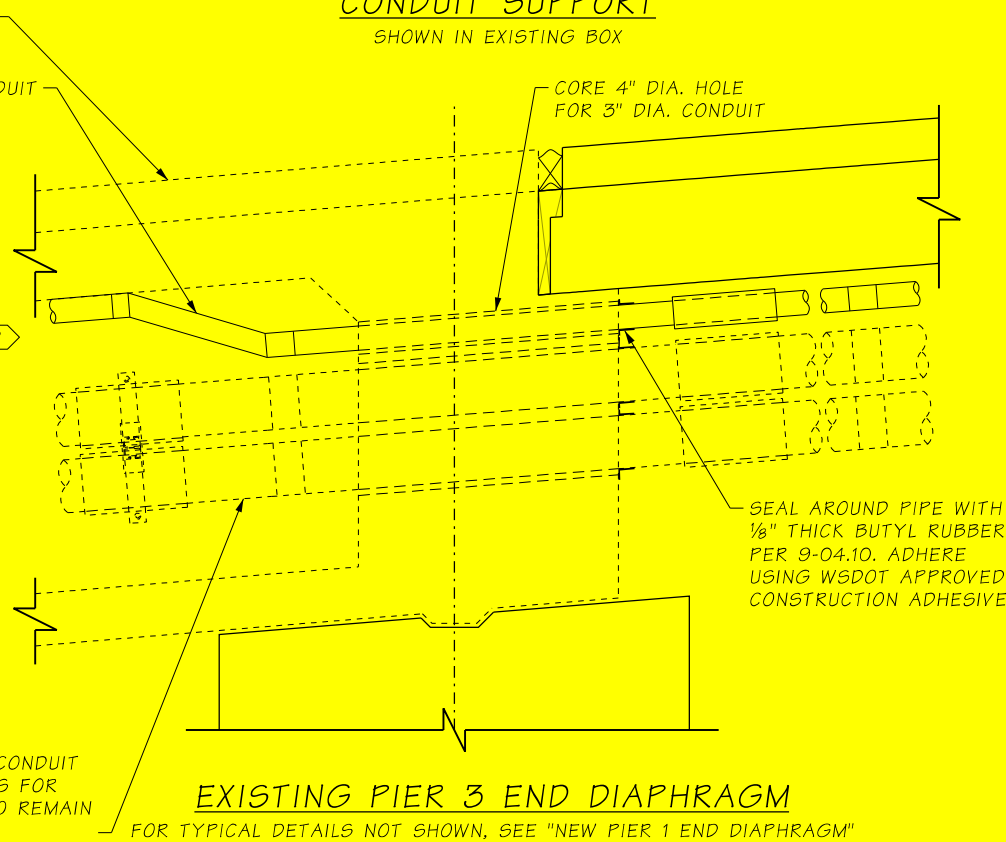

#### EXISTING DIAPHRAGM BLOCKOUTS

EXISTING PIER 2 DIAPHRAGM SHOWN, EXISTING PIER 1, INTERMEDIATE, AND PIER 3 DIAPHRAGMS SIMILAR.

#### GENERAL NOTES:


- SET POSITION OF EXPANSION FITTING BASED ON MANUFACTURER RECOMMENDATIONS AND TEMPERATURE AT TIME OF INSTALLATION.
- ONE EXPANSION FITTING SHALL BE INSTALLED NEAR NEW PIER 1 AS SHOWN. EXPANSION FITTINGS SHALL ACCOMMODATE 5.1 INCHES OF MOVEMENT. THE DESIGN TEMPERATURE RANGE IS 125 DEGREES (-15° TO 110°).
- SEE PLAN REF. NO. BG17.7-31 FOR CONDUIT DEFLECTION FITTING 'A' DETAIL.
- SEE PLAN REF. NO. BG17.7-16 BG17.7-23 FOR POWER CONDUITS PLACEMENT DETAILS AT END DIAPHRAGMS.
- CONDUIT SHALL BE TESTED IN ACCORDANCE WITH UTILITY OWNER REQUIREMENTS AND COORDINATED TO ALLOW TESTING TO BE WITNESSED BY OWNER IF REQUIRED.

#### NOTES:

- 10'-0" STEEL CONDUIT SECTION BETWEEN CONDUIT DEFLECTION FITTING A AND PVC CONDUIT ADAPTOR
- RESTRAIN BARREL END OF CONDUIT EXPANSION FITTING

c:\users\mkal\documents\projectwise\workingdir\wsdot\dms22941\XL5467_27_DE_BG_BR17.7-U\11Support.dgn			
Design Mgr:	B. BELL	RELEASE FOR CONSTRUCTION RECORD	
Designed By:	B. HU		
Checked By:	M. BAUGHMAN		
Detailed By:	K. BUNGER		
Current Revision By:			
Date:	12/20/2021		
Time:	11:28:12 AM		


REGION NO.	STATE	FED. AID, PROJ. NO.	SHEET NO.	TOTAL SHEETS
10	WASH.			
JOB NUMBER				
XL5467				
CONTRACT NO.				
C9242				

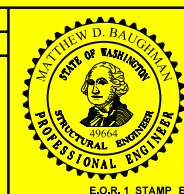

DATE	DATE
E.O.R. 1 STAMP BOX	E.O.R. 2 STAMP BOX



I-405; RENTON TO BELLEVUE WIDENING AND EXPRESS TOLL LANES PROJECT		PLAN REF. NO. BG17.7-27
BRIDGE 405/17.7 - RENTON AVE OVER I-405		SHEET OF SHEETS
UTILITY SUPPORTS		

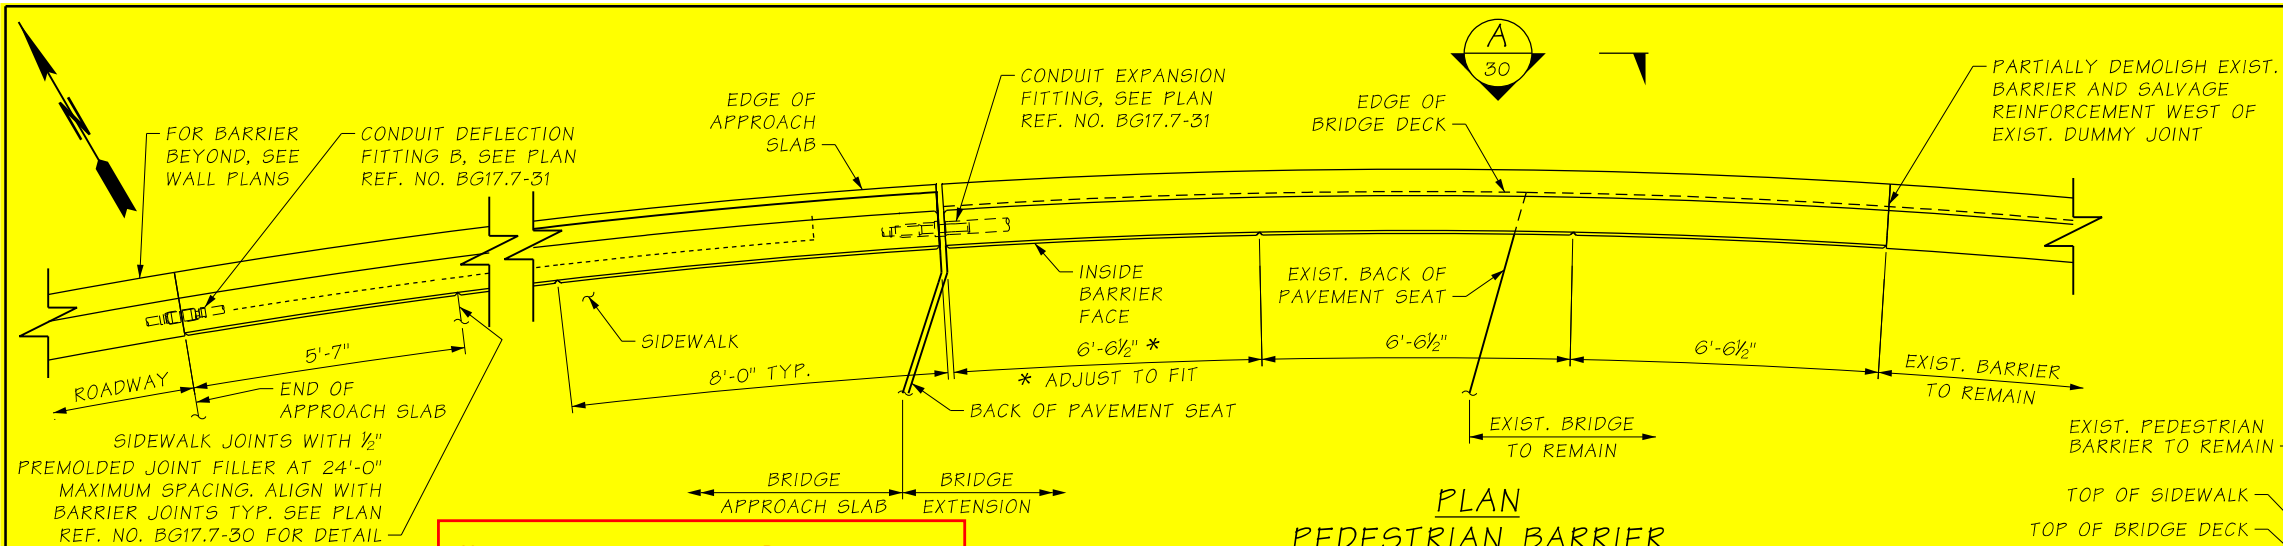


### PLAN PEDESTRIAN BARRIER

BARRIER CONTINUOUS BETWEEN BRIDGE DECK EXPANSION JOINTS.  
CONSTRUCTION JOINTS WITH SHEAR KEYS ARE PERMISSIBLE AT DUMMY JOINT LOCATIONS.  
FORM JOINTS BETWEEN DUMMY JOINTS SHALL NOT BE PERMITTED.


No. _____	Date _____
<b>CHECK PRINT</b>	
Dwg. Only: Checked against calcs. and specs.	
Confirmed by _____	Date _____
Originator <u>PTWL</u>	Date <u>12/21/2021</u>
Checker <u>MWBM</u>	Date <u>12/21/2021</u>
Backchecker _____	Date _____
Updater _____	Date _____
Rechecker _____	Date _____

### NOTES:


- 1 MIN. HEIGHT. PEDESTRIAN BARRIER HEIGHT MAY VARY IF REQUIRED TO PROVIDE A SMOOTH PROFILE.
- 2 REMAINING REINFORCING SHALL BE CLEANED BEFORE NEW CONCRETE IS PLACED.

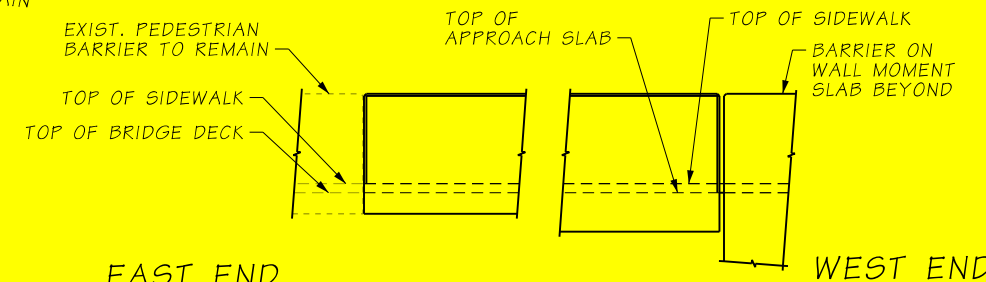

### OUTSIDE ELEVATION NORTH PEDESTRIAN BARRIER SOUTH PEDESTRIAN BARRIER SIMILAR

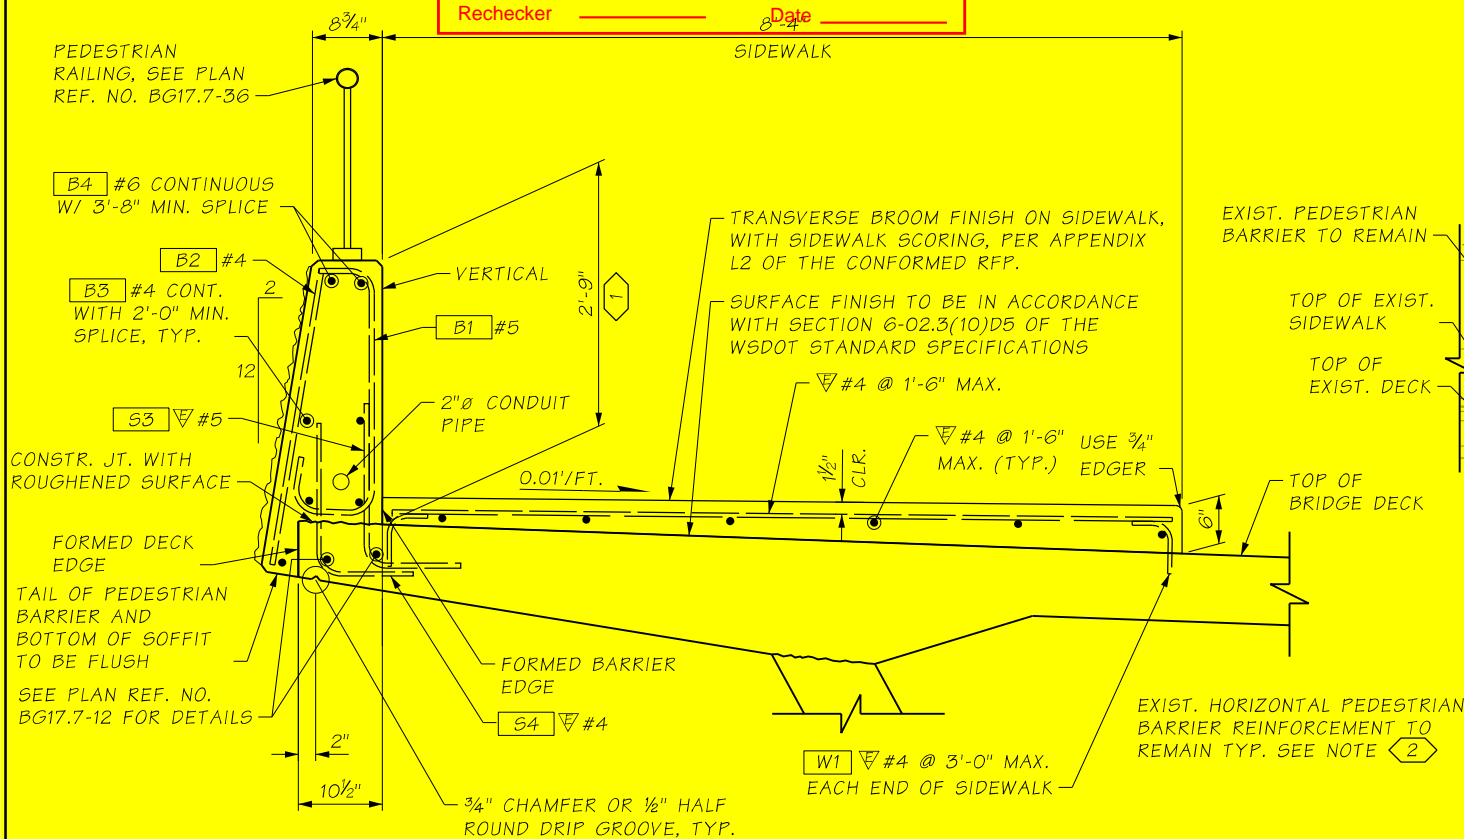

### TYPICAL SECTION - PEDESTRIAN BARRIER SHOWN ON BRIDGE

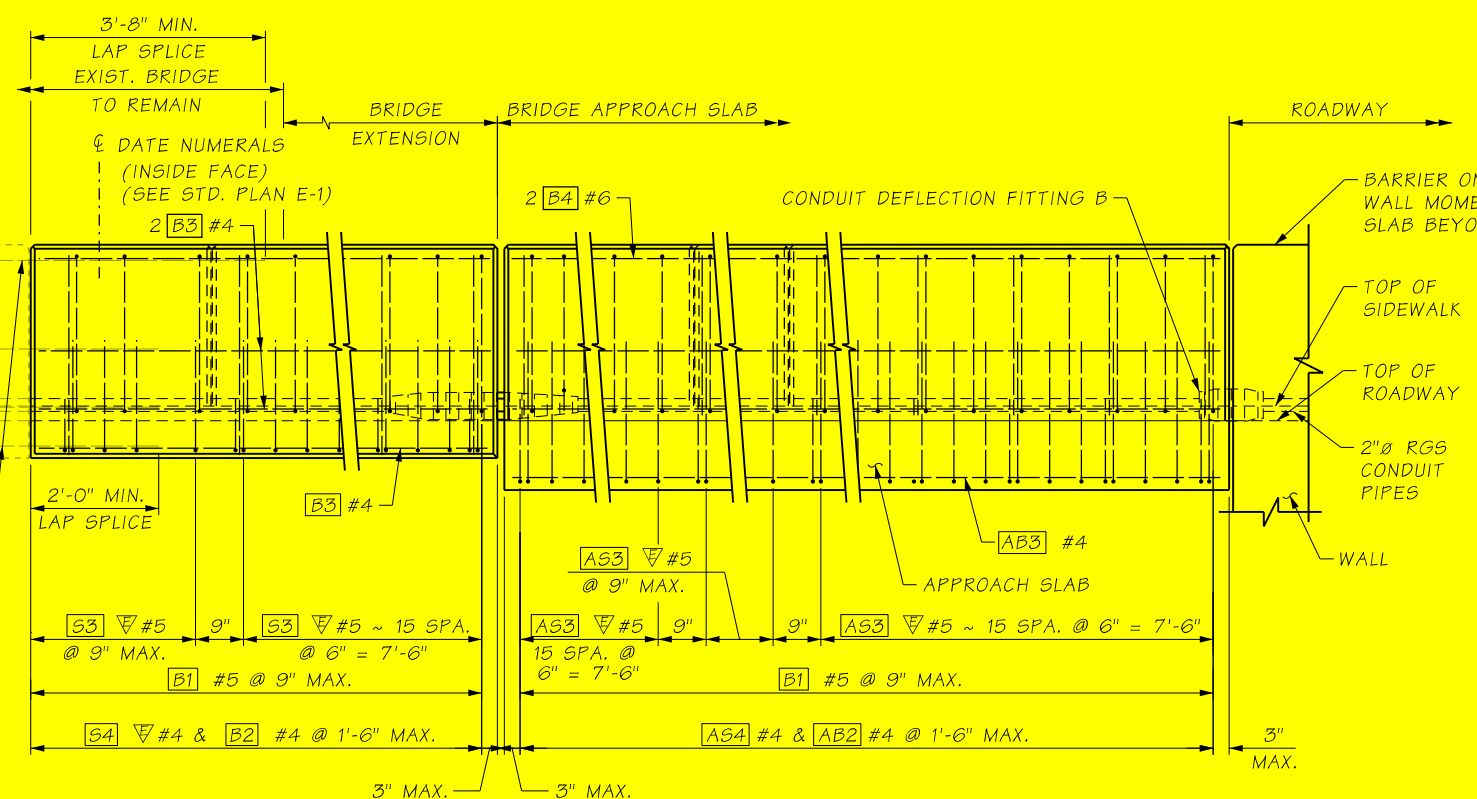

### OUTSIDE ELEVATION - END OF PEDESTRIAN BARRIER

I-405 FILE NO. 9242 SHEET

c:\users\mkal\documents\projectwise\workingdir\wsdot\dms22941\XL5467_28_DE_BG_BG17.7-Barrier1.dgn			
Design Mgr: BRIAN BELL	RELEASE FOR CONSTRUCTION RECORD		
Designed By: F.C. CAJAS		REGION NO. 10	STATE WASH.
Checked By: M. BAUGHMAN		JOB NUMBER XL5467	
Detailed By: M. AASAL		CONTRACT NO. C9242	
Current Revision By:			
Date: 12/16/2021			
Time: 3:13:19 PM	DESCRIPTION	DATE	NO



E.O.R. 1 STAMP BOX	DATE
E.O.R. 2 STAMP BOX	DATE


Washington State  
Department of Transportation

**FLATIRON LANE**



**wood. COWI**

I-405; RENTON TO BELLEVUE WIDENING AND EXPRESS TOLL LANES PROJECT		PLAN REF. NO. BG17.7-28
BRIDGE 405/17.7 - RENTON AVE OVER I-405		SHEET OF SHEETS
BARRIER DETAILS 1 OF 4		



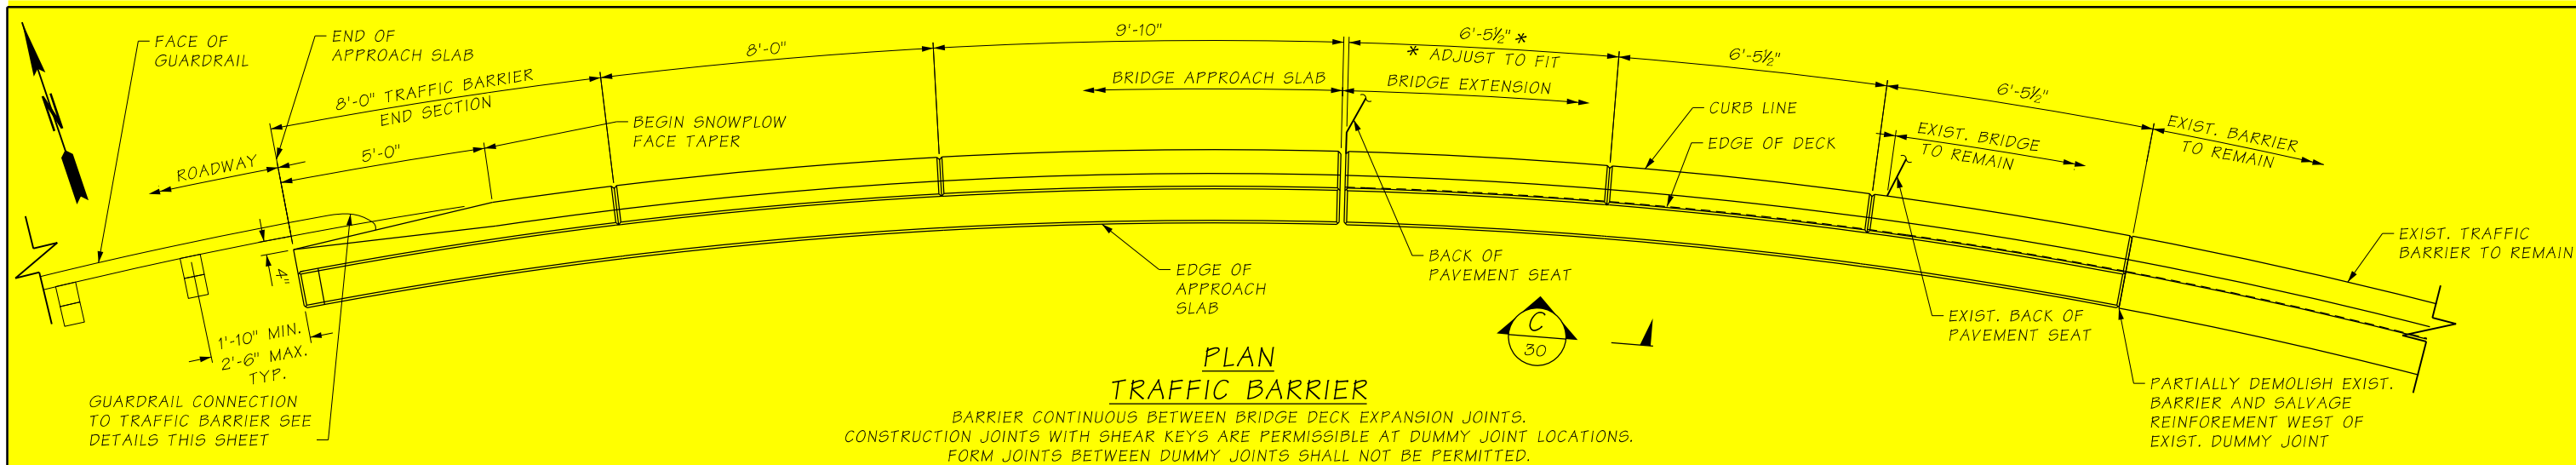

No. _____	Date _____
<b>CHECK PRINT</b>	
Dwg. Only: Checked against calcs. and specs.	
Confirmed by _____	Date _____
Originator <u>PTWL</u>	Date <u>12/21/2021</u>
Checker <u>MWBM</u>	Date <u>12/21/2021</u>
Backchecker _____	Date _____
Updater _____	Date _____
Rechecker _____	Date _____

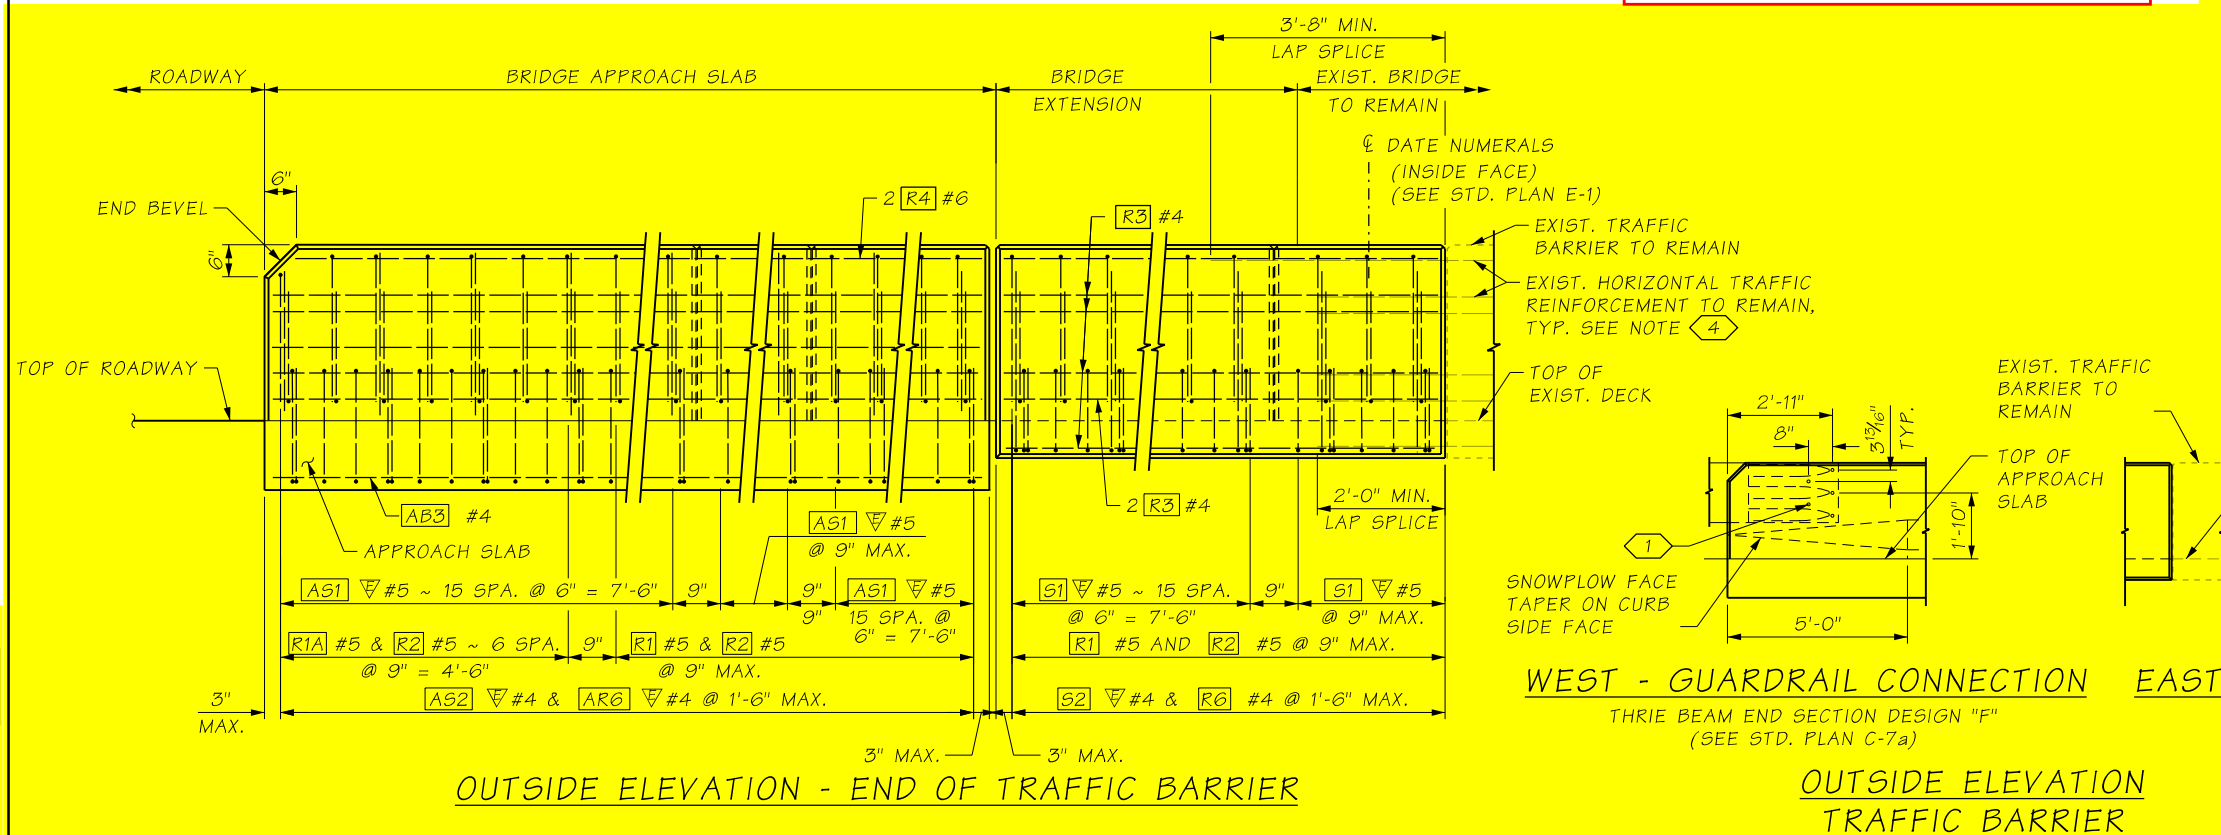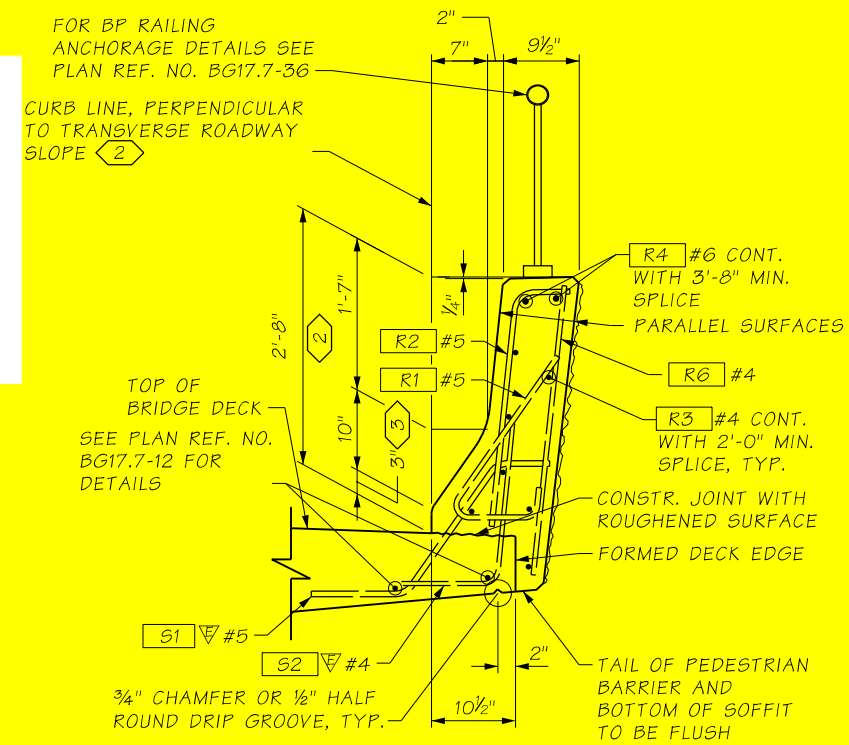

### TYPICAL SECTION TRAFFIC BARRIER

SHOWN ON BRIDGE

#### NOTES:

- 1 PROVIDE 5 - 7/8"Ø ROCKET/KOHLER F-50, LANCASTER MALLEABLE, OR DAYTON/RICHMOND F-62 FLARED THIN SLAB FERRULE INSERTS OR APPROVED EQUAL, TYP. RESIN-BONDED ANCHORS MAY BE SUBSTITUTED.
- 2 MIN. HEIGHT. TRAFFIC BARRIER HEIGHT MAY VARY IF REQUIRED TO PROVIDE A SMOOTH PROFILE.
- 3 TOE HEIGHT MAY VARY, 2" MIN. TO 6" MAX. MATCH EXISTING BARRIER AT TIE-IN.
- 4 REMAINING REINFORCING SHALL BE CLEANED BEFORE NEW CONCRETE IS PLACED.

I-405  
FILE NO. 9242 SHEET

c:\users\jagn\documents\projectwise\workingdir\wsdot\dms22941\XL5467_29_DE_BG_BG17.7-Barrier2.dgn			
Design Mgr: BRIAN BELL	RELEASE FOR CONSTRUCTION RECORD		
Designed By: F.C. CAJAS		REGION NO. 10	STATE WASH.
Checked By: M. BAUGHMAN		JOB NUMBER XL5467	
Detailed By: M. AASAL		CONTRACT NO. C9242	
Current Revision By:			
Date: 12/2/2021			
Time: 10:18:45 PM	DESCRIPTION	DATE	NO




DATE	DATE
E.O.R. 1 STAMP BOX	E.O.R. 2 STAMP BOX

Washington State Department of Transportation


FLATIRON LANE

wood. COWI

I-405; RENTON TO BELLEVUE WIDENING AND EXPRESS TOLL LANES PROJECT		PLAN REF. NO. BG17.7-29
BRIDGE 405/17.7 - RENTON AVE OVER I-405		SHEET OF SHEETS
BARRIER DETAILS 2 OF 4		

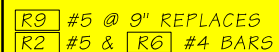

SEE TYPICAL SECTION - TRAFFIC  
BARRIER FOR ADDITIONAL DETAILS

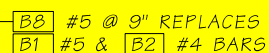

SEE TYPICAL SECTION - PEDESTRIAN  
BARRIER FOR ADDITIONAL DETAILS



SIDEWALK REINFORCING STEEL  
NOT SHOWN FOR CLARITY  
NORTH PEDESTRIAN BARRIER ONLY




- 1 THE CONTRACTOR IS ADVISED THAT THE SLIPFORM CONSTRUCTION METHOD IS A PATENTED PROPRIETARY PROCESS FOR BARRIERS WITH A FRACTURED FIN FINISH.
- 2 JUNCTION BOX LOCATION SHOWN IS APPROXIMATE. CENTER JUNCTION BOX INSTALLATION BETWEEN BARRIER DUMMY JOINTS.
- 3 INSTALL ALL CONDUIT RUNS TO DRAIN TO A BRIDGE END OR PROVIDE DRAIN AT ALL LOW POINTS IN CONDUIT RUN ON BRIDGE.

STATION	OFFSET	"ITS" OR "LT"
15+06.5	-20.5	LT

LT = LIGHTING SYSTEM



VIEW A  
28

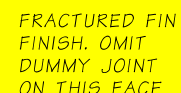

SECTION B  
-  
BRIDGE DECK



VIEW C  
29



SECTION D  
BRIDGE DECK -



SECTION D  
APPROACH SLAB -



GUARDRAIL "D" CONNECTION  
(SEE STD. PLAN C-24.10)

No.	Date
-----	------

CHECK PRINT

Dwg. Only: Checked against calcs. and specs.


Confirmed by \_\_\_\_\_ Date \_\_\_\_\_

Originator PTWL Date 12/21/2021

Checker	<u>MWBM</u>	Date	<u>12/21/2021</u>
---------	-------------	------	-------------------


Backchecker \_\_\_\_\_ Date \_\_\_\_\_

Updater \_\_\_\_\_ Date \_\_\_\_\_

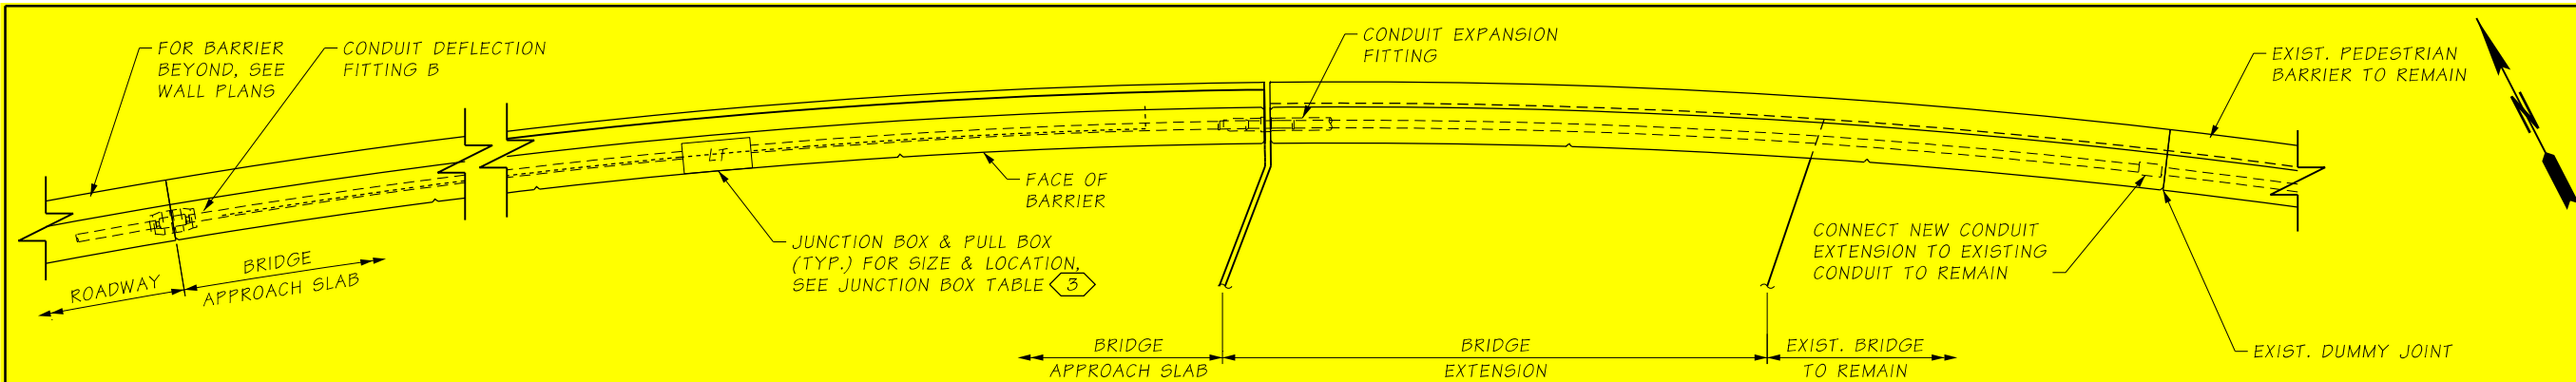


PLAN  
CONDUITS & J-BOX IN PEDESTRIAN BARRIER


No. _____	Date _____
<b>CHECK PRINT</b>	
Dwg. Only: Checked against calcs. and specs.	
Confirmed by _____	Date _____
Originator <u>PTWL</u>	Date <u>12/21/2021</u>
Checker <u>MWBM</u>	Date <u>12/21/2021</u>
Backchecker _____	Date _____
Updater _____	Date _____
Rechecker _____	Date _____

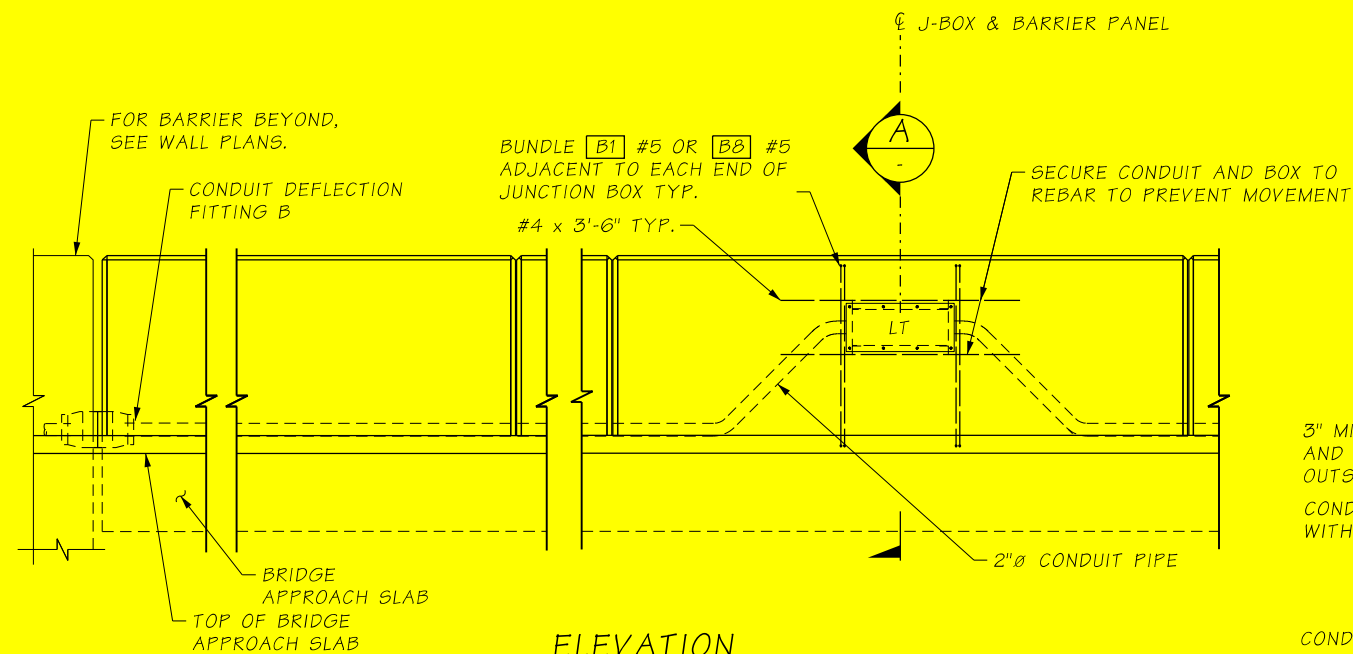


ELEVATION  
CONDUITS & J-BOX IN PEDESTRIAN BARRIER

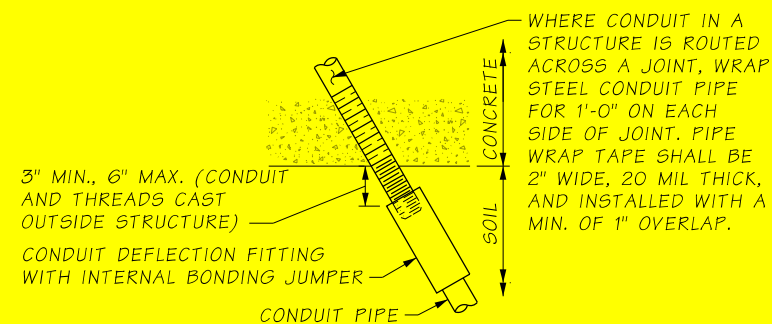

CONDUIT DEFLECTION FITTING A  
CONDUIT FITTING - TYPE DX FOR DEFLECTION OF 30° & 3/4" MOVEMENT. PLACE AT CONDUIT PIPE EXIT FROM STRUCTURE AND SHALL BE IN NEUTRAL STATE AFTER INSTALLATION

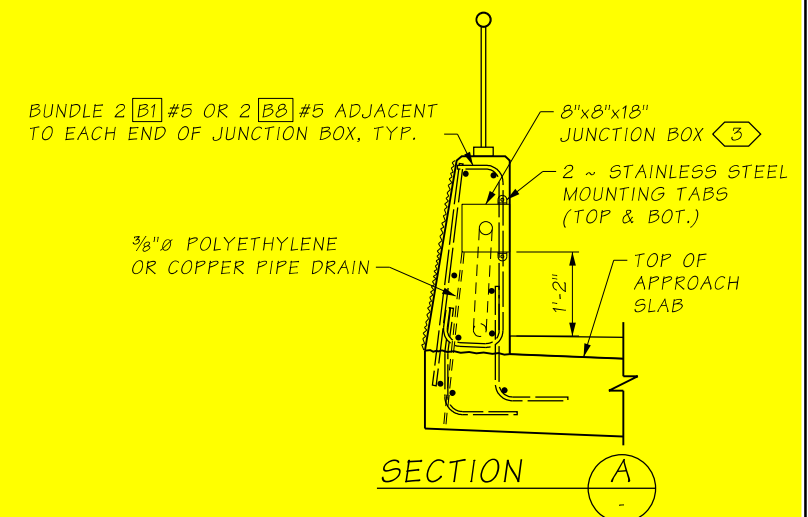


SECTION A

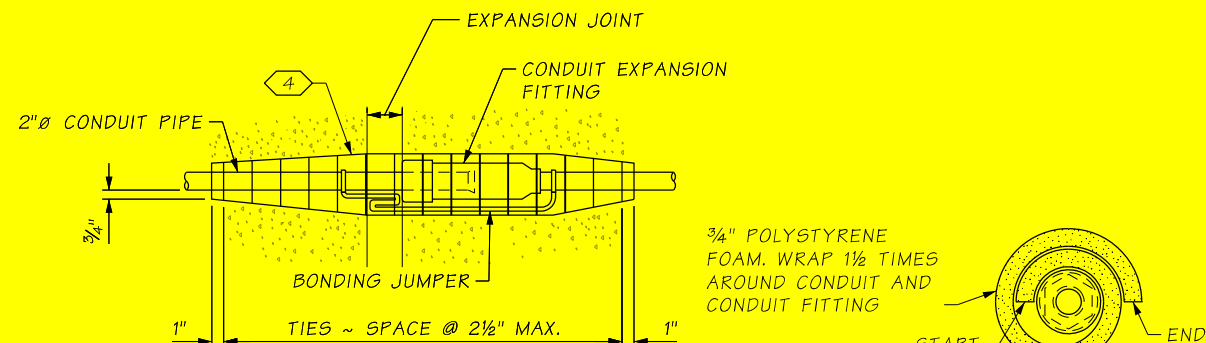

CONDUIT EXPANSION FITTING  
CONDUIT FITTING - (TYPE AX FOR MOVEMENT OF ± 2") AT BRIDGE EXPANSION JOINTS

SECTION B

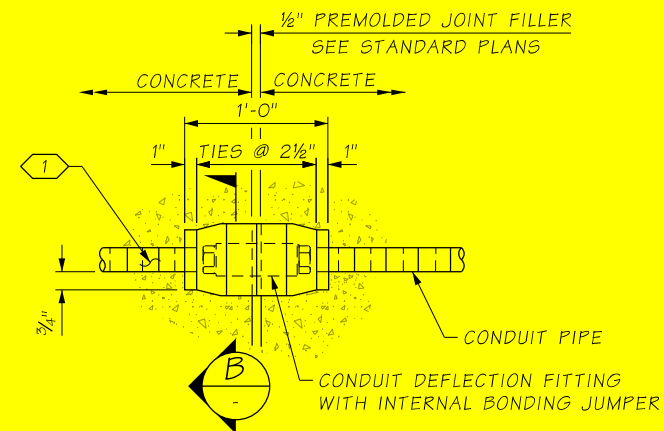

CONDUIT DEFLECTION FITTING B  
CONDUIT FITTING - TYPE DX FOR DEFLECTION OF 30° AND A 3/4" MOVEMENT.

NOTES:

- WHERE CONDUIT IN A STRUCTURE IS ROUTED ACROSS A JOINT, WRAP STEEL CONDUIT PIPE FOR 1'-0" ON EACH SIDE OF JOINT. PIPE WRAP TAPE SHALL BE 2" WIDE 20 MIL THICK, AND INSTALLED WITH A MINIMUM OF 1" OVERLAP.
- LABEL JUNCTION BOX COVER IN ACCORDANCE WITH STANDARD SPECIFICATION SECTION 9-29.2(4).
- NEMA 4X IN STATIONARY FORM BARRIER, OR NEMA 3R IN SLIP FORM BARRIER. MOUNT JUNCTION BOX SO COVER IS FLUSH WITH BARRIER, CAN BE RECESSED UP TO 1/8".
- 3'-0" LONG EXPANDED POLYSTYRENE SLEEVE AROUND CONDUIT. DUCT TAPE SEAMS AND ENDS TO SEAL AND PREVENT CONCRETE FORM BONDING WITH FITTING AND CONDUIT.

I-405  
FILE NO. 9242 SHEET

c:\users\mkal\documents\projectwise\workingdir\wsdot\dms22941\XL5467_31_DE_BG_BG17.7-Barrier4.dgn			
Design Mgr:	BRIAN BELL	RELEASE FOR CONSTRUCTION RECORD	
Designed By:	F.C. CAJAS	REGION NO.	STATE
Checked By:	M. BAUGHMAN	10	WASH.
Detailed By:	M. AASAL	JOB NUMBER	
Current Revision By:		XL5467	
Date:	12/15/2021	CONTRACT NO.	
Time:	9:50:47 AM	C9242	
	DESCRIPTION	DATE	NO



DATE

E.O.R. 1 STAMP BOX

DATE

E.O.R. 2 STAMP BOX



Washington State  
Department of Transportation



FLATIRON LANE  
wood. COWI

I-405; RENTON TO BELLEVUE WIDENING  
AND EXPRESS TOLL LANES PROJECT

BRIDGE 405/17.7 - RENTON AVE OVER I-405


BARRIER DETAILS 4 OF 4

PLAN REF. NO.  
BG17.7-31  
SHEET  
OF  
SHEETS

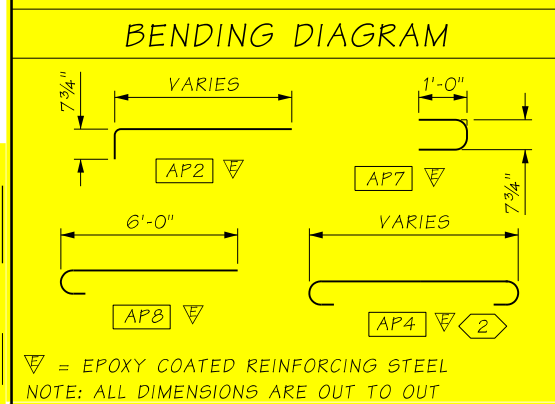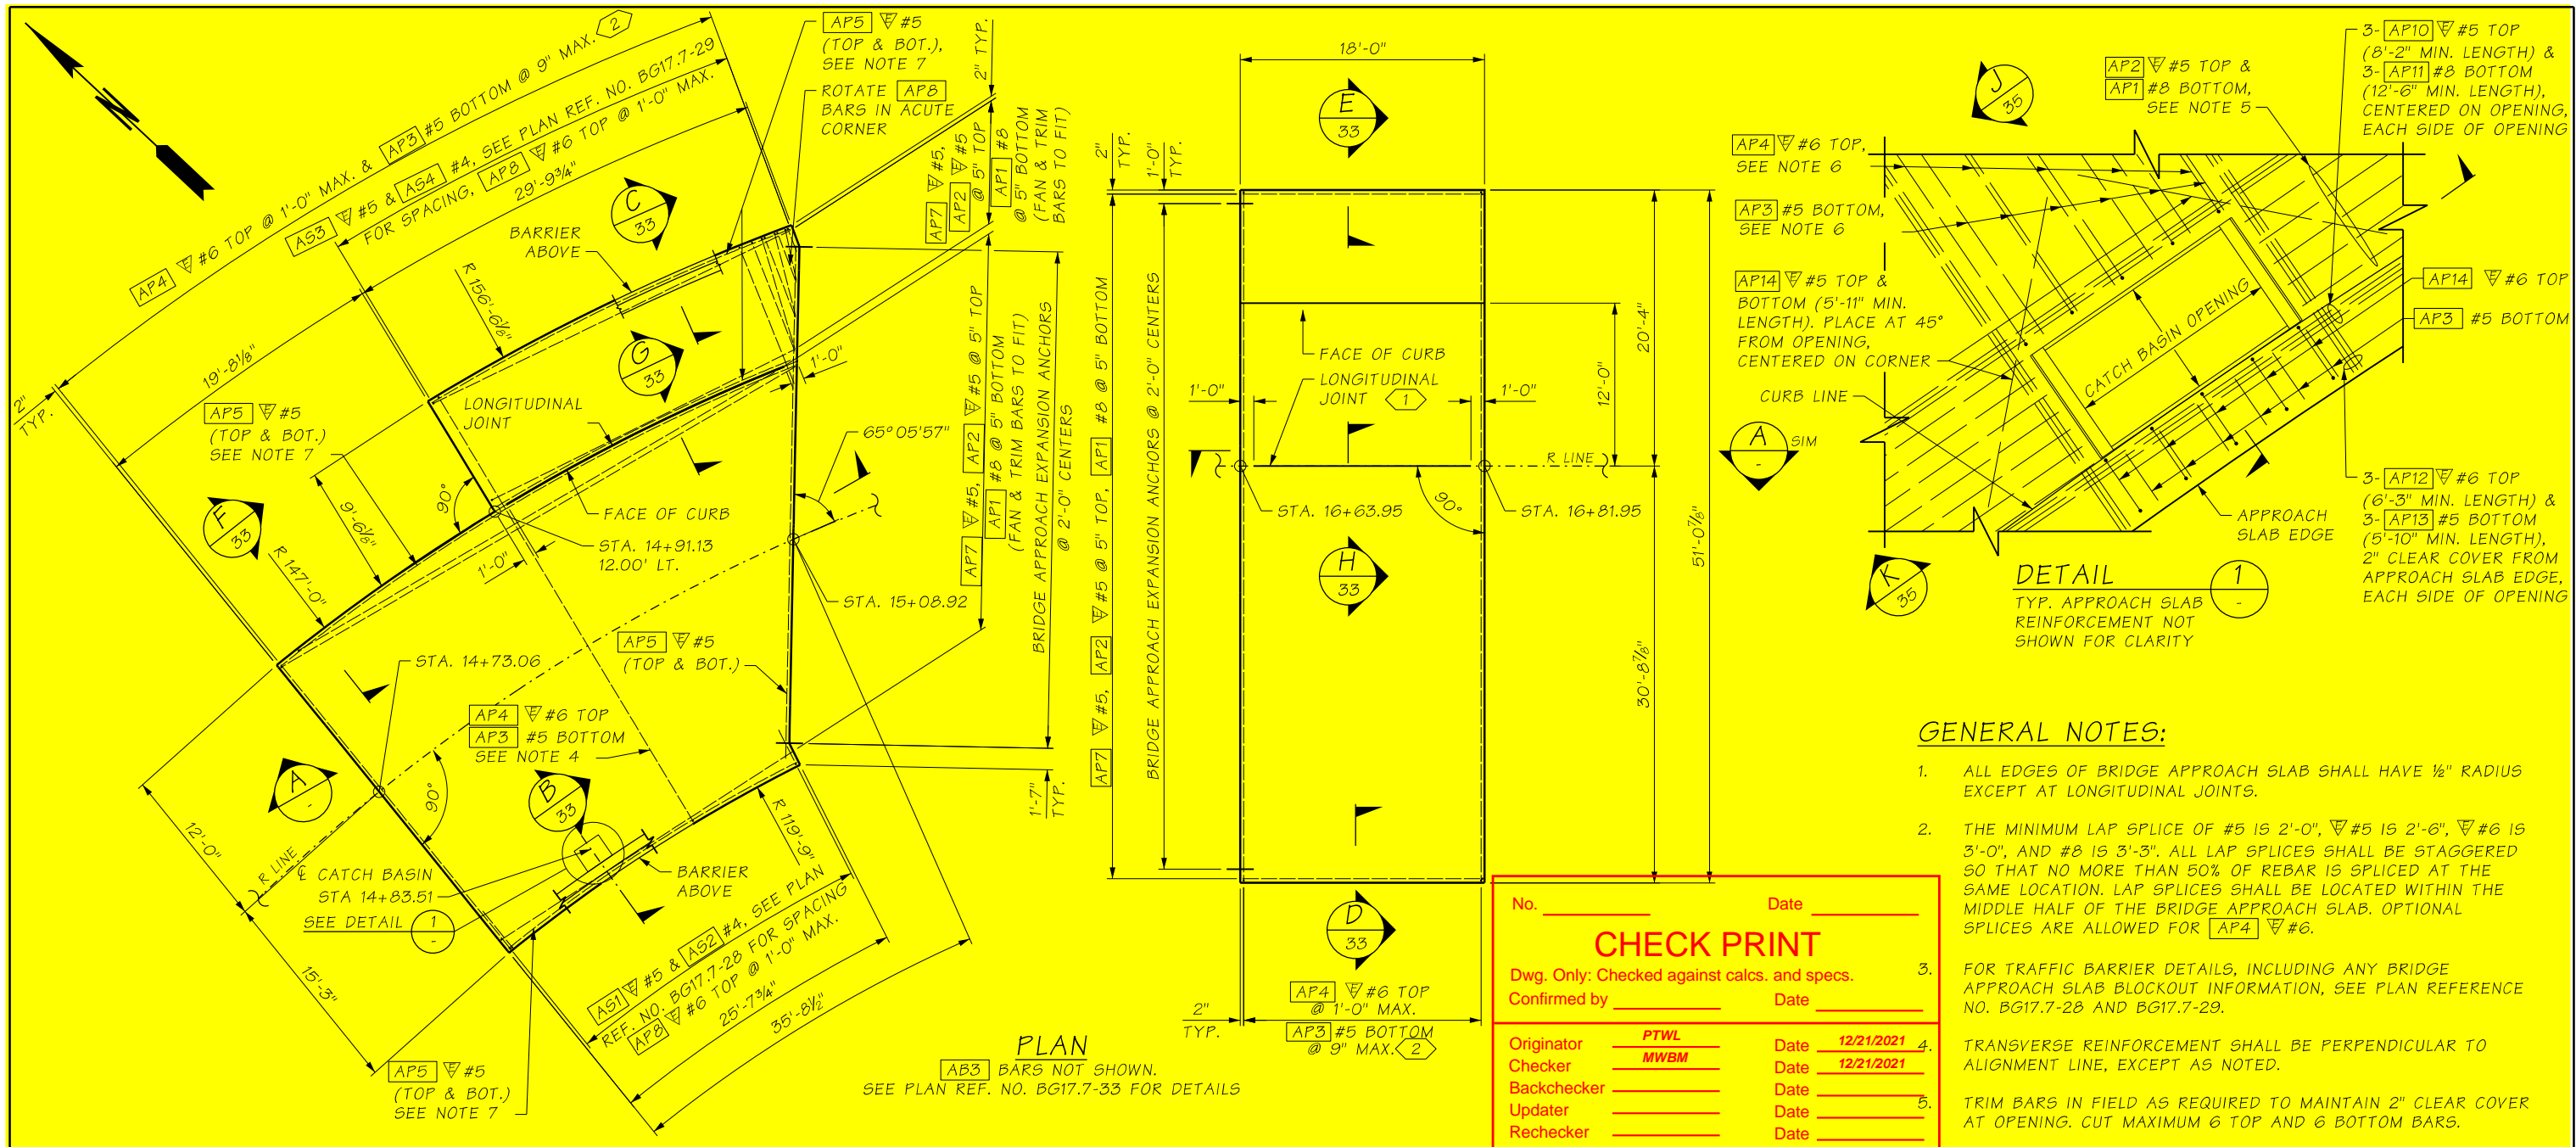





I-405  
FILE NO. 9242 SHEET

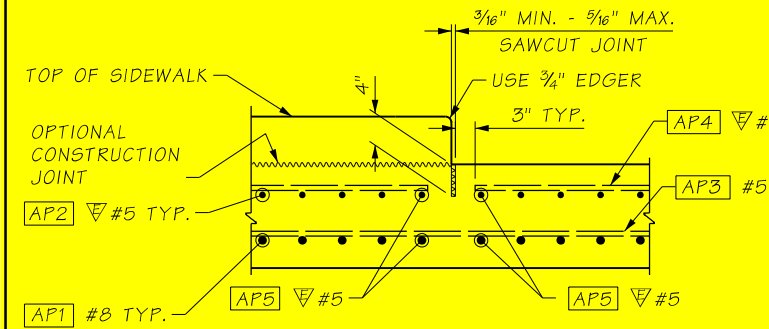


LONGITUDINAL JOINT DETAIL (G)  
WEST APPROACH SLAB 32

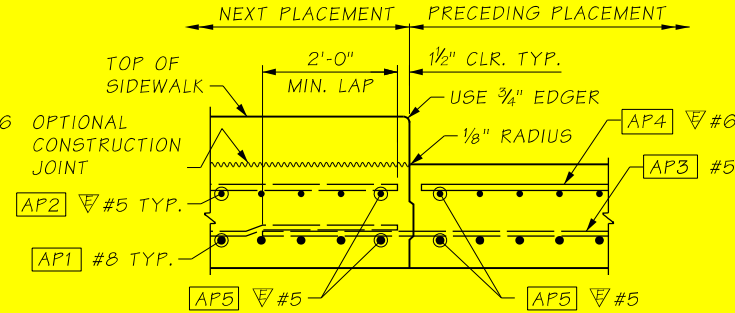


ALTERNATE LONGITUDINAL JOINT DETAIL (G)  
EDGE PRECEDING PLACEMENT ONLY WITH 1/8\"/>

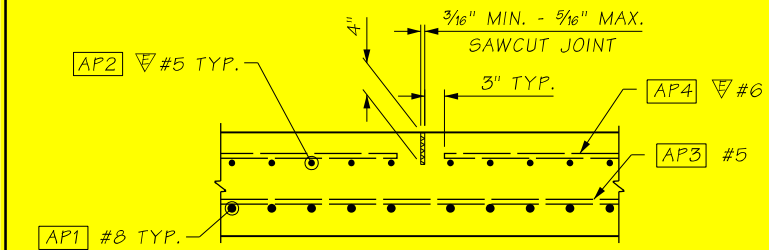


LONGITUDINAL JOINT DETAIL (H)  
EAST APPROACH SLAB 32

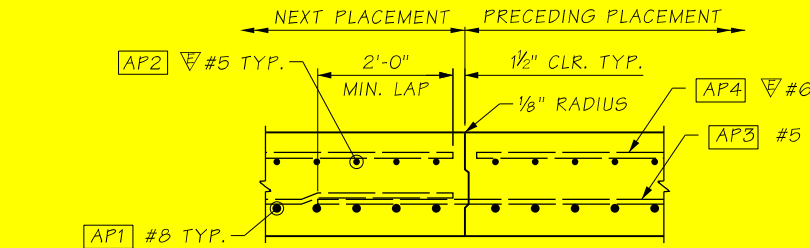


ALTERNATE LONGITUDINAL JOINT DETAIL (H)  
EDGE PRECEDING PLACEMENT ONLY WITH 1/8\"/>

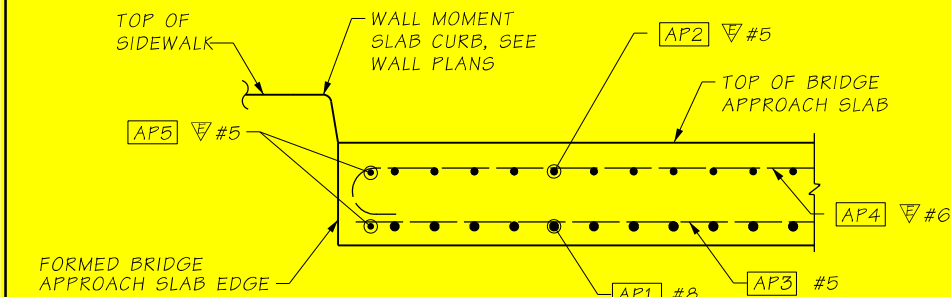


SECTION (F)  
32

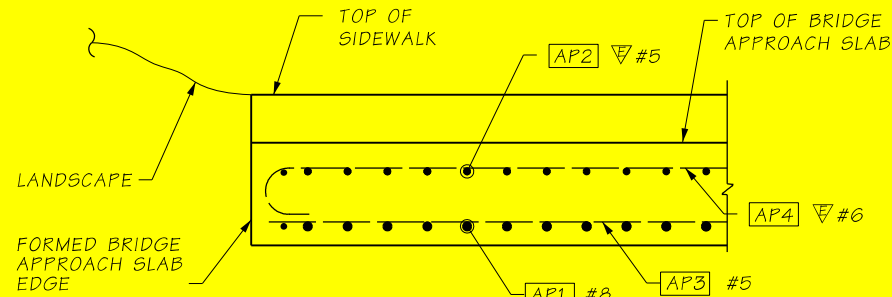

SECTION (E)  
32

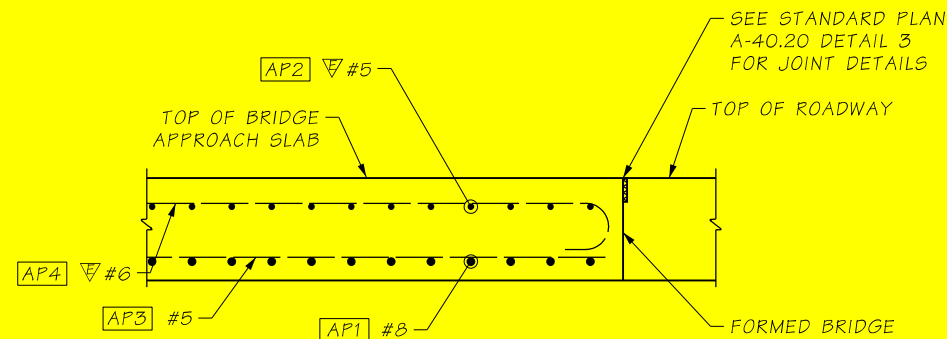


SECTION (D)  
32

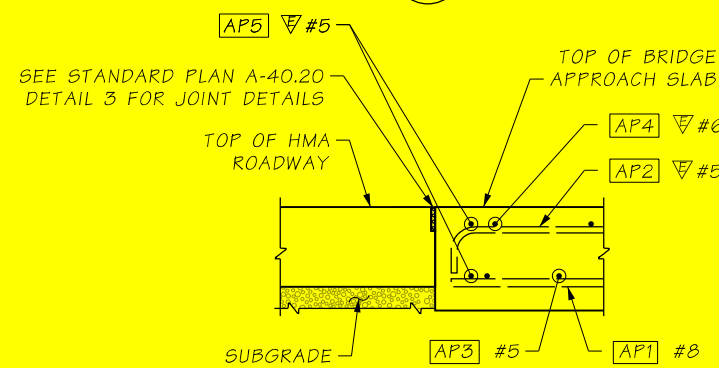


HMA ROADWAY JOINT DETAIL

No. _____	Date _____
<b>CHECK PRINT</b>	
Dwg. Only: Checked against calcs. and specs.	
Confirmed by _____	Date _____
Originator <u>PTWL</u>	Date <u>12/21/2021</u>
Checker <u>MWBM</u>	Date <u>12/21/2021</u>
Backchecker _____	Date _____
Updater _____	Date _____
Rechecker _____	Date _____

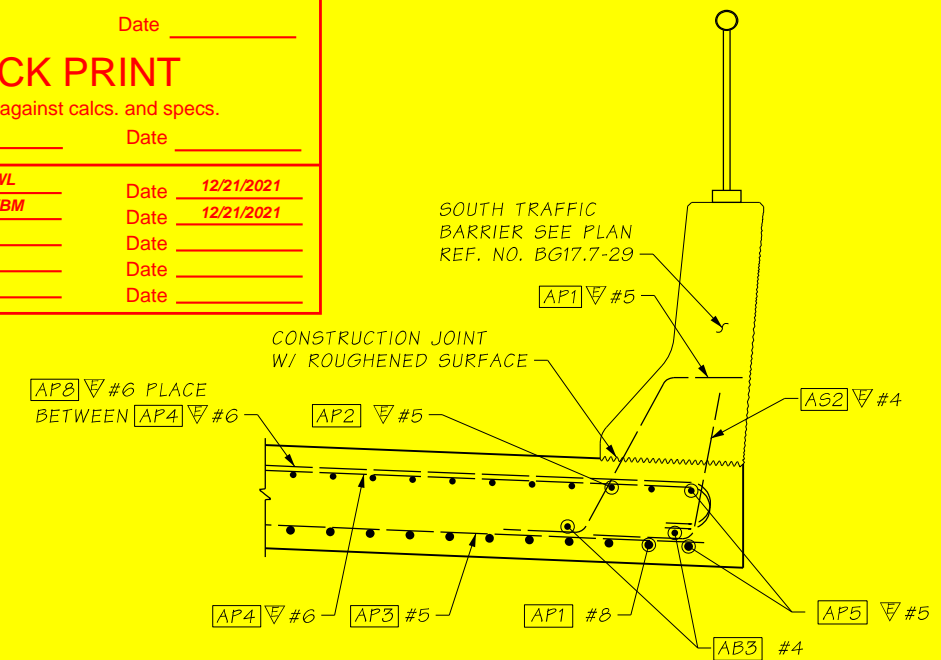

SECTION (B)  
32

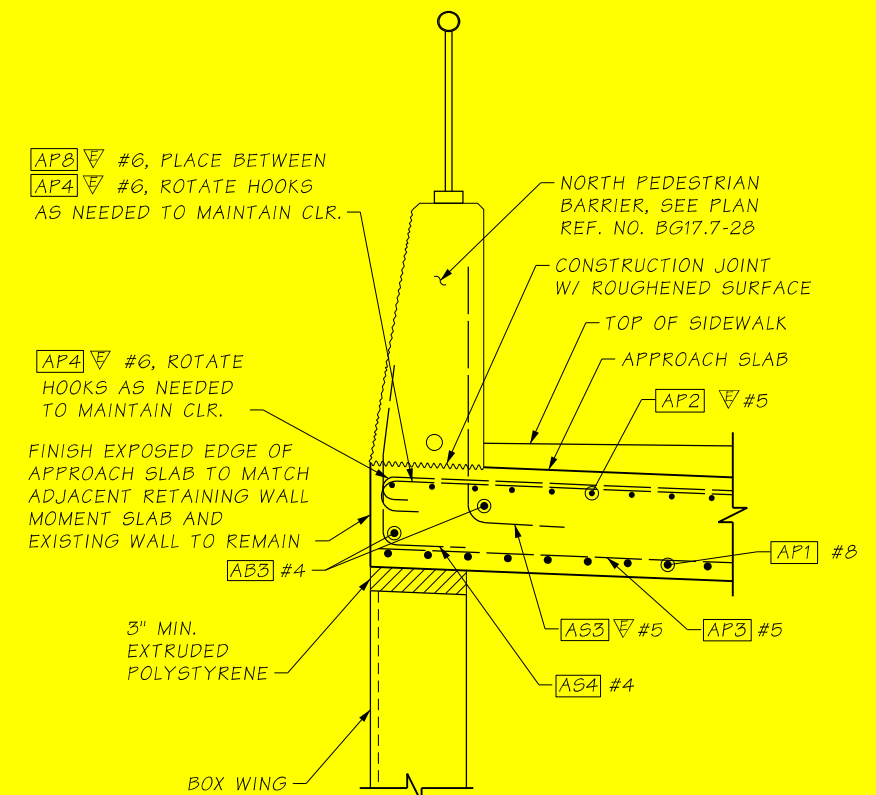


SECTION (C)  
32


c:\users\jagn\documents\projectwise\workingdir\wsdot\dms22941\XL5467_33_DE_BG_BR17.7-ApprSlab2.dgn				RELEASE FOR CONSTRUCTION RECORD			
Design Mgr:	B. BELL	REGION NO.	STATE	FED. AID, PROJ. NO.	SHEET NO.	TOTAL SHEETS	
Designed By:	F.C. CAJAS	10	WASH.				
Checked By:	M. BAUGHMAN						
Detailed By:	M. AASAL						
Current Revision By:							
Date:	12/2/2021						
Time:	10:58:14 PM						
DESCRIPTION		DATE	NO	CONTRACT NO. C9242			




DATE _____	DATE _____
E.O.R. 1 STAMP BOX	E.O.R. 2 STAMP BOX

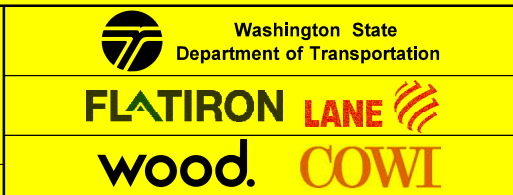

I-405; RENTON TO BELLEVUE WIDENING AND EXPRESS TOLL LANES PROJECT		PLAN REF. NO. BG17.7-33
BRIDGE 405/17.7 - RENTON AVE OVER I-405		SHEET OF SHEETS
APPROACH SLABS 2 OF 4		

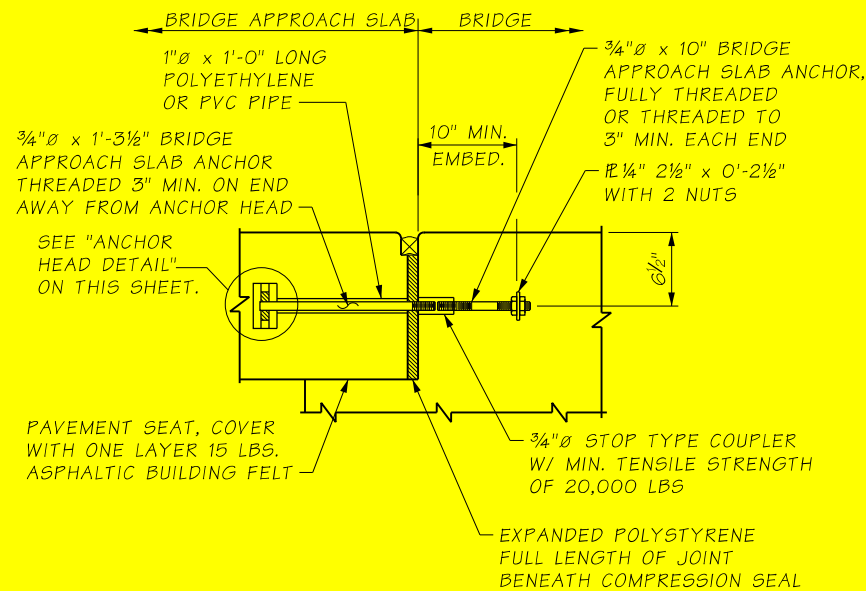


**APPROACH EXPANSION ANCHOR - METHOD A**  
DOES NOT APPLY TO EAST APPROACH SLAB

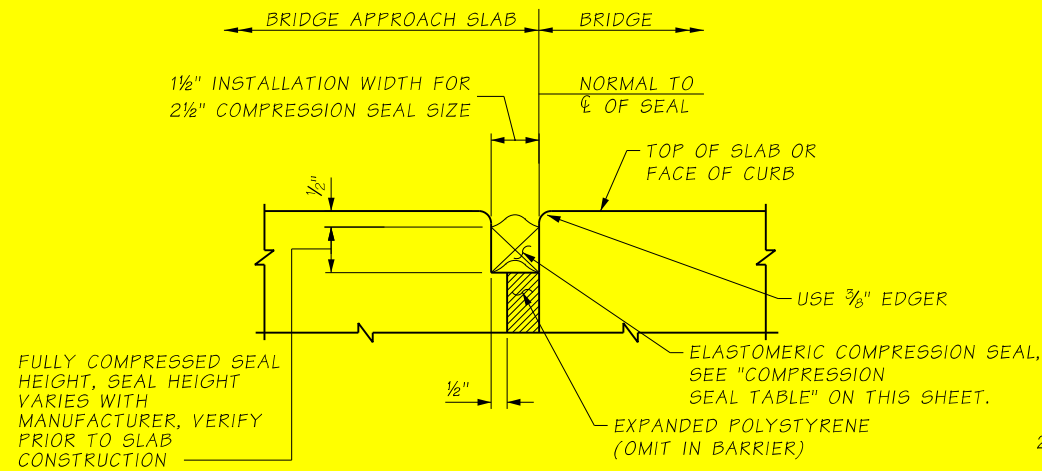


**COMPRESSION SEAL DETAIL**  
EXPANSION JOINT AT BACK OF PAVEMENT SEAT


No. _____	Date _____
<b>CHECK PRINT</b>	
Dwg. Only: Checked against calcs. and specs.	
Confirmed by _____	Date _____
Originator <b>PTWL</b>	Date <b>12/21/2021</b>
Checker <b>MWBM</b>	Date <b>12/21/2021</b>
Backchecker _____	Date _____
Updater _____	Date _____
Rechecker _____	Date _____

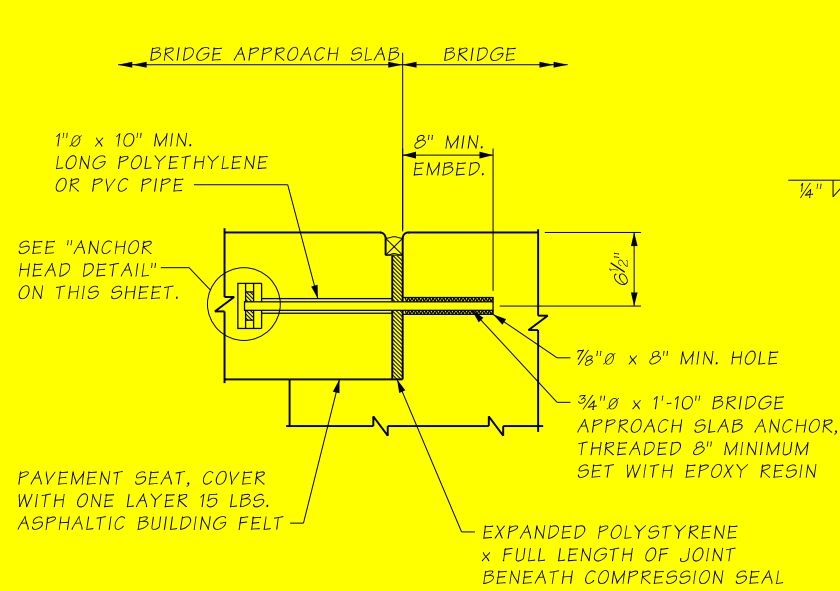


**APPROACH EXPANSION ANCHOR - METHOD B**

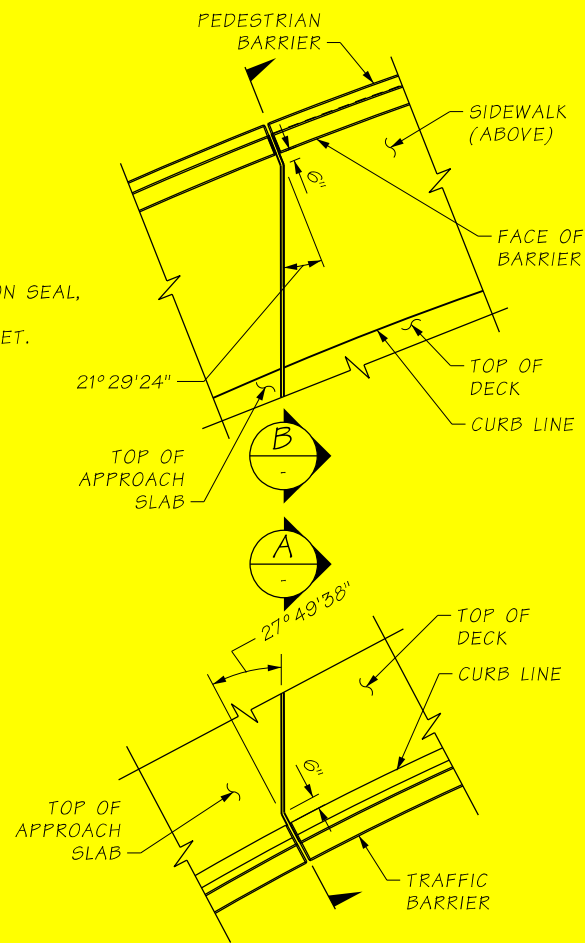


**PLAN**  
EXPANSION JOINT

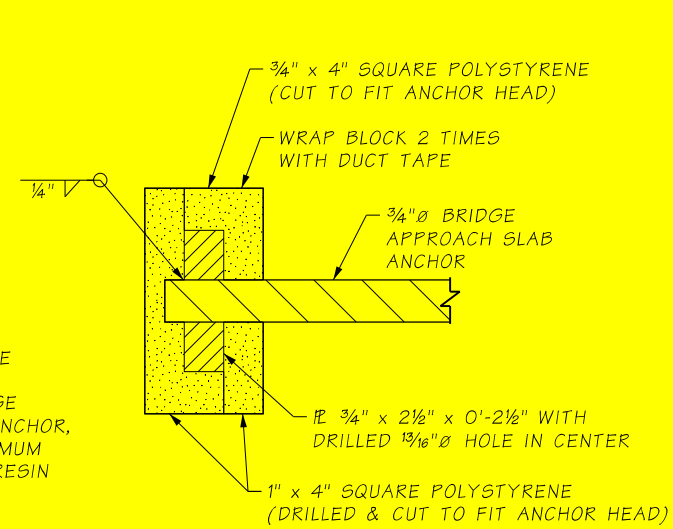

**ANCHOR HEAD DETAIL**

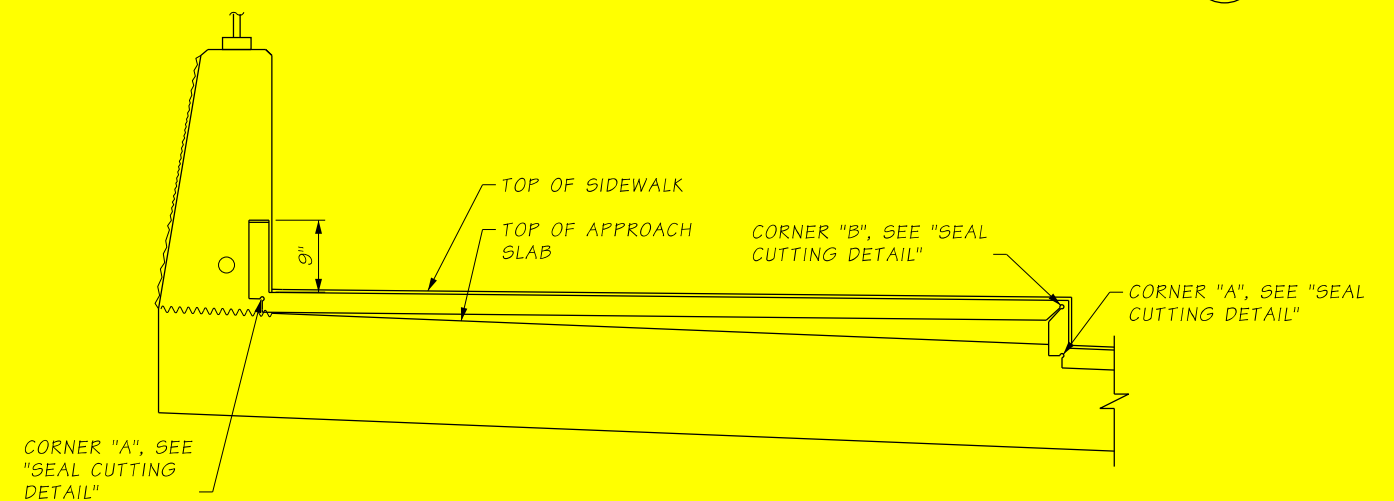

**SECTION A**

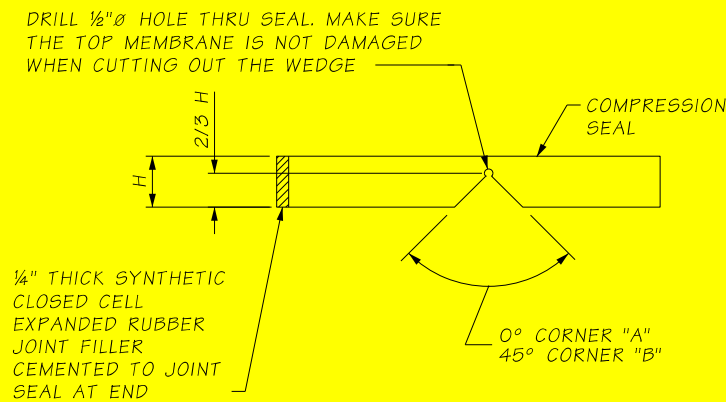

**SEAL CUTTING DETAIL**

**COMPRESSION SEAL TABLE**

D.S. BROWN		WATSON BOWMAN ACME	
SEAL	WIDTH	SEAL	WIDTH
CV-2502	2 1/2"	WA-250	2 1/2"

TESTING SHALL BE PER ASTM D 2628 PRIOR TO USE.


**NOTES:**

- ALL METAL PARTS OF THE APPROACH EXPANSION ANCHOR SHALL RECEIVE ONE COAT OF PAINT CONFORMING TO STANDARD SPECIFICATION SECTION 9-08.1(2)F OR BE GALVANIZED IN ACCORDANCE WITH AASHTO M 232.
- BRIDGE APPROACH SLAB ANCHORS SHALL BE INSTALLED PARALLEL TO ROADWAY AND TO EACH OTHER.

c:\users\jagn\documents\projectwise\workingdir\wsdot\dms22941\XL5467_34_DE_BG_BR17.7-ApprSlab3.dgn		RELEASE FOR CONSTRUCTION RECORD		REGION NO.	STATE	FED. AID, PROJ. NO.	SHEET NO.	TOTAL SHEETS
Design Mgr:	B. BELL			10	WASH.			
Designed By:	F.C. CAJAS							
Checked By:	M. BAUGHMAN							
Detailed By:	M. AASAL							
Current Revision By:								
Date:	12/2/2021							
Time:	11:13:56 PM	DESCRIPTION	DATE	NO				



E.O.R. 2 STAMP BOX

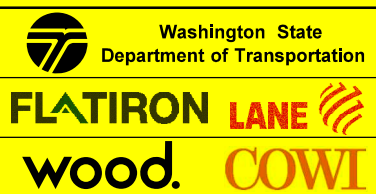


**I-405; RENTON TO BELLEVUE WIDENING AND EXPRESS TOLL LANES PROJECT**


**BRIDGE 405/17.7 - RENTON AVE OVER I-405**

APPROACH SLABS 3 OF 4

PLAN REF. NO.  
**BG17.7-34**  
SHEET  
OF  
SHEETS

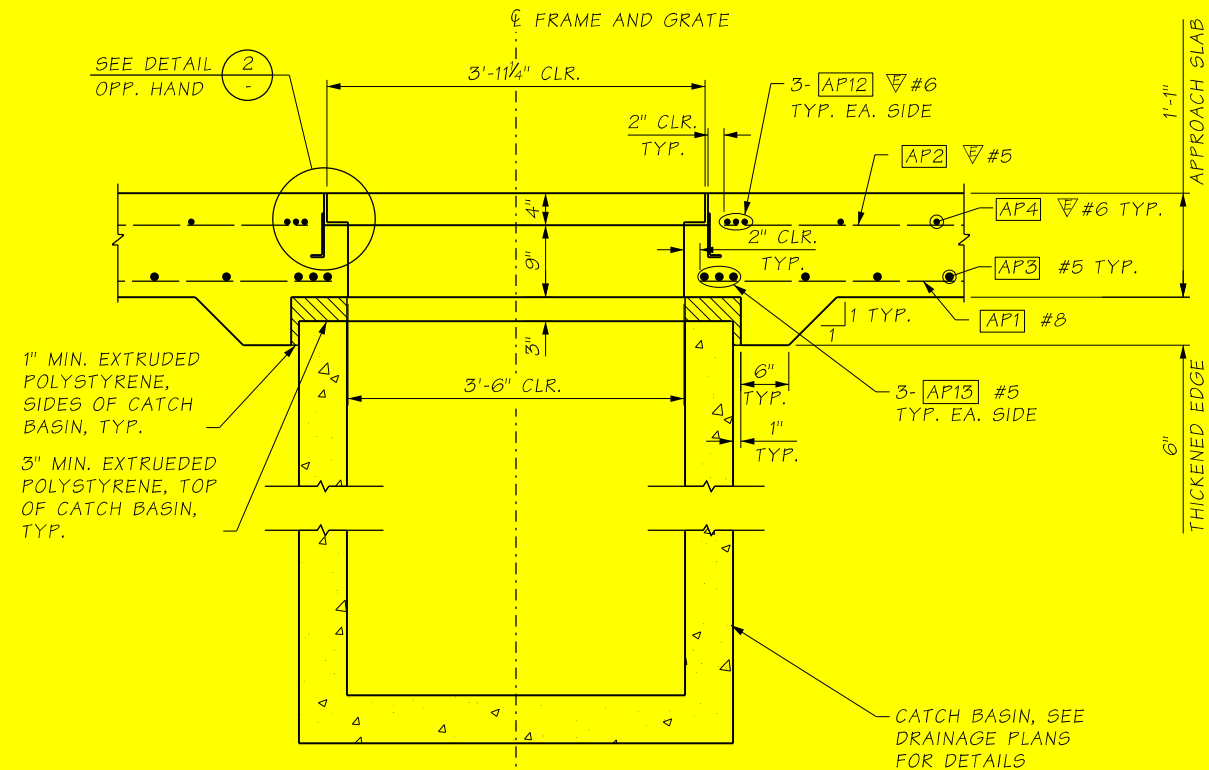

SECTION K  
32

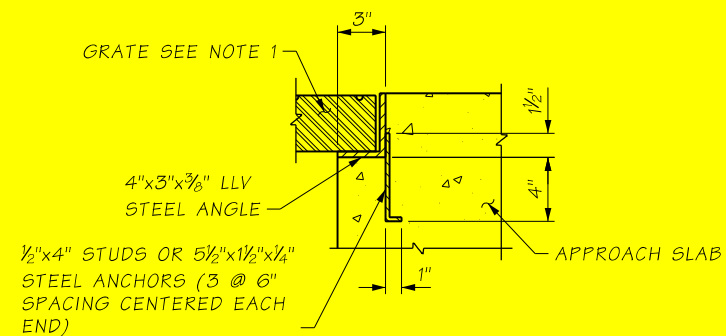


DETAIL 2

No. _____	Date _____
<h1 style="margin: 0;">CHECK PRINT</h1>	
Dwg. Only: Checked against calcs. and specs.	
Confirmed by _____	Date _____


Originator _____ <i>PTWL</i>	Date _____ <i>12/21/2021</i>
Checker _____ <i>MWBM</i>	Date _____ <i>12/21/2021</i>
Backchecker _____	Date _____
Updater _____	Date _____
Rechecker _____	Date _____

1. FOR GRATE DETAILS, SEE WSDOT  
STD. PLAN B-40.20-00


<p><b>I-405; RENTON TO BELLEVUE WIDENING AND EXPRESS TOLL LANES PROJECT</b></p> <p><b>BRIDGE 405/17.7 - RENTON AVE OVER I-405</b></p> <p><i>APPROACH SLABS 4 OF 4</i></p>	<p>PLAN REF. NO. <b>BG17.7-35</b></p>
	<p>SHEET</p> <p>OF</p> <p>SHEETS</p>

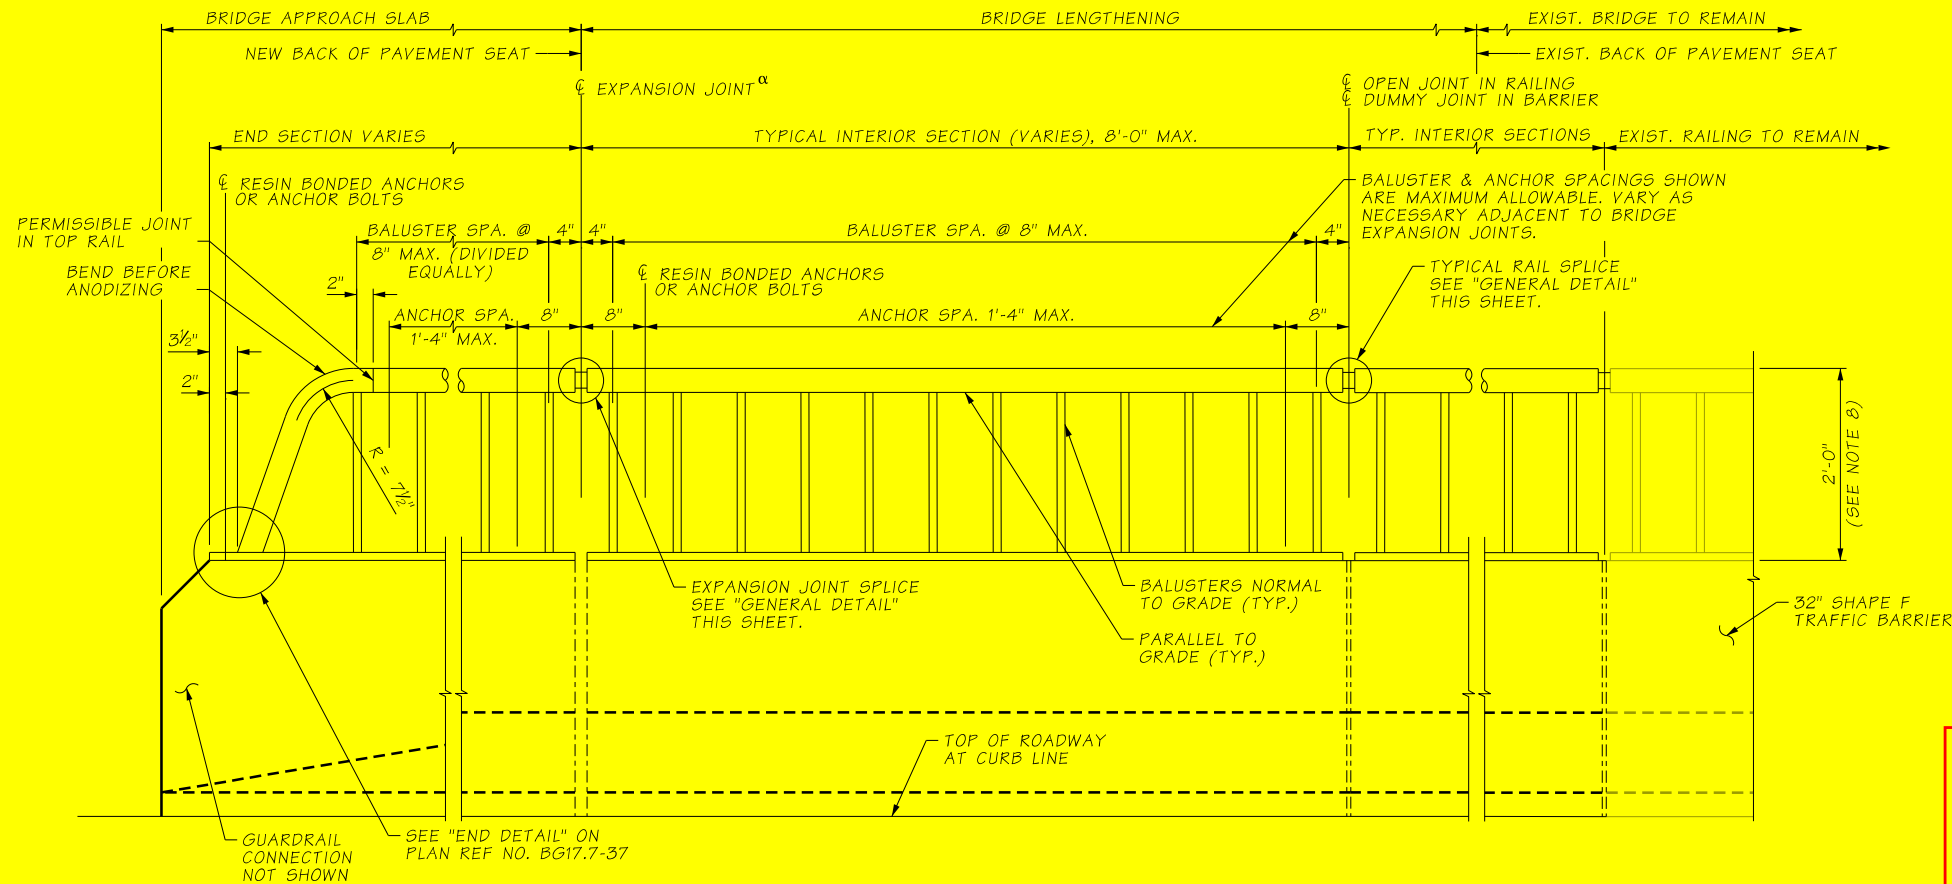


**OUTSIDE ELEVATION - SOUTH TRAFFIC BARRIER**  
BALUSTER AND GUARDRAIL ANCHORAGE DETAILS NOT SHOWN

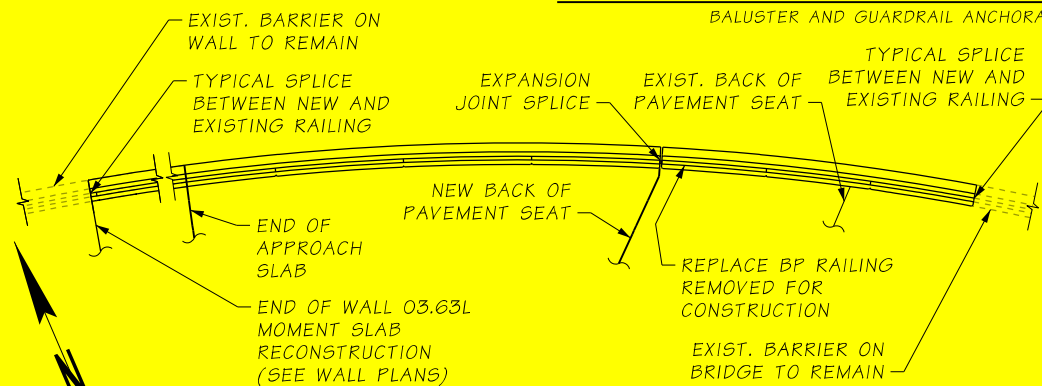

**PLAN - NORTH PEDESTRIAN BARRIER**

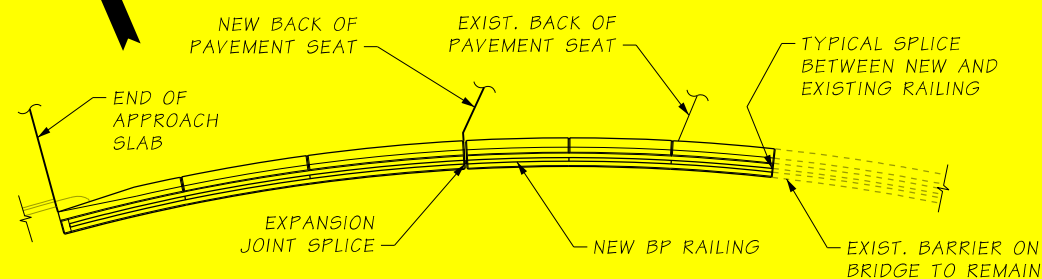

**PLAN - SOUTH TRAFFIC BARRIER**

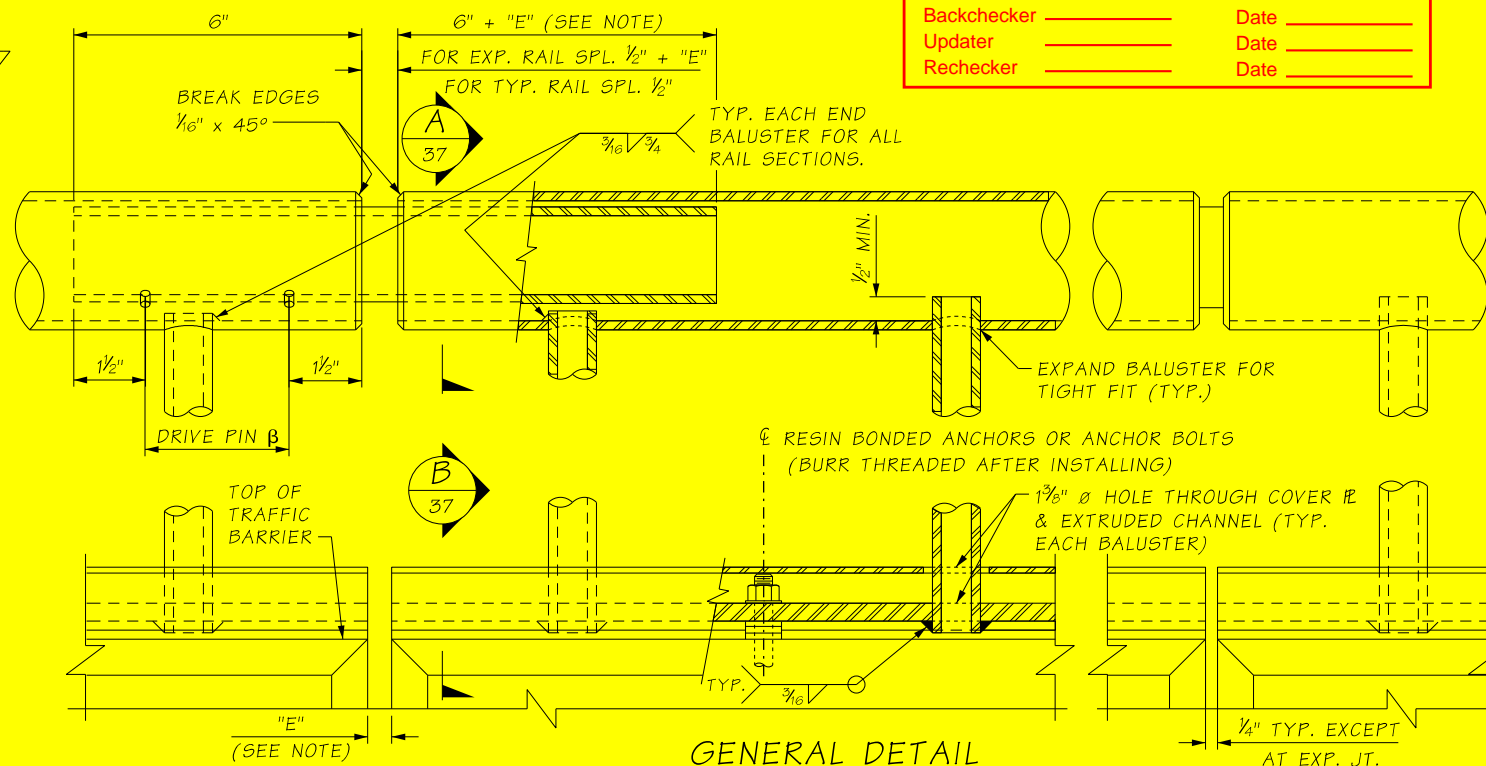

**GENERAL DETAIL**

**NOTES:**

- PIPE RAILING, PIPE RAILING SPLICES, COVER PLATES AND BOTTOM EXTRUDED CHANNELS SHALL BE BENT TO THE HORIZONTAL CURVE WHERE THE RADIUS OF CURVATURE IS LESS THAN 200'. THESE ITEMS MAY BE HEATED TO NOT MORE THAN 400°F FOR A PERIOD NOT TO EXCEED 30 MINUTES TO FACILITATE FORMING OR BENDING TO HORIZONTAL CURVATURE.
  - SHOP DRAWINGS OF RAILING SHALL BE SUBMITTED AS A TYPE 2 WORKING DRAWING SHOWING COMPLETE DIMENSIONS AND DETAILS OF FABRICATION AND INCLUDING AN ERECTION DIAGRAM. MATERIAL SPECIFICATIONS SHALL BE PROVIDED IN THE SHOP DRAWINGS FOR ALL COMPONENTS.
  - CUTTING SHALL BE DONE BY SAWING OR MILLING AND ALL CUTS SHALL BE TRUE AND SMOOTH. FLAME CUTTING WILL NOT BE PERMITTED.
  - WELDING OF ALUMINUM SHALL CONFORM TO STD. SPEC. SECTION 9-28.14(3).
  - ALL ALUMINUM PARTS SHALL BE GIVEN A CASCADE GREEN ANODIC COATING OF AT LEAST 0.0006" THICK AND SEALED TO MEET THE REQUIREMENTS OF ASTM B 580 WITH A UNIFORM FINISH.
  - PIPE RAILING, PIPE BALUSTERS AND PIPE RAILING SPLICES SHALL BE ADEQUATELY WRAPPED TO INSURE SURFACE PROTECTION DURING HANDLING AND TRANSPORTATION TO THE JOB SITE.
  - CONTRACTOR MAY SUBSTITUTE STEEL RAILING IN ACCORDANCE WITH WSDOT STANDARD DESIGN DRAWINGS 10.5-A7-1 AND 10.5-A7-2 IN LIEU OF ALUMINUM RAILING.
  - BP-24 RAIL DIMENSIONS TO MATCH EXISTING RAILING TO REMAIN. CONTRACTOR TO FIELD VERIFY.
- α** PROVIDE EXPANSION RAIL SPLICE AT TRAFFIC BARRIER EXPANSION JOINTS. RAIL SPLICE JOINTS ARE TO BE ALIGNED WITH TRAFFIC BARRIER DUMMY JOINTS, TO MATCH EXISTING.
- β** LOCATE ON OPPOSITE SIDE OF TRAFFIC. DRIVE PINS SHALL BE DRIVEN FLUSH WITH THE OUTSIDE FACE OF THE RAILING.
- NOTE:**  
"E" DIMENSION SHALL BE EQUAL TO OPENING OF TRAFFIC BARRIER EXPANSION JOINTS.

No. _____	Date _____
<b>CHECK PRINT</b>	
Dwg. Only: Checked against calcs. and specs.	
Confirmed by _____	Date _____
Originator <u>PTWL</u>	Date <u>12/21/2021</u>
Checker <u>MWBM</u>	Date <u>12/21/2021</u>
Backchecker _____	Date _____
Updater _____	Date _____
Rechecker _____	Date _____

I-405 FILE NO. 9242 SHEET

c:\users\mkal\documents\projectwise\workingdir\wsdot\dms22941\XL5467_36_DE_BG_BR17.7-Railing1.dgn			
Design Mgr:	B. BELL	RELEASE FOR CONSTRUCTION RECORD	
Designed By:	F.C. CAJAS	REGION NO.	STATE
Checked By:	M. BAUGHMAN	10	WASH.
Detailed By:	M. AASAL	JOB NUMBER	
Current Revision By:		XL5467	
Date:	12/16/2021	CONTRACT NO.	
Time:	3:16:20 PM	C9242	
	DESCRIPTION	DATE	NO



DATE

E.O.R. 1 STAMP BOX

DATE



Washington State  
Department of Transportation

**FLATIRON LANE**

**wood. COWI**


**I-405; RENTON TO BELLEVUE WIDENING  
AND EXPRESS TOLL LANES PROJECT**

**BRIDGE 405/17.7 - RENTON AVE OVER I-405**

**BRIDGE RAILING TYPE BP-24  
DETAILS 1 OF 2**



PLAN REF. NO. <b>BG17.7-36</b>
SHEET OF SHEETS



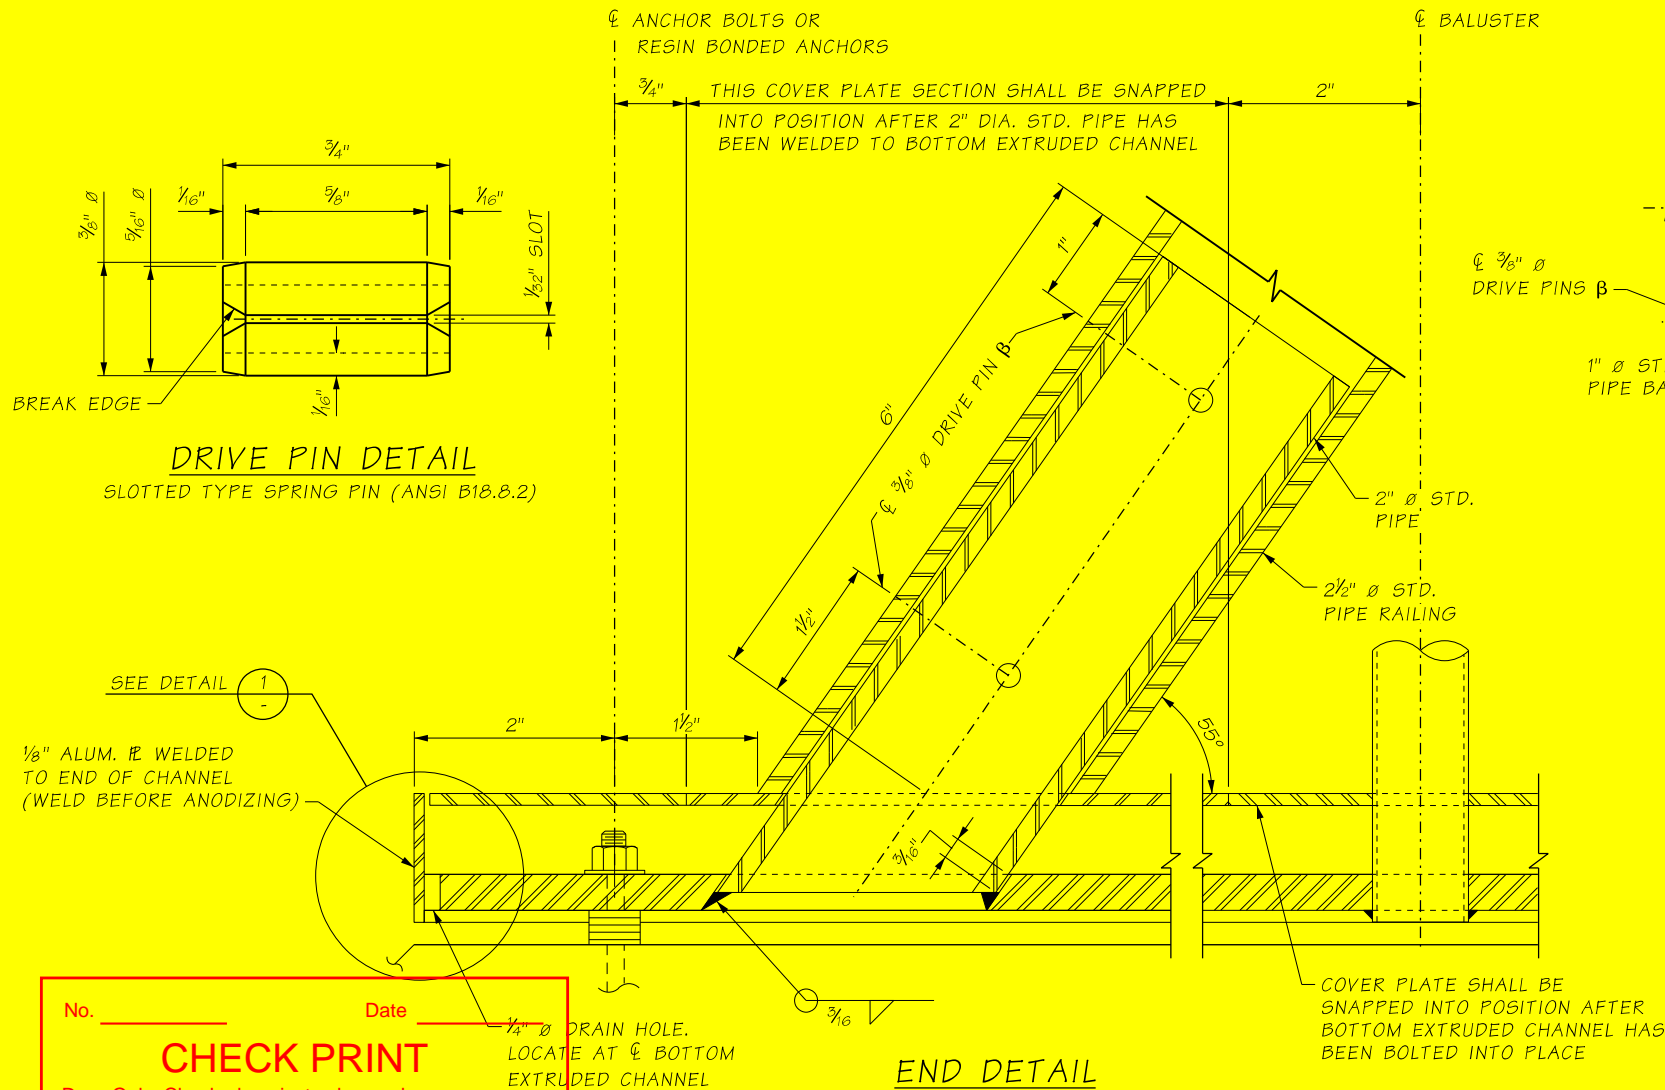

No. _____	Date _____
<b>CHECK PRINT</b>	
Dwg. Only: Checked against calcs. and specs.	
Confirmed by _____	Date _____
Originator <b>PTWL</b>	Date <b>12/21/2021</b>
Checker <b>MWBM</b>	Date <b>12/21/2021</b>
Backchecker _____	Date _____
Updater _____	Date _____
Rechecker _____	Date _____

MAT'L	PART	MATERIAL SPECIFICATION
ALUMINUM	RAILS & BALUSTERS	ASTM B221-6005-T5, 6005A-T5 OR ASTM B241-6061-T6
	EXTRUDED CHANNELS, COVER PLATES & BAR	ASTM B221-6005-T5 OR 6005A-T5
	STRIP	ASTM B221-6005-T5
STEEL	ANCHOR BOLTS, NUTS & WASHERS	STANDARD SPECIFICATION SECTION 9-06.5(4) GR. 36 (GALVANIZE IN ACCORDANCE WITH AASHTO SPECIFICATION M 232)
	DRIVE PINS	ASTM A276 OR A240 TYPE 302 STAINLESS STEEL

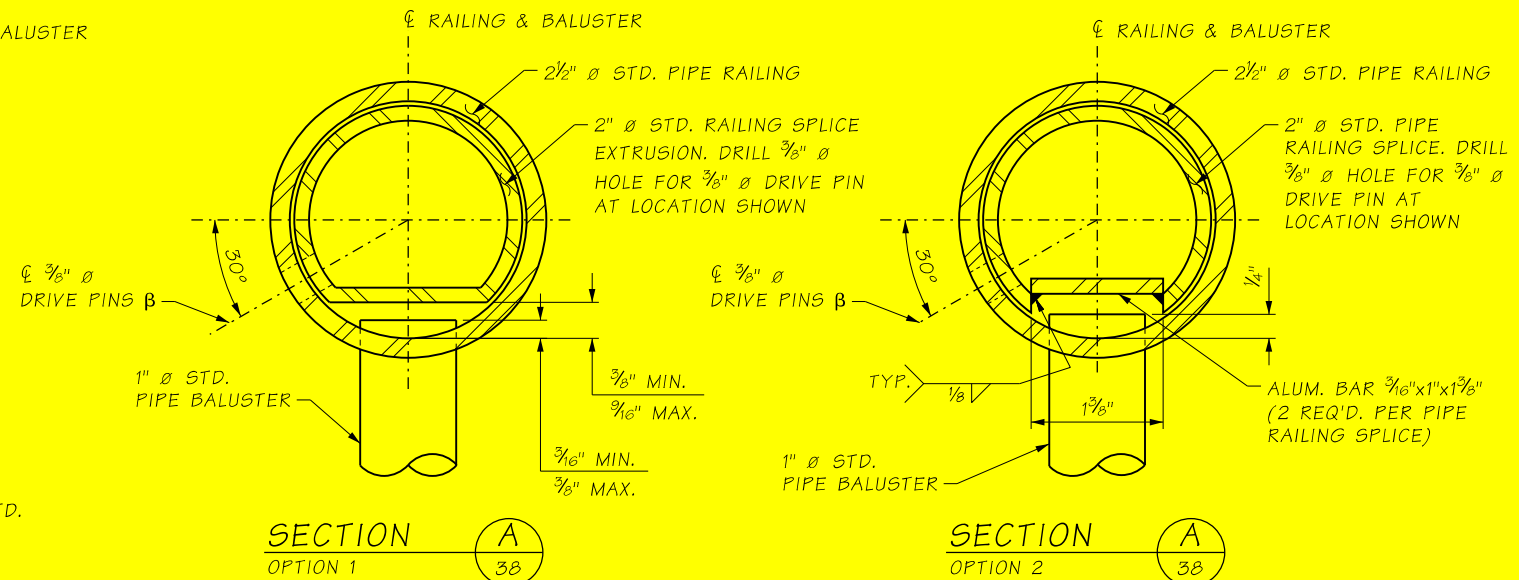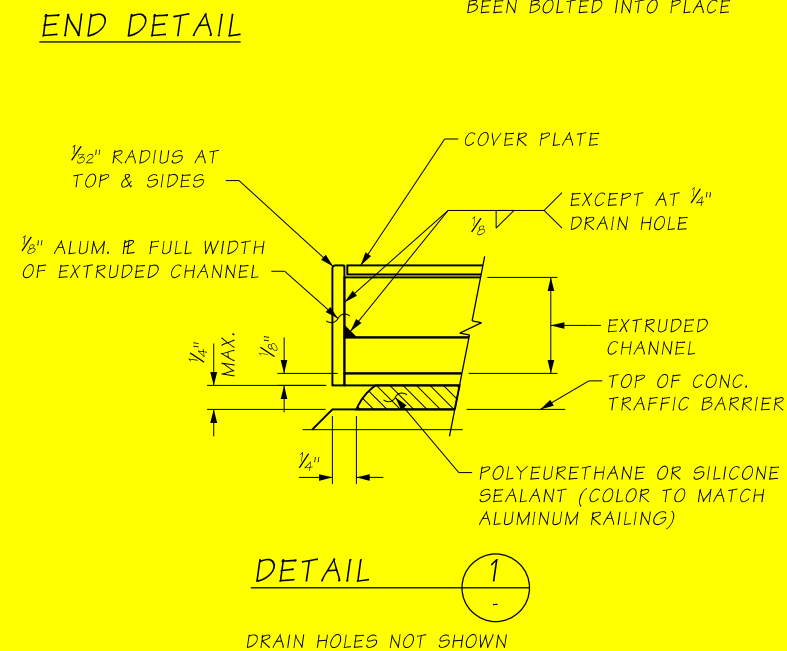


SECTION A  
OPTION 1

LOCATE ON OPPOSITE SIDE OF TRAFFIC. DRIVE PINS SHALL BE DRIVEN FLUSH WITH THE OUTSIDE FACE OF THE RAILING.

SECTION A  
OPTION 2

LOCATE ON OPPOSITE SIDE OF TRAFFIC. DRIVE PINS SHALL BE DRIVEN FLUSH WITH THE OUTSIDE FACE OF THE RAILING.

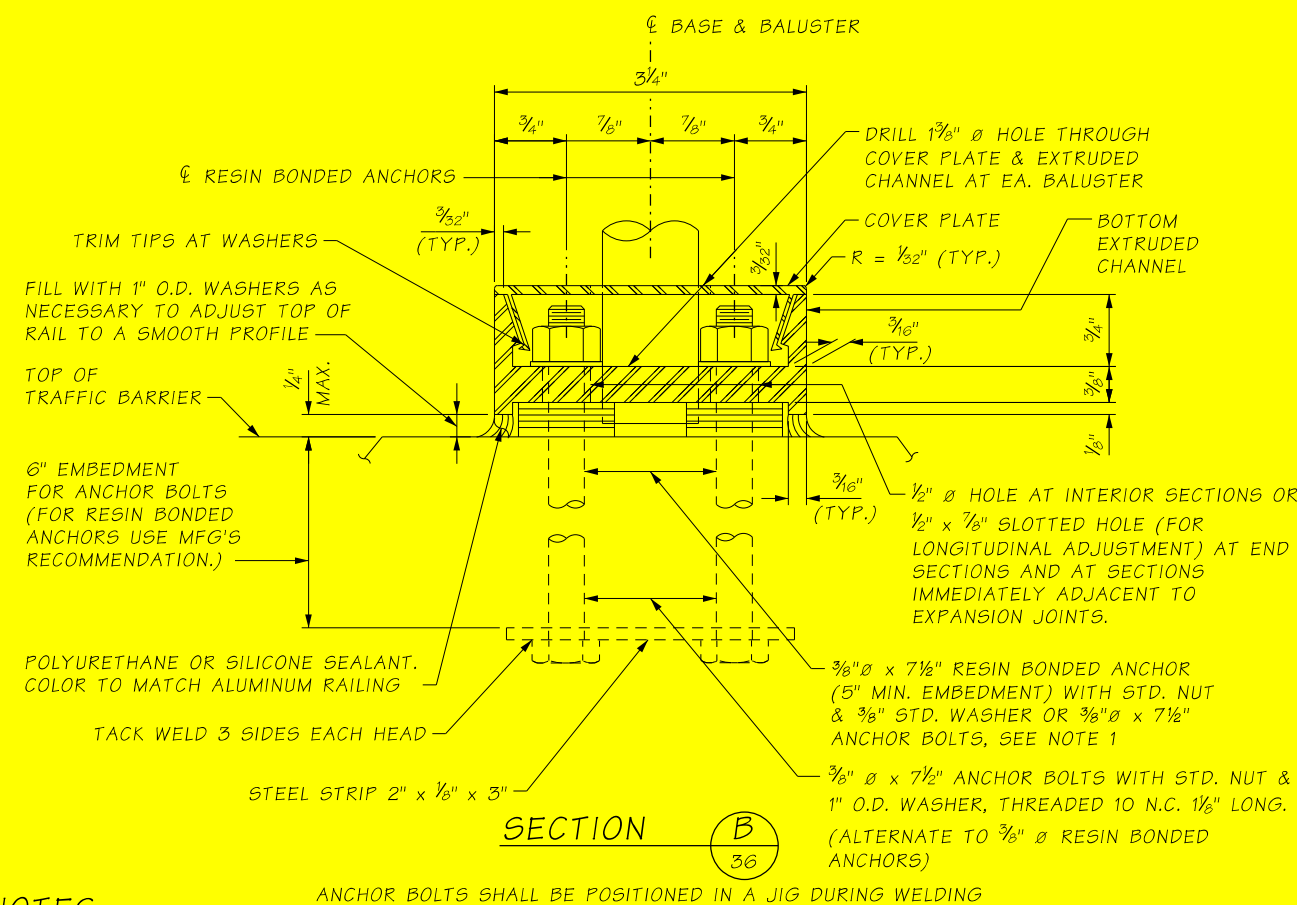

### NOTES:

- RESIN BONDED ANCHORS SHALL CONFORM TO SECTION 6-02.2.OPT1.GR6 OF THE GENERAL SPECIAL PROVISIONS IN APPENDIX B3 OF THE CONFORMED RFP.

c:\users\mkal\documents\projectwise\workingdir\wsdot\dms22941\XL5467_37_DE_BG_BR17.7-Railing2.dgn			
Design Mgr:	BRIAN BELL	RELEASE FOR CONSTRUCTION RECORD	
Designed By:	F.C. CAJAS	REGION NO.	STATE
Checked By:	M. BAUGHMAN	10	WASH.
Detailed By:	M. AASAL	JOB NUMBER	
Current Revision By:		XL5467	
Date:	12/20/2021	CONTRACT NO.	
Time:	11:38:38 AM	C9242	
DESCRIPTION		DATE	NO

FED. AID, PROJ. NO.	SHEET NO.	TOTAL SHEETS



DATE	DATE



I-405; RENTON TO BELLEVUE WIDENING AND EXPRESS TOLL LANES PROJECT	PLAN REF. NO. BG17.7-37
BRIDGE 405/17.7 - RENTON AVE OVER I-405	SHEET
BRIDGE RAILING TYPE BP-24 DETAILS 2 OF 2	OF SHEETS